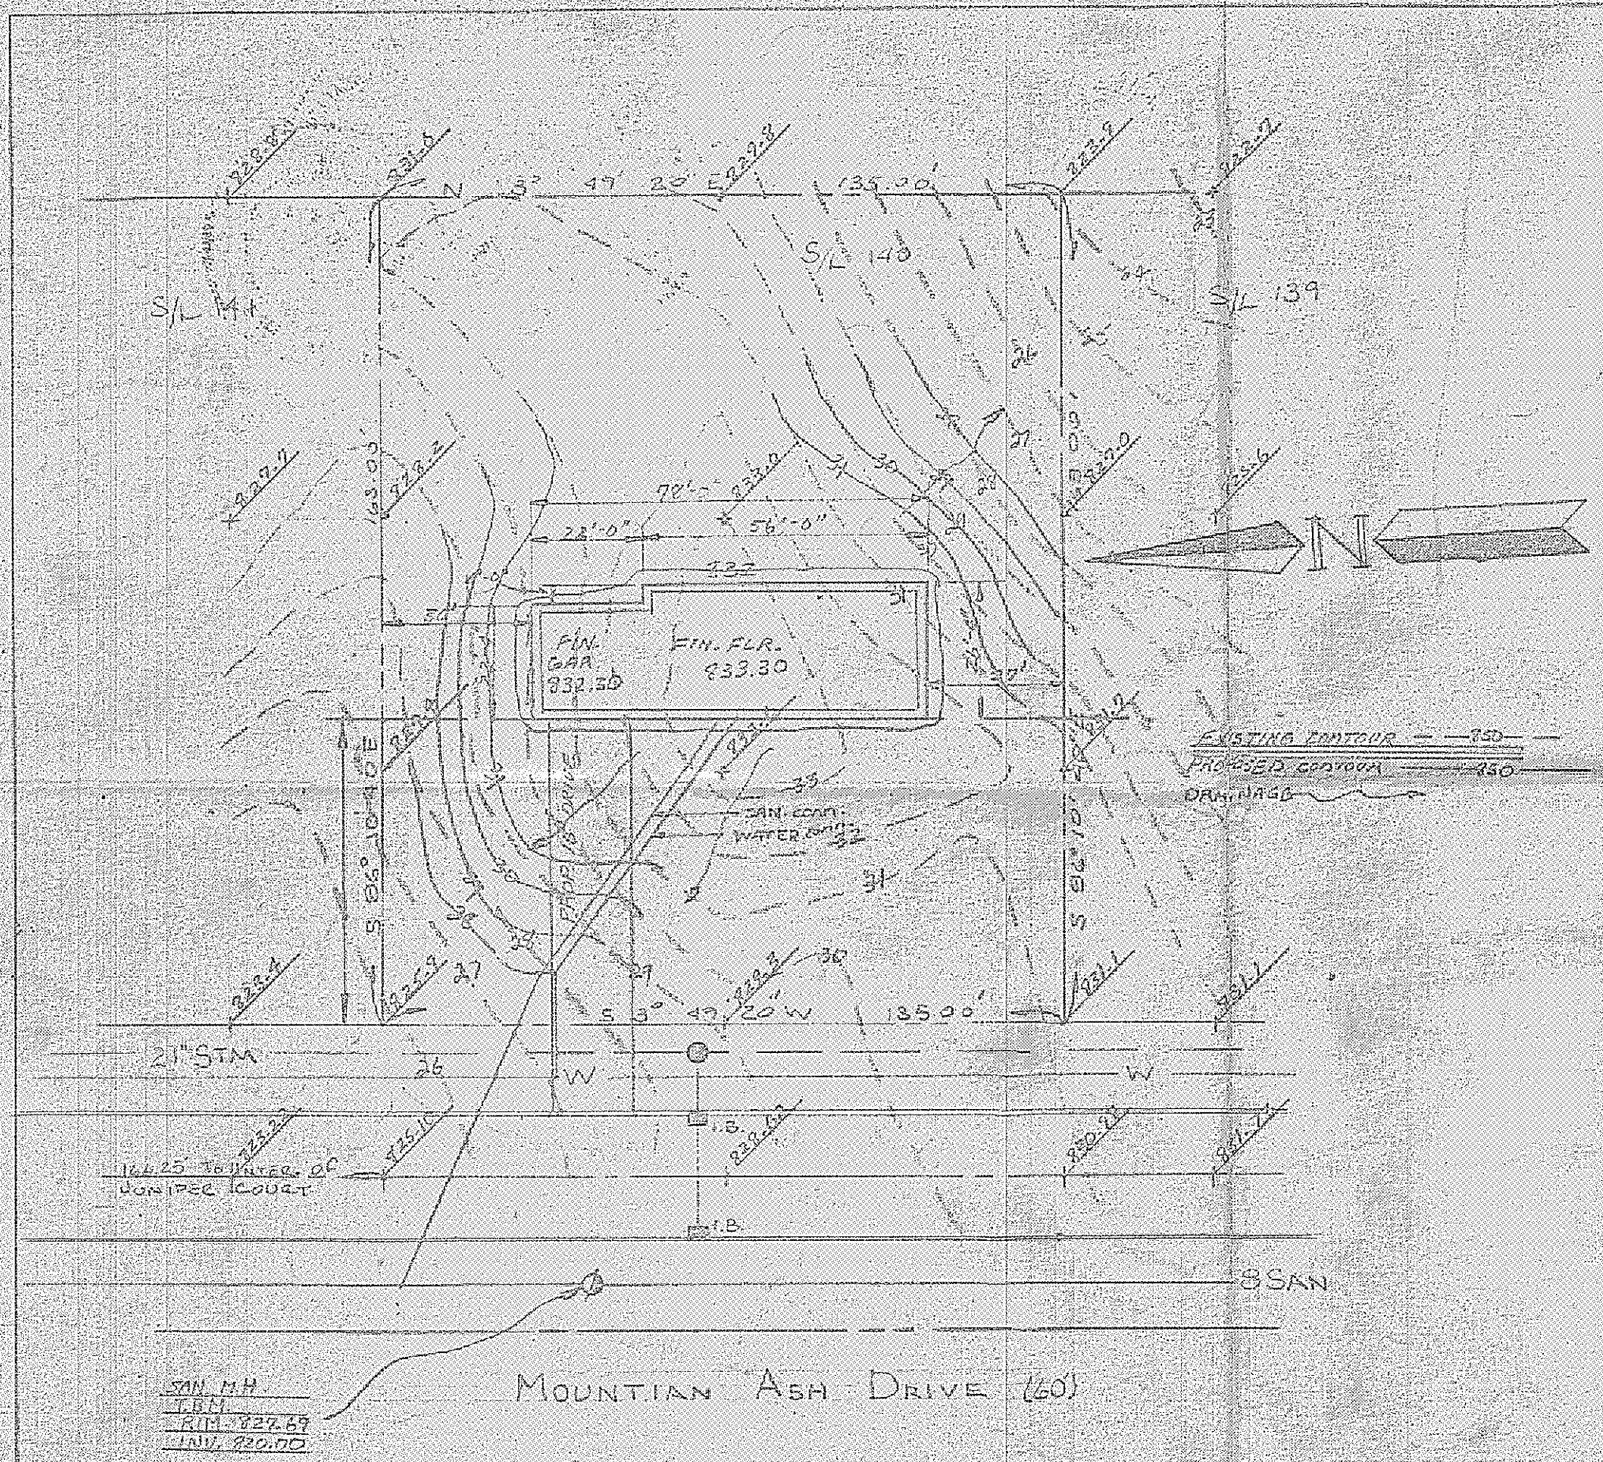

SITE PLAN:

SHANDLE CONSTRUCTION

8353 MENTOR AVE.
MENTOR, OHIO

BEING SUBLOT NO 140 IN
MORLEY HILLS ESTATES NO. 3
IN CONCORD TWP., OHIO

Grading Plan Approved
as shown and/or noted
THOMAS P. GILLES, P. E.
Lake County Engineer
By T.G. Date 11 APR 78

PREPARED BY:

WM. R. GRAY ASSOC. INC.

7547 MENTOR AVE.
MENTOR OHIO
SCALE: 1" = 30'
DATE: 3-30-78

1st Fl 1456 sq ft
2nd Fl 840 " "
Garage 484 " "

CERTIFICATION:

I HEREBY CERTIFY THAT THIS PLAT IS CORRECT TO THE BEST OF MY KNOWLEDGE

BY: Wm. R. Gray
WM. R. GRAY REG. SURV. #2752

ZONING PERMIT #3565

ISSUED 4-7-78

STATE OF OHIO
WM. R. GRAY
2752
REGISTERED
PROFESSIONAL SURVEYOR

SUBJECT TO APPROVAL BY:
Lake County Sanitary Eng. ☐
Lake County Eng. Dept. ☒
Lake County Planning Comm. ☐
Lake County Bldg. Dept. ☒

H. E. van Ernst
F.B. 80-35
DATE 1-17-78