LEGEND

XXX.XX EXIST. ELEV.
XXX.XX PROP. ELEV.

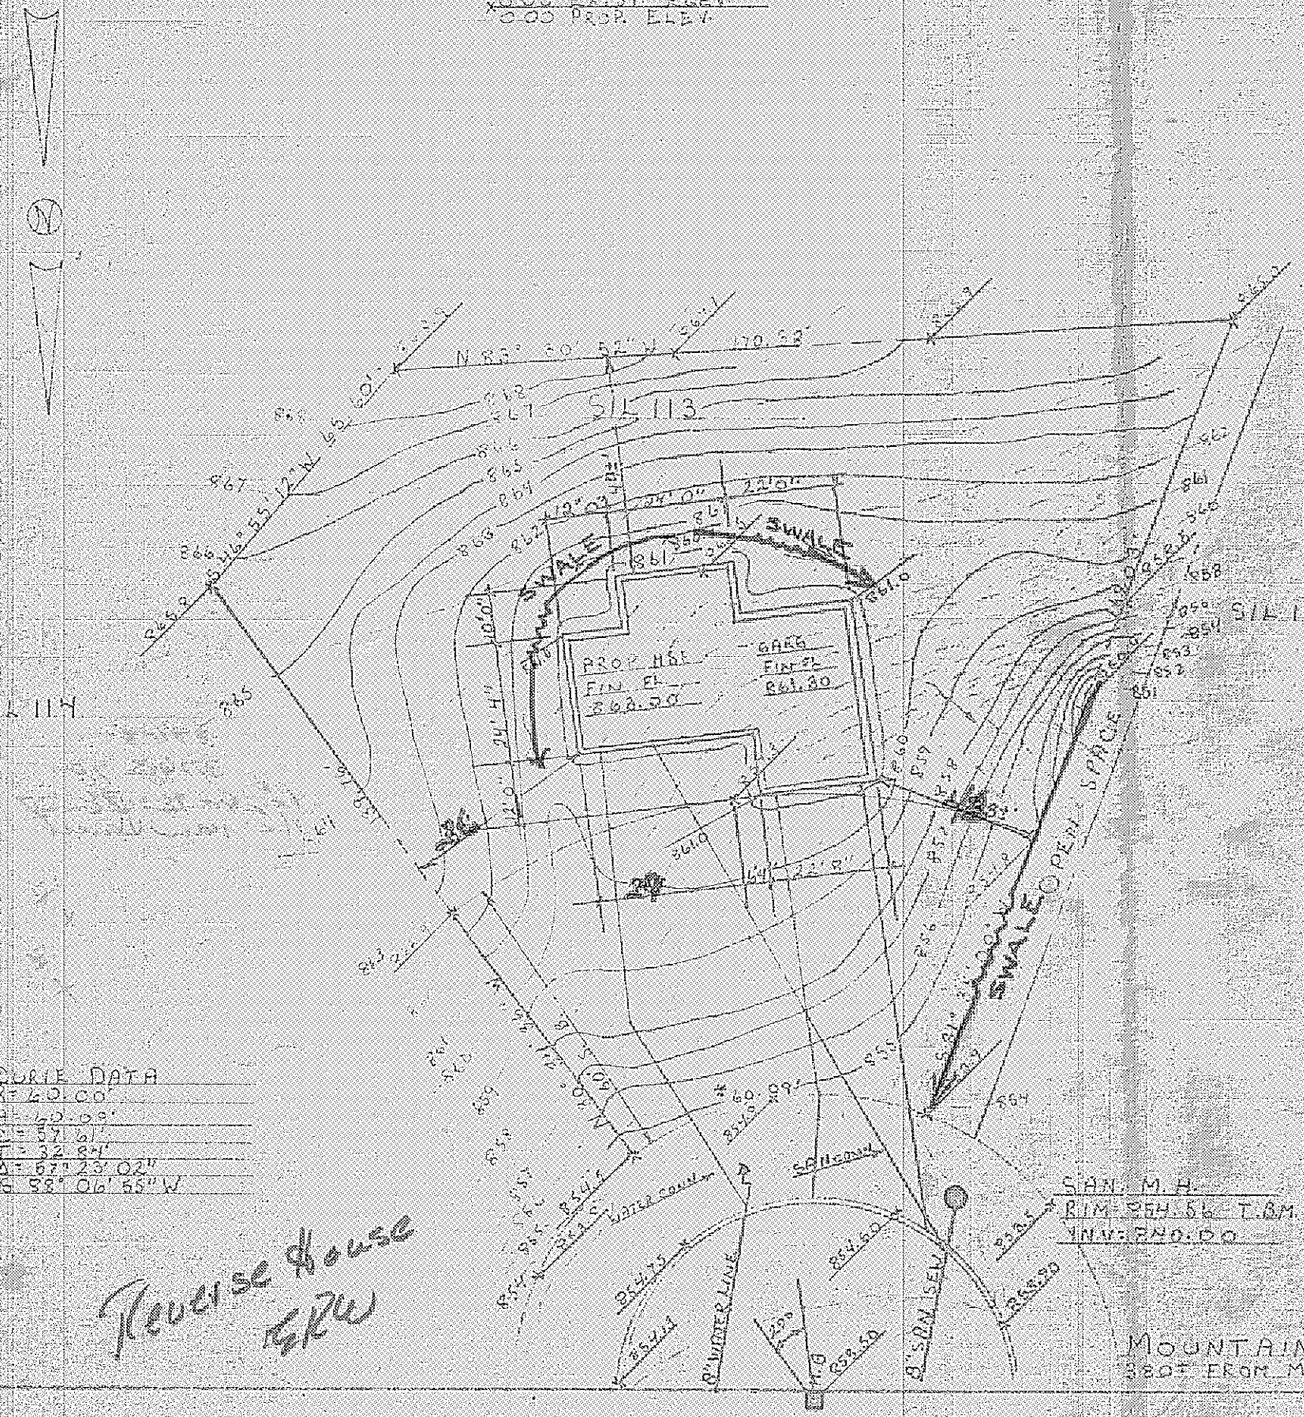

*CURVE DATA
R = 60.00'
D = 57.61'
T = 32.84'
A = 61° 23' 02"
S 58° 06' 55" W

Revise House
KRW

SITE PLAN FOR:
SHANDLE CONSTRUCTION
8853 MENTOR AVE
MENTOR, OHIO
BEING SUBLOT 113 IN THE
MORLEY HILLS ESTATES SUBDIVISION
IN CONCORD TWP., OHIO.

PREPARED BY:
WM. R. GRAY ASSOC. INC.
7547 MENTOR AVE
MENTOR, OHIO

SCALE: 1" = 30'
DATE: SEPT. 11, 1978

Grading Plan Approved as shown and/or noted
THOMAS P. GILLES, P.E.
Lake County Engineer
By DAC Date 9-27-78

ZONING PERMIT
3763
ISSUED 9-18-78
R.E. van Ornum
SUBJECT TO APPROVAL BY:
Lake County Sanitary Eng. ☐
Lake County Eng. Dept. ☒
Lake County Planning Comm. ☐
Lake County Bldg. Dept. ☒

STATE OF OHIO
WM. R. GRAY
2752
REGISTERED
PROFESSIONAL SURVEYOR

CERTIFICATION:
I HEREBY CERTIFY THAT
THIS PLAT IS CORRECT TO
THE BEST OF MY KNOWLEDGE.
BY: Wm. R. Gray
WM. R. GRAY REG. SURV. #2752