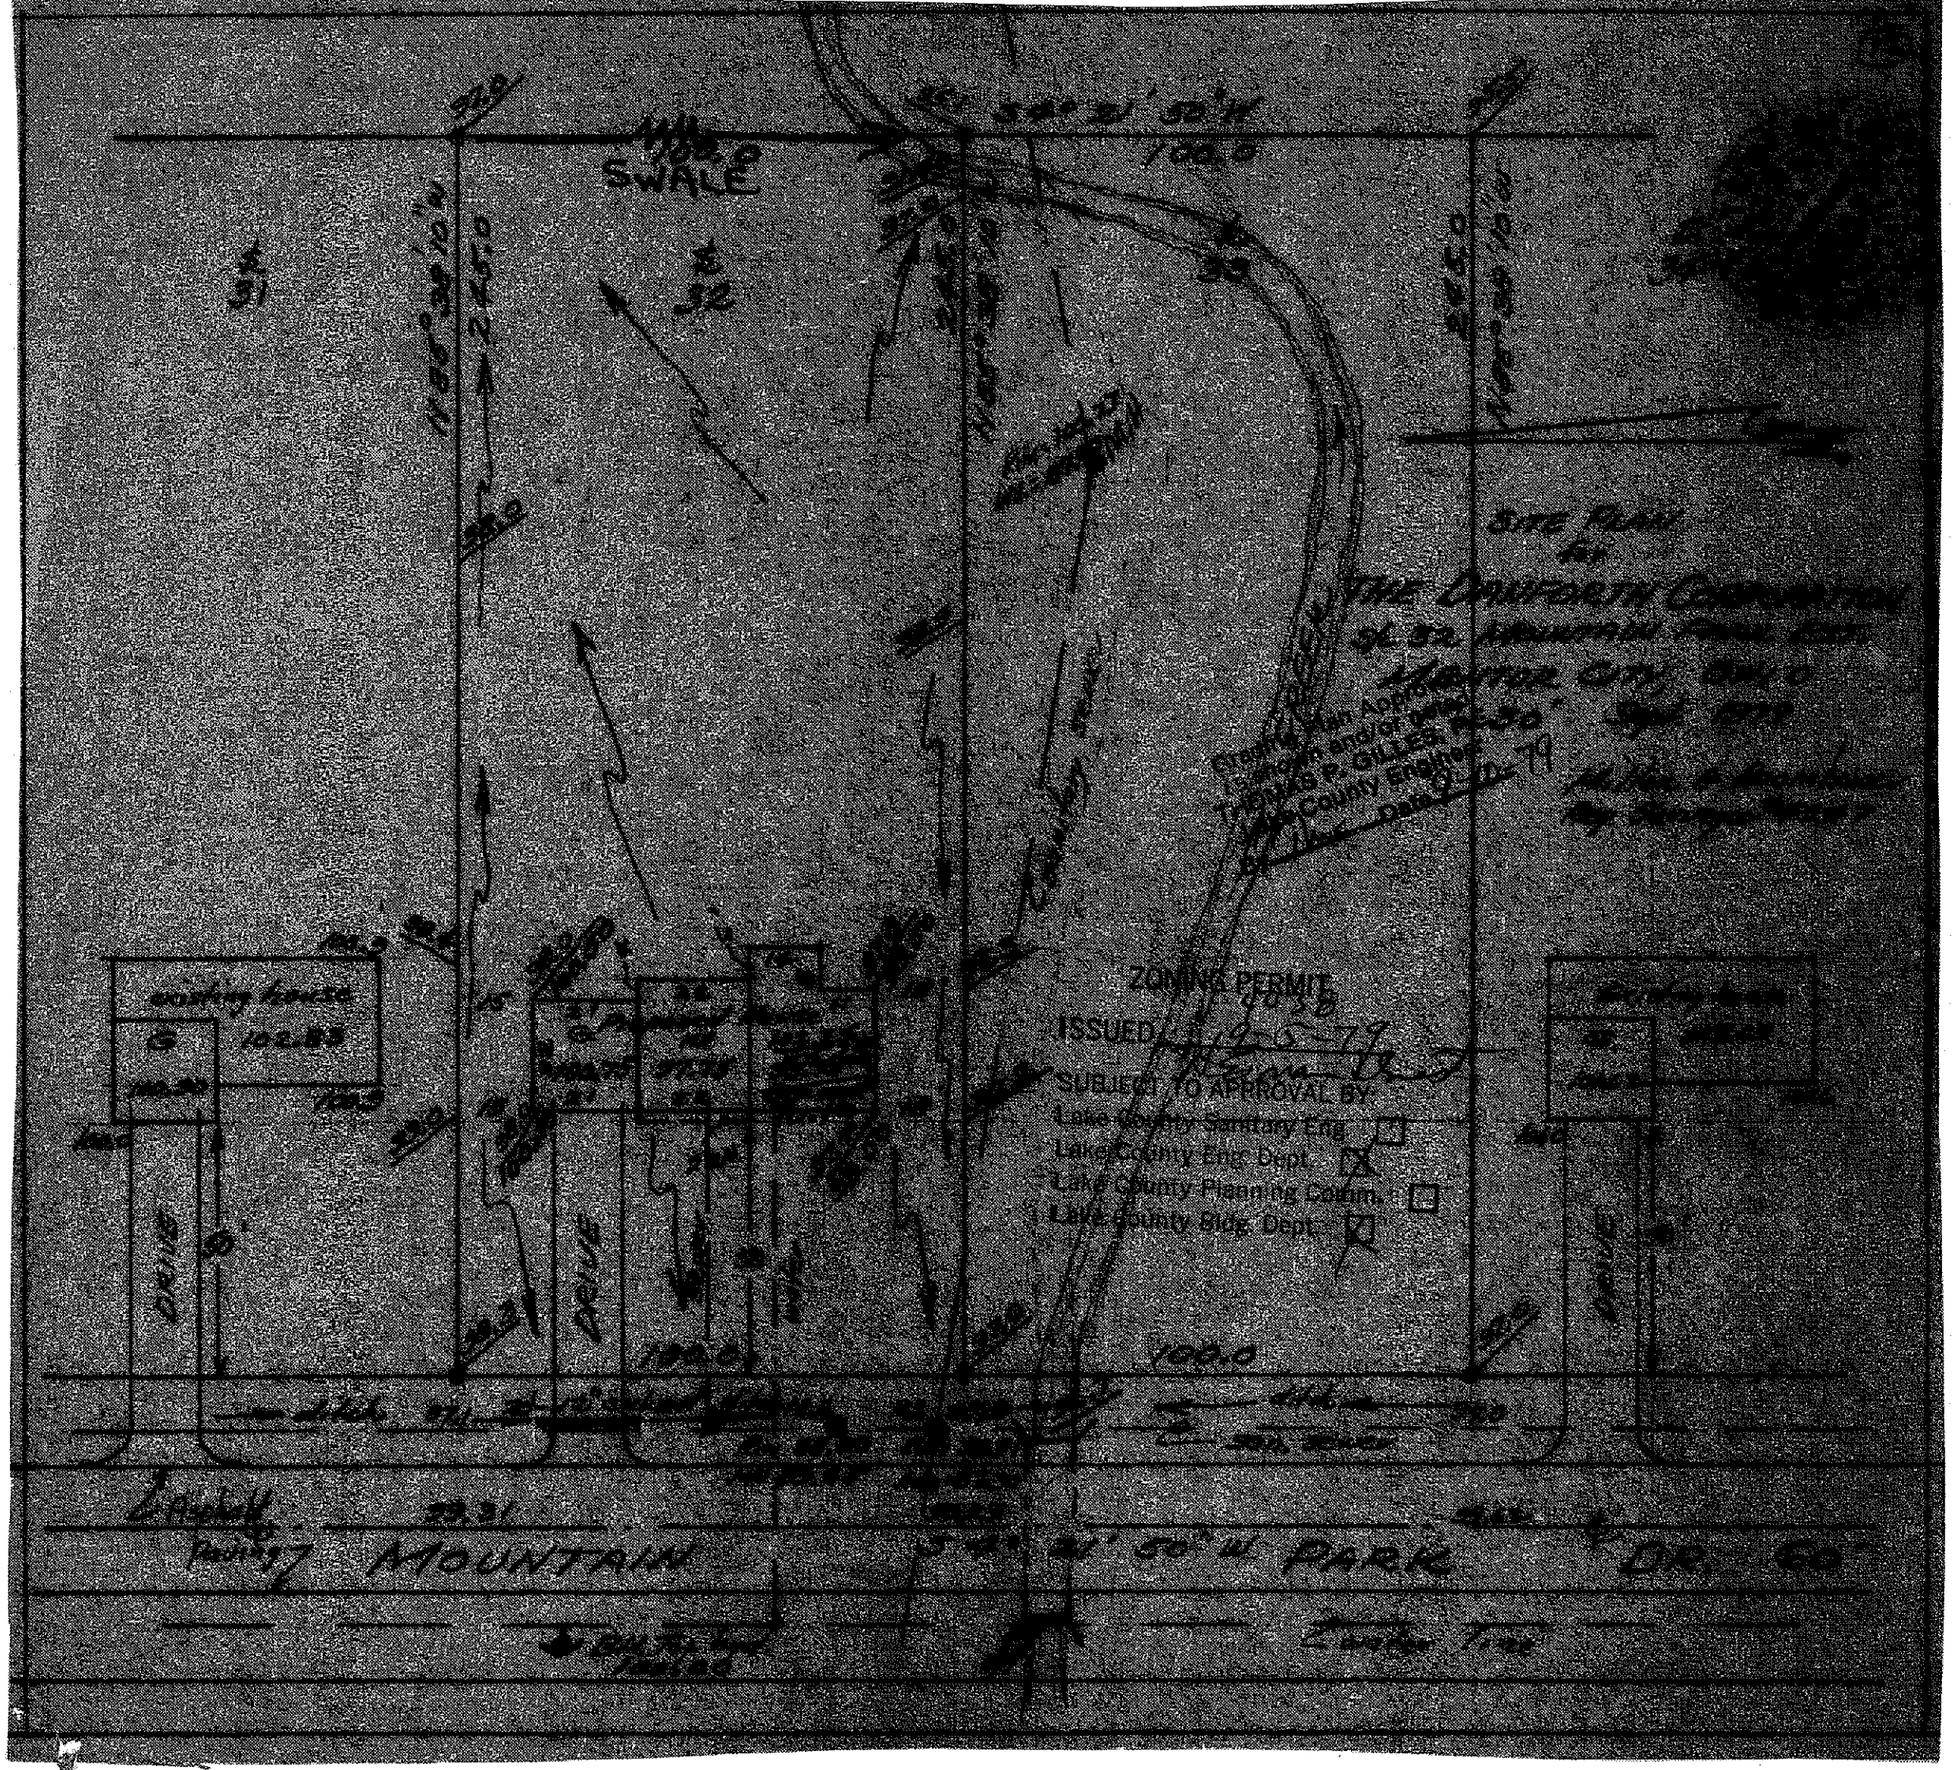
SWALE
SITE PLAN
FOR
ZONING PERMIT
ISSUED
SUBJECT TO APPROVAL BY:
Lake County Sanitary Eng.
Lake County Eng. Dept.
Lake County Planning Comm.
Lake County Bldg. Dept.
DRIVE
MOUNTAIN
PARK
DR.