Reviewed and Accepted
LAKE COUNTY GENERAL HEALTH DISTRICT
Date 7-1-94
JOEL LUCIA, R.S., M.P.H.
Health Commissioner
By Gerald B Morris

SEWAGE DISPOSAL PERMIT MUST BE OBTAINED BY A LAKE COUNTY LICENSED INSTALLER BEFORE INSTALLATION IS STARTED.

A. To be brought to finished grade
1. Septic tank manhole covers
2. Splitter box cover
3. Distribution box cover
B. Fix heavy drains to downspouts
C. Fill abandoned cesspools
D. All waste water to be discharged into septic tanks

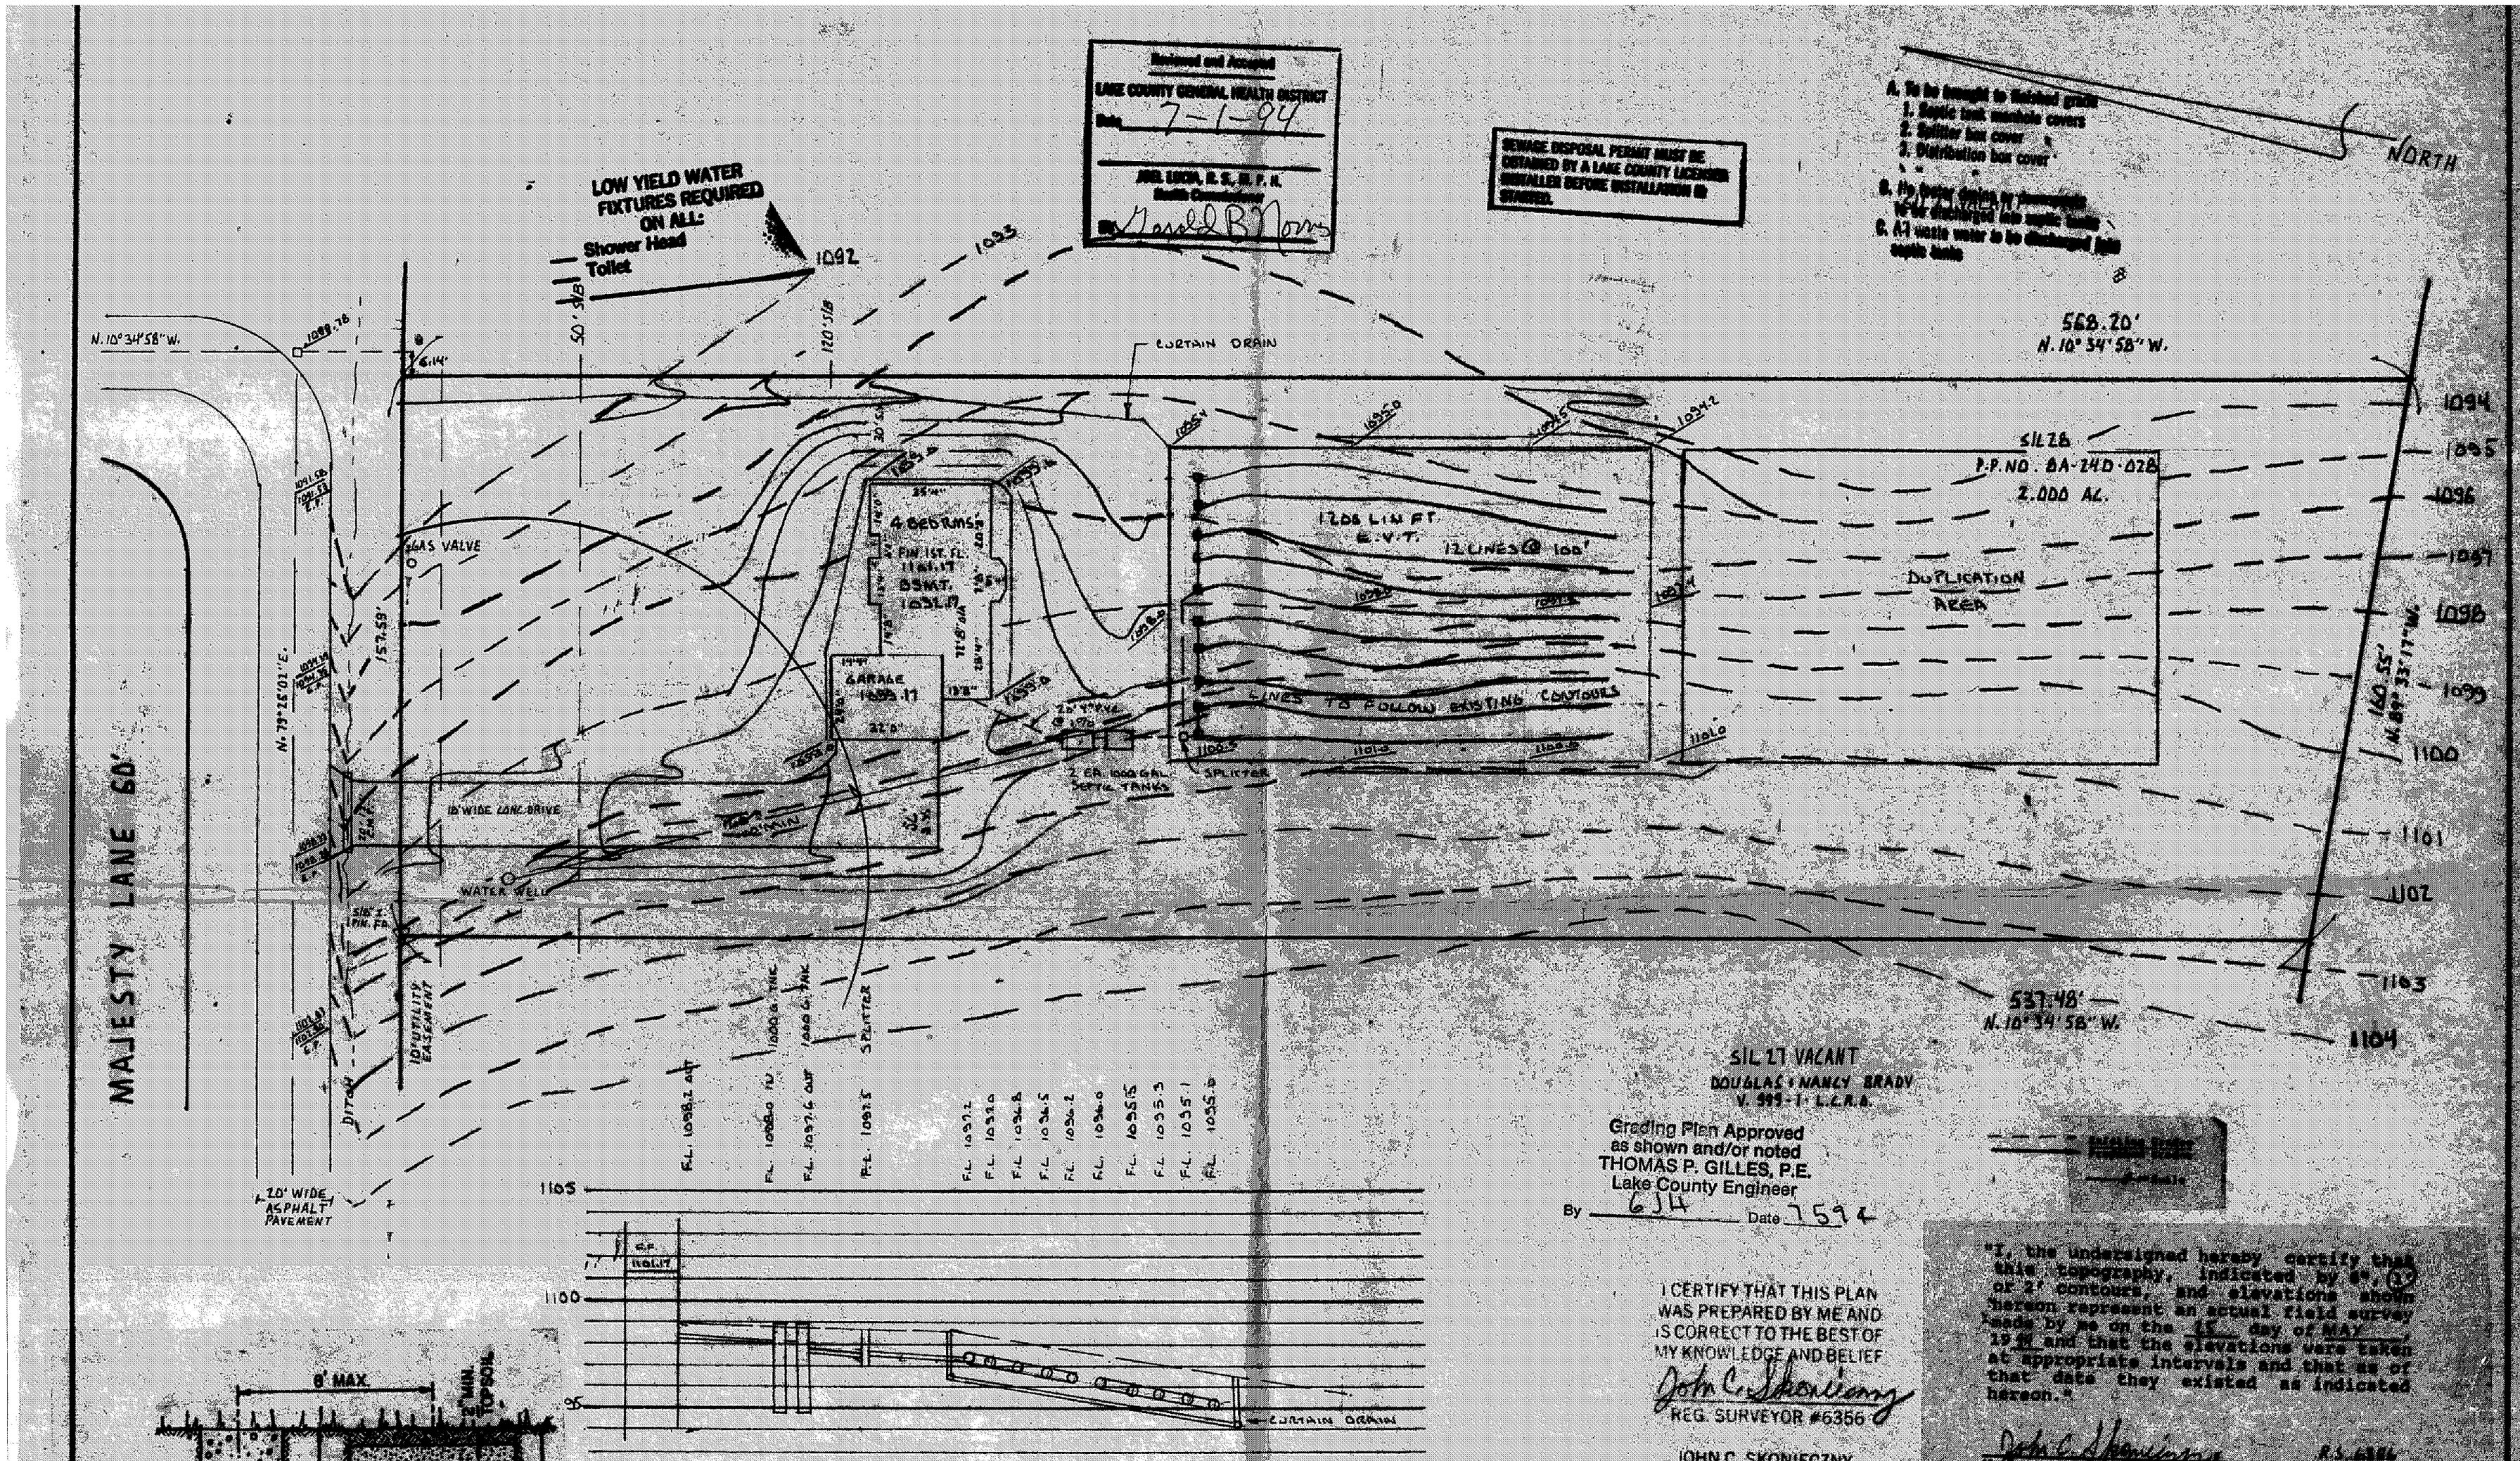

Grading Plan Approved
as shown and/or noted
THOMAS P. GILLES, P.E.
Lake County Engineer
By GJH Date 7-5-94

I CERTIFY THAT THIS PLAN WAS PREPARED BY ME AND IS CORRECT TO THE BEST OF MY KNOWLEDGE AND BELIEF.
John C. Skonieczny
REG. SURVEYOR #6356

JOHN C. SKONIECZNY
7739 VIEWMOUNT DR.
PAINESVILLE, OHIO 44077
PH. 352-7742

"I, the undersigned hereby certify that this topography, indicated by 5', 1' or 2' contours, and elevations shown thereon represent an actual field survey made by me on the 15 day of MAY, 19 94 and that the elevations were taken at appropriate intervals and that as of that date they existed as indicated hereon."

John C. Skonieczny — Name — 6356 — Reg. No

REVISIONS
jcs 1 JUL-29-94 SHW. CURT. DR., ELV SHTS SDGRD. WELL ISOL. #B.R. CUR 100'

APPROVED
APPROVED AS NOTED
SUBJECT TO LAKE COUNTY HEALTH DEPARTMENT REVIEW.
JOSEPH GUTOSKEY, P.E.

ZONING PERMIT #0694-7873
ISSUED 6-30-94
SUBJECT TO APPROVAL BY:
Lake County Sanitary Eng. ☐
Lake County Eng. Dept. ☑
Lake County Planning Comm. ☐
Lake County Bldg. Dept. ☑

STATE OF OHIO — JOHN CLOUD SKONIECZNY — S-6356 — REGISTERED SURVEYOR

SITE PLAN FOR: [redacted]

SCALE: 1" = 30' | APPROVED BY | DRAWN BY: KTS
DATE: MAY-94

BEING SUBLOT 2B IN THE MOUNT ROYAL NO. 2 SUBDIVISION
TOWNSHIP OF CONCORD · COUNTY OF LAKE · STATE OF OHIO

JOB # 94-1868 | DRAWING NUMBER 94-1872