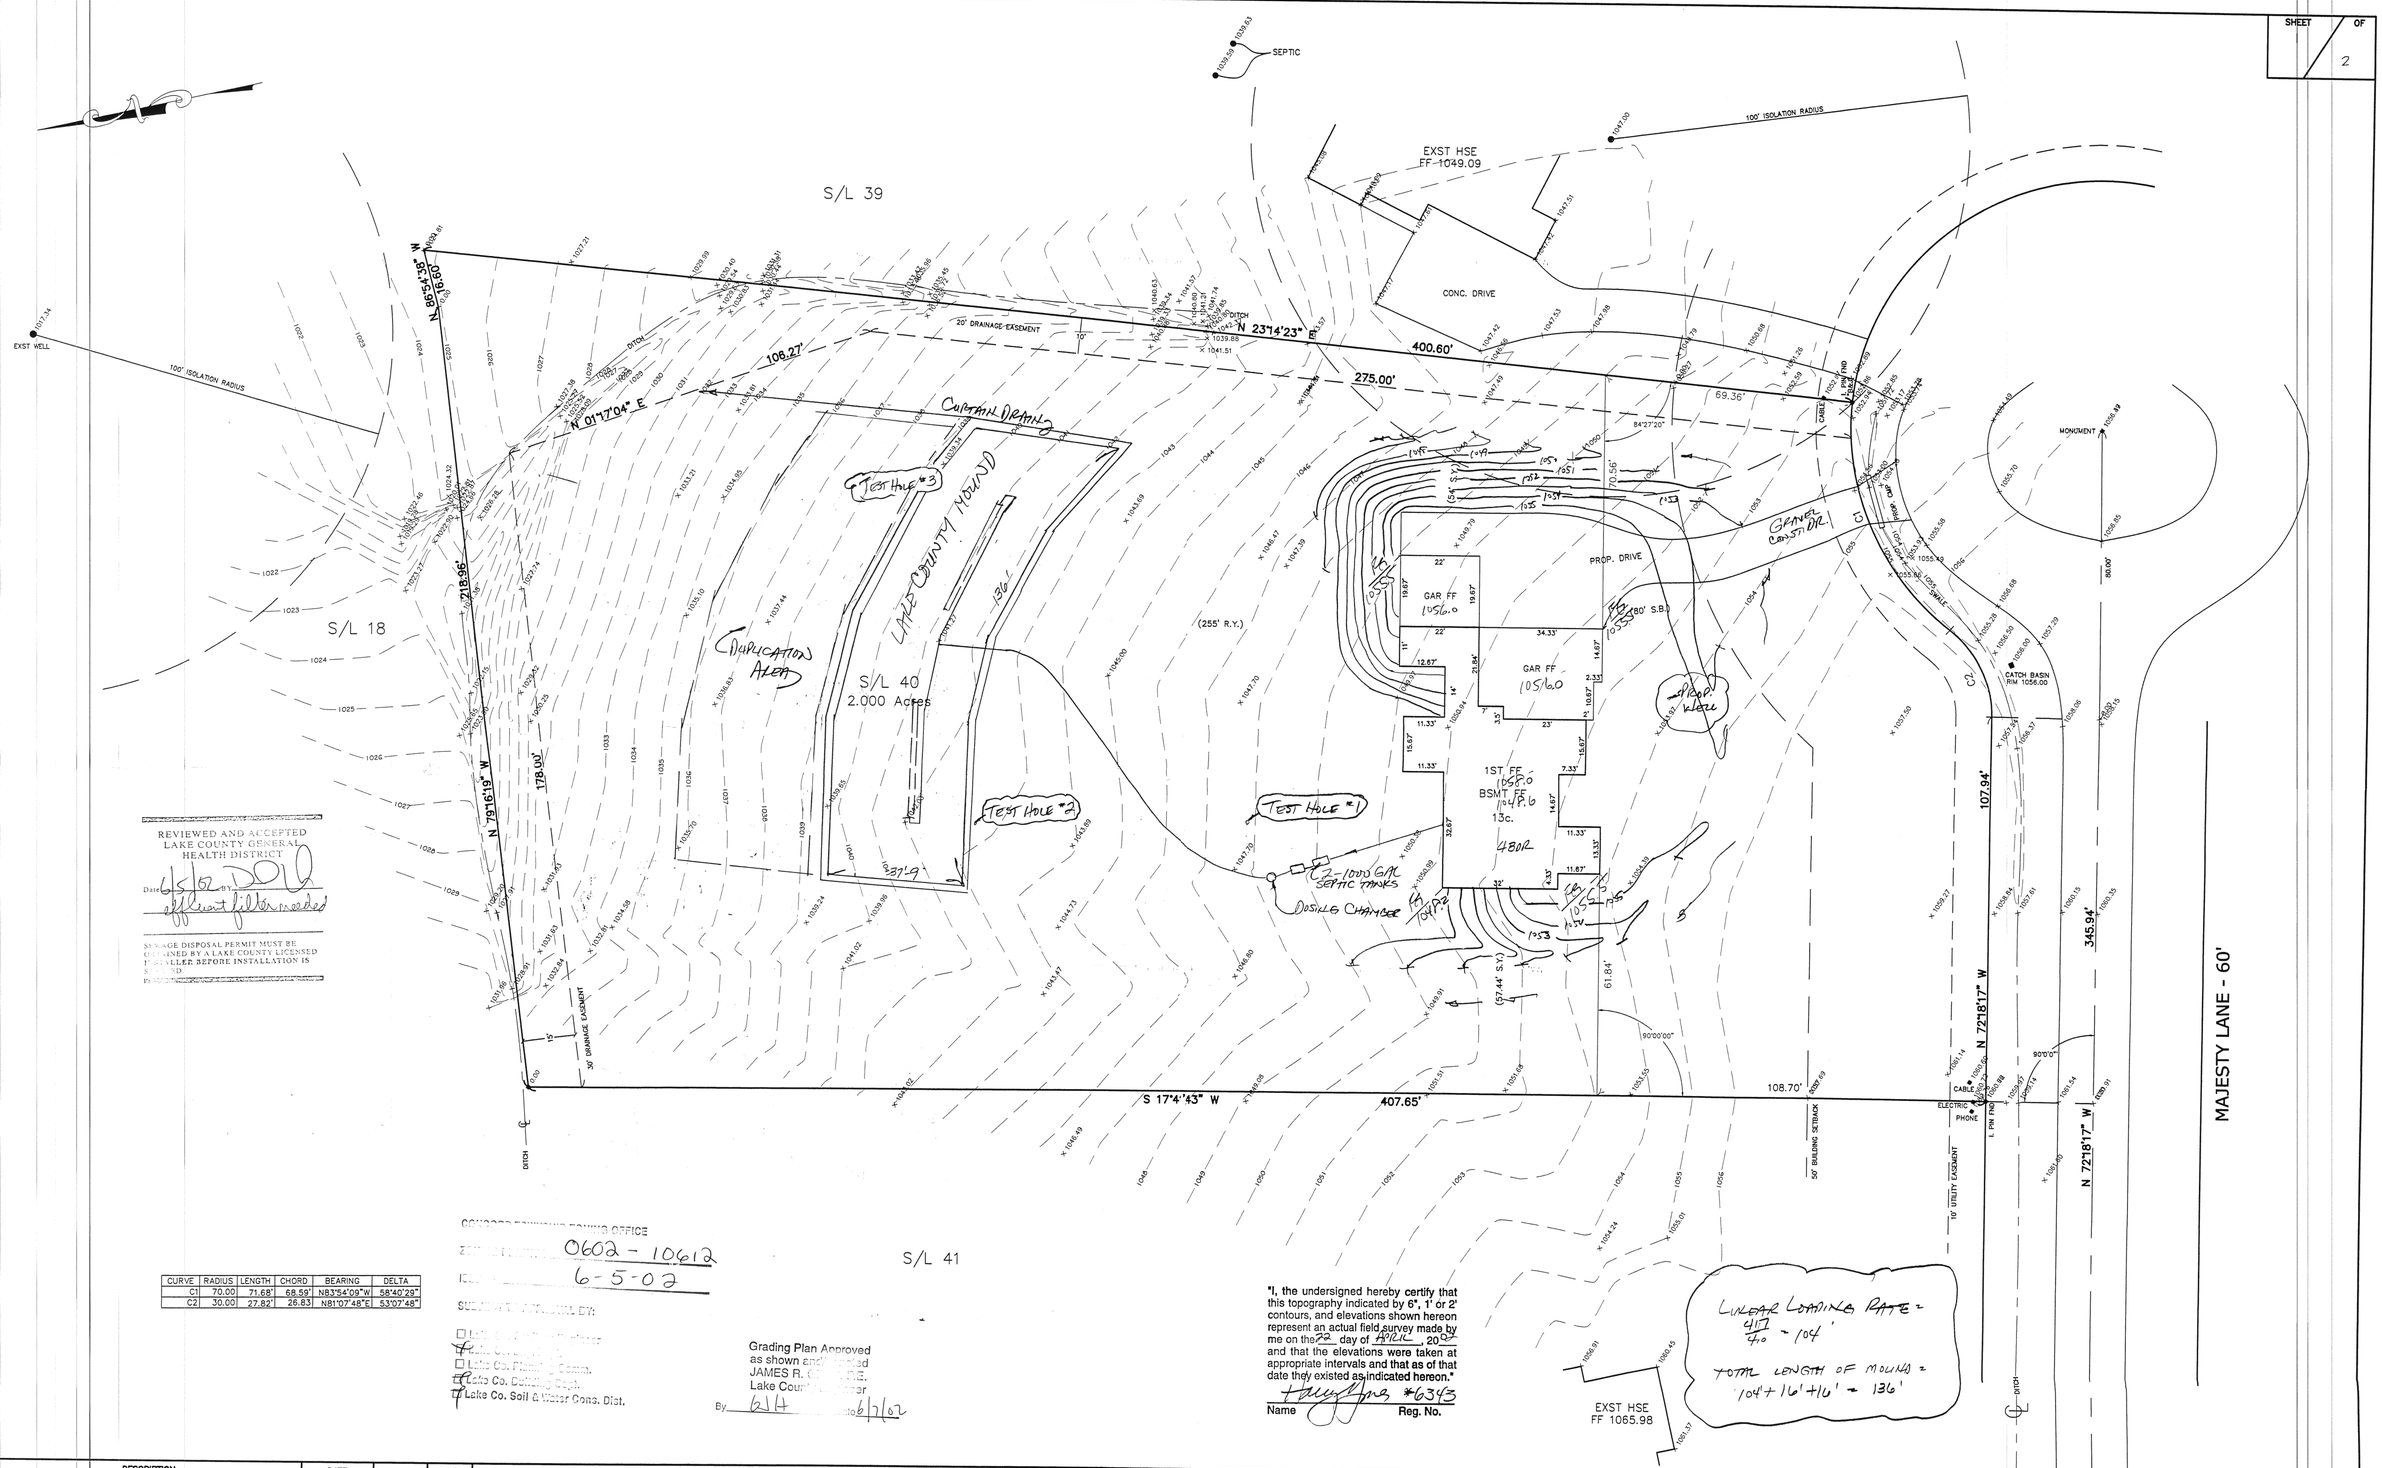

REVIEWED AND ACCEPTED
LAKE COUNTY GENERAL
HEALTH DISTRICT
Date 6/5/02 BY DOH
effluent filter needed

SEWAGE DISPOSAL PERMIT MUST BE OBTAINED BY A LAKE COUNTY LICENSED INSTALLER BEFORE INSTALLATION IS STARTED.

CONCORD TOWNSHIP ZONING OFFICE
ZONING PERMIT 0602 - 10612
ISSUED 6-5-02
SUBJECT TO APPROVAL BY:
☐ Lake Co. Soil & Water Engineer
☑ Lake Co. Engineer
☐ Lake Co. Planning Comm.
☑ Lake Co. Building Dept.
☑ Lake Co. Soil & Water Cons. Dist.

CURVE	RADIUS	LENGTH	CHORD	BEARING	DELTA
C1	70.00	71.68'	68.59'	N83°54'09"W	58°40'29"
C2	30.00	27.82'	26.83	N81°07'48"E	53°07'48"

Grading Plan Approved as shown and [illegible] JAMES R. [illegible] P.E. Lake County Engineer
By GJH Date 6/7/02

"I, the undersigned hereby certify that this topography indicated by 6", 1' or 2' contours, and elevations shown hereon represent an actual field survey made by me on the 22 day of APRIL, 2002 and that the elevations were taken at appropriate intervals and that as of that date they existed as indicated hereon."
Name [signature] Reg. No. #6343

REV NO.	DESCRIPTION	DATE	BY	CHK'D
1	REVISED MOUND LENGTH	5-10-02	AJ	[illegible]
2	REVISIONS PER L.C. HEALTH DEPT	6-3-02	AJ	[illegible]

BABCOCK, JONES AND ASSOCIATES, INC
CIVIL ENGINEERS – SURVEYORS – LAND PLANNERS
PAINESVILLE OHIO 44077

DATE	4/29/02
DESIGN BY	B.P.
DRAWN BY	H.J.
APPROVED BY	H.J.

SITE PLAN
FOR
STADEN
S/L 40 MAJESTY LANE, MOUNT ROYAL SUBDIVISION
CONCORD TOWNSHIP LAKE COUNTY STATE OF OHIO

SCALE	1"=20'
JOB NO	93-163-40
SHEET	1 OF 2