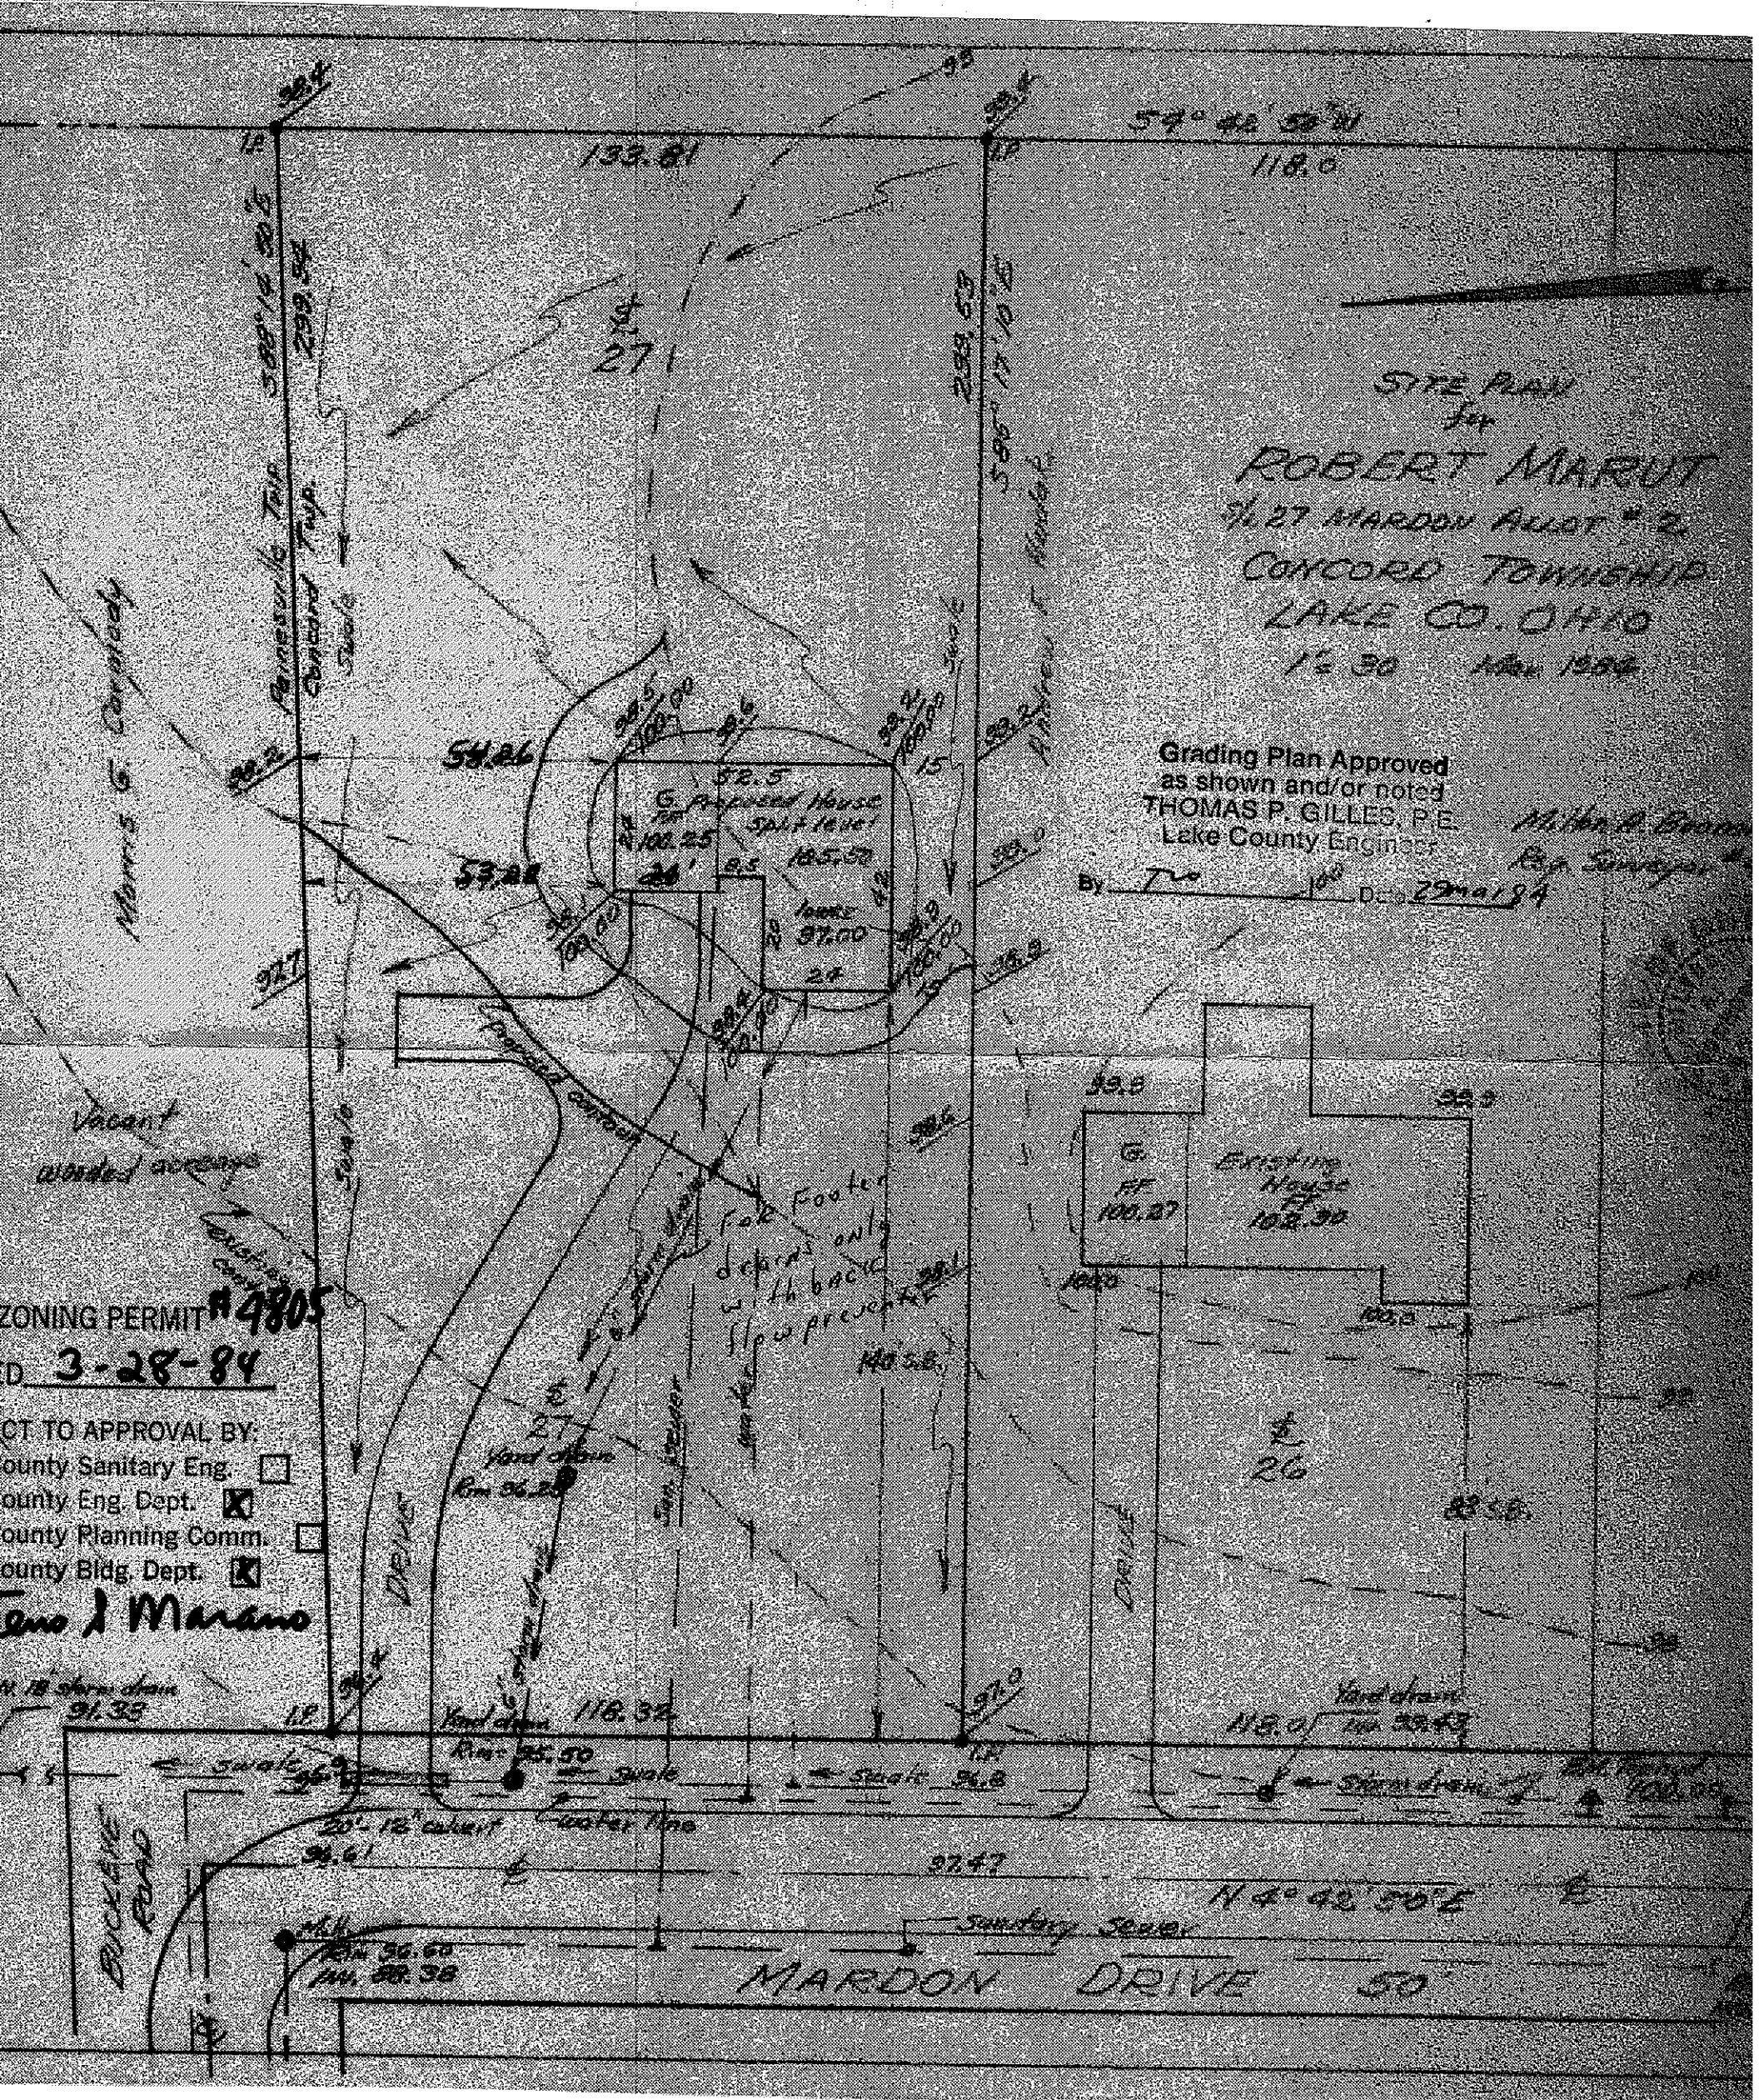
SITE PLAN
for
ROBERT MARUT
S/L 27 MARDON ALLOT # 2
CONCORD TOWNSHIP
LAKE CO. OHIO
1" = 30 Mar 1984
Grading Plan Approved
as shown and/or noted
THOMAS P. GILLES, P.E.
Lake County Engineer
By
Date 29 mar 84
ZONING PERMIT #4805
ED 3-28-84
CT TO APPROVAL BY:
ounty Sanitary Eng.
ounty Eng. Dept.
ounty Planning Comm.
ounty Bldg. Dept.
Morris G. Carmody
Painesville Twp.
Concord Twp.
Andrew F. Kindak
Vacant
wooded acreage
Existing Contour
Proposed contour
G. Proposed House
Split level
Existing House
Yard drain
Rim 96.25
Rim 95.50
Rim 96.60
Inv. 88.38
20'-12" culvert
water line
Sanitary Sewer
MARDON DRIVE 50'
BUCKEYE ROAD
N 4° 42' 50" E
Swale
Storm drain
Yard drain
Inv. 93.43
Rim 96.8
Rim 96.60
Inv. 88.38
Rim 96.25
Rim 95.50
Rim 96.60
Inv. 88.38
Existing House
FF 100.27
FF 102.30
Proposed contour
For Footer drains only with back flow preventer
Milton A. Boone
Reg. Surveyor