CLEARLAKE DRIVE

#6518

ZONING PERMIT
ISSUED 7-3-90

SUBJECT TO APPROVAL BY:
Lake County Sanitary Eng. ☐
Lake County Eng. Dept. ☒
Lake County Planning Comm. ☐
Lake County Bldg. Dept. ☒

Pino S. Marano

MORLEY ROAD 60'
EXIST 8" WATER MAIN
20' ASPHALT PAVEMENT

STATE ROUTE 44

① R = 140.00 Δ = 67-02-26 A = 163.81 T = 92.74 C = 154.63 N43-24-20W

② R = 110.00 Δ = 60-00-53 A = 115.22 T = 63.53 C = 110.02 N47-06-52W

N 14 - 14' - 43" E 28.77

20.00

10.00

62.75

30' INGRESS/EGRESS AND UTILITY EASEMENT (0.0962 AC.)

COMMON DRIVEWAY BY OTHERS NOT A PART OF THIS PLAN (CURRENTLY UNDER CONSTRUCTION)

IRON PIN FD. & USED ②

BENCHMARK
TOP OF IRON PIN
ELEVATION 100.00
U. 75-02-01.5 W. 95.34

33.83

N 75 - 45' - 17" W 435.58

1.1872 ACRES

PROPOSED DRIVE

CURTAIN DRAIN OUTLET

50 LF - 4" DISTRIBUTION LINE (600 LIN FT. TOTAL)

CURTAIN DRAIN & SWALE

DISTRIBUTION LINES TO BE SET AT A LEVEL GRADE FROM DROP BOX OUTLET

952.96' S.B.

1.9049 ACRES

FOOTER DRAIN OUTLET SUMP PUMP REQUIRED

1067.84' S.B.

1045.45' S.B.

1327.84' WATER CONNECTION

3 - BEDROOM
FIRST FLR. EL. 138.50
BASEMENT EL. 129.83

GARAGE EL. 136.50

SYSTEM DUPLICATION AREA

33 LF - 4" @ 1.00%

4" DIA. UPFLOW FILTER DISCHARGE LINE, POSITIVE DISCHARGE REQUIRED

544' S.B.

645.9' S.B.

N 52 - 19' - 04" W 432.97

2.667 ACRES

IRON PIN FD. & USED

N 02 - 09' - 32" W 154.85

N 81 - 53' - 29" E 190.50

IRON PIN FD. & USED

IRON PIPE FD. & USED

SPLITTER BOX
T/CTG. 132.50
INLET 131.80
OUTLET 131.50

JET MODEL J-53 W/ UPFLOW FILTER & AUTOMATIC BACKWASH
T/CTG. 134.50
INLET 132.42
OUTLET 131.6

LOW YIELD WATER FIXTURES REQUIRED ON ALL:
— Shower Head
— Toilet
— —

TOPOGRAPHIC SURVEY
& SITE IMPROVEMENT PLAN
MADE FOR

MR. & MRS. DEAN ULSENHEIMER

KNOWN AS BEING PART OF ORIGINAL CONCORD TOWNSHIP LOT NO. 42 TRACT 4. NOW IN.....
CONCORD TOWNSHIP, LAKE COUNTY, OHIO
SCALE: 1" = 30'
JUNE 1990
REV. 6/28/90

THIS IS TO CERTIFY THAT AT THE REQUEST OF THE OWNER I HAVE SURVEYED AND PLATTED THE PARCEL AS SHOWN HEREON AND CONTAINING 1.9036 ACRES OF LAND. MONUMENTS WERE FOUND OR SET AS INDICATED HEREON. DIMENSIONS ARE EXPRESSED IN FEET AND DECIMAL PARTS THEREOF. BEARINGS SHOWN ARE TO AN ASSUMED MERIDIAN AND ARE FOR THE SOLE PURPOSE OF DESCRIBING THE RELATIVE ANGULAR VALUE BETWEEN LINES. TOPOGRAPHY SHOWN HEREON, INDICATED BY ONE FOOT CONTOURS AND ELEVATIONS, REPRESENT THE ACTUAL OBSERVED SITE GRADES AS OF 05-30-1990. ALL OF WHICH I CERTIFY TO BE CORRECT TO THE BEST OF MY KNOWLEDGE AND BELIEF.

S. J. LESSMAN
LAND SURVEYING & PLANNING
5400 VANDEMARK ROAD
MEDINA, OHIO 44256
PHONE: (216) 425-7833

STATE OF OHIO
S. J. LESSMAN
7078
REGISTERED SURVEYOR

STEVEN J. LESSMAN, OHIO PROFESSIONAL SURVEYOR NO. 7078

Reviewed and Accepted
LAKE COUNTY GENERAL HEALTH DISTRICT
Date 7-2-90
JOEL LUCIA, R. S., M. P. H.
Health Commissioner
By Gerald B Morris

SEWAGE DISPOSAL PERMIT MUST BE OBTAINED BY A LAKE COUNTY LICENSED INSTALLER BEFORE INSTALLATION IS STARTED.

A. To be brought to finished grade
1. Septic tank manhole covers
2. Splitter box cover
3. Distribution box cover
B. No footer drains or downspouts to be discharged into septic tanks
C. All waste water to be discharged into septic tanks

Grading Plan Approved as shown and/or noted
THOMAS P. GILLES, P.E.
Lake County Engineer
By GJH Date 7/5/90

1. RELOCATE CURTAIN DRAIN OUTLET AS SHOWN.
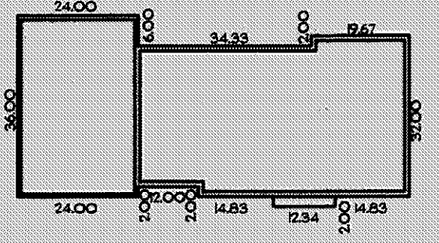
FOUNDATION DIMENSIONS