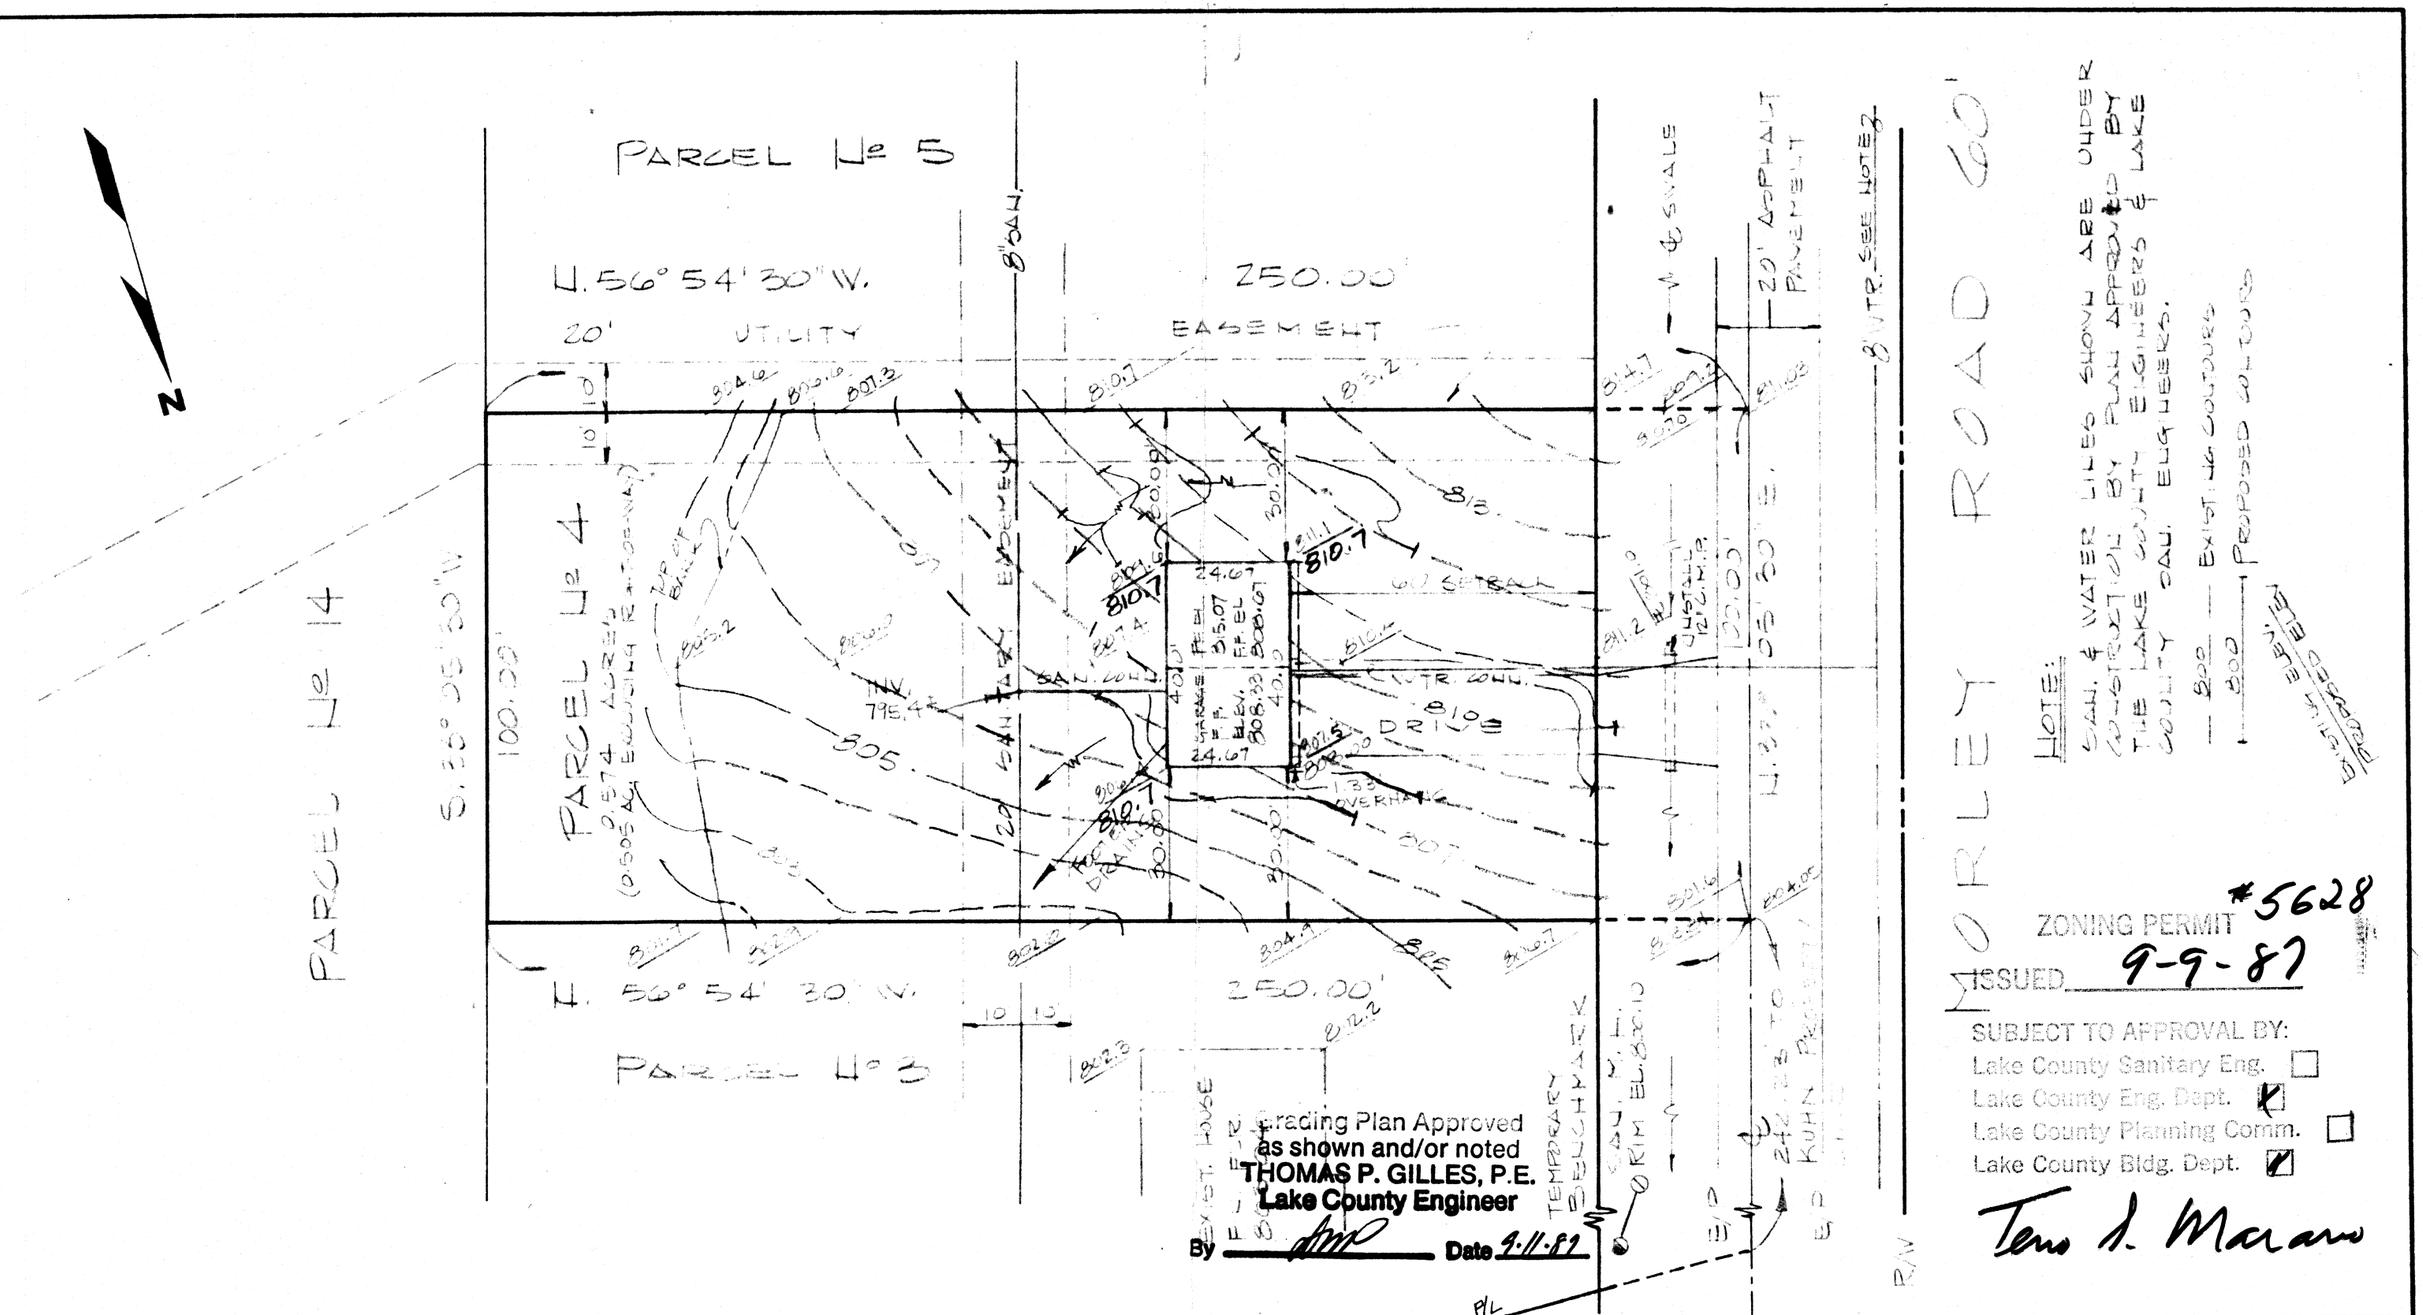

Grading Plan Approved
as shown and/or noted
THOMAS P. GILLES, P.E.
Lake County Engineer
By _____ Date 9-11-87

NOTE:
SAN. & WATER LINES SHOWN ARE UNDER CONSTRUCTION BY PLAN APPROVED BY THE LAKE COUNTY ENGINEERS & LAKE COUNTY SAN. ENGINEERS.

— 800 — EXISTING CONTOURS
— 800 — PROPOSED CONTOURS

ZONING PERMIT #5628
ISSUED 9-9-87

SUBJECT TO APPROVAL BY:
- Lake County Sanitary Eng. ☐
- Lake County Eng. Dept. ☑
- Lake County Planning Comm. ☐
- Lake County Bldg. Dept. ☑

Terri L. Marano

DESIGN CERTIFICATION

THIS PLAT WAS PREPARED BY ME, AND IS CORRECT TO THE BEST OF MY KNOWLEDGE AND BELIEF.

REG. SURVEYOR NO. 5244

AS BUILT CERTIFICATION

I HEREBY CERTIFY THAT THE CIRCLED GRADES ARE EXISTING FINISH GRADES CHECKED IN THE FIELD ON _____ AND THAT SURVEY IS CORRECT TO THE BEST OF MY KNOWLEDGE AND BELIEF.

REG. SURVEYOR NO. _____

COLPETZER-THOMAS, INC.
AN ENGINEERING GROUP
WILLOUGHBY • MENTOR • NORTH CANTON • STEUBENVILLE • LORAIN

DATE 8-21-87
SCALE 1" = 30'
DRWN BY L. H.
CHKD BY
JOB NO 87-377
FB 610 PG

SITE PLAN
FOR
WHITAKER DEVELOPMENT, INC.
NORMANDY DEVELOPMENT - PART OF O.L. 22, TR. 4
WILLOUGHBY TOWNSHIP - COUNTY OF LAKE
STATE OF OHIO