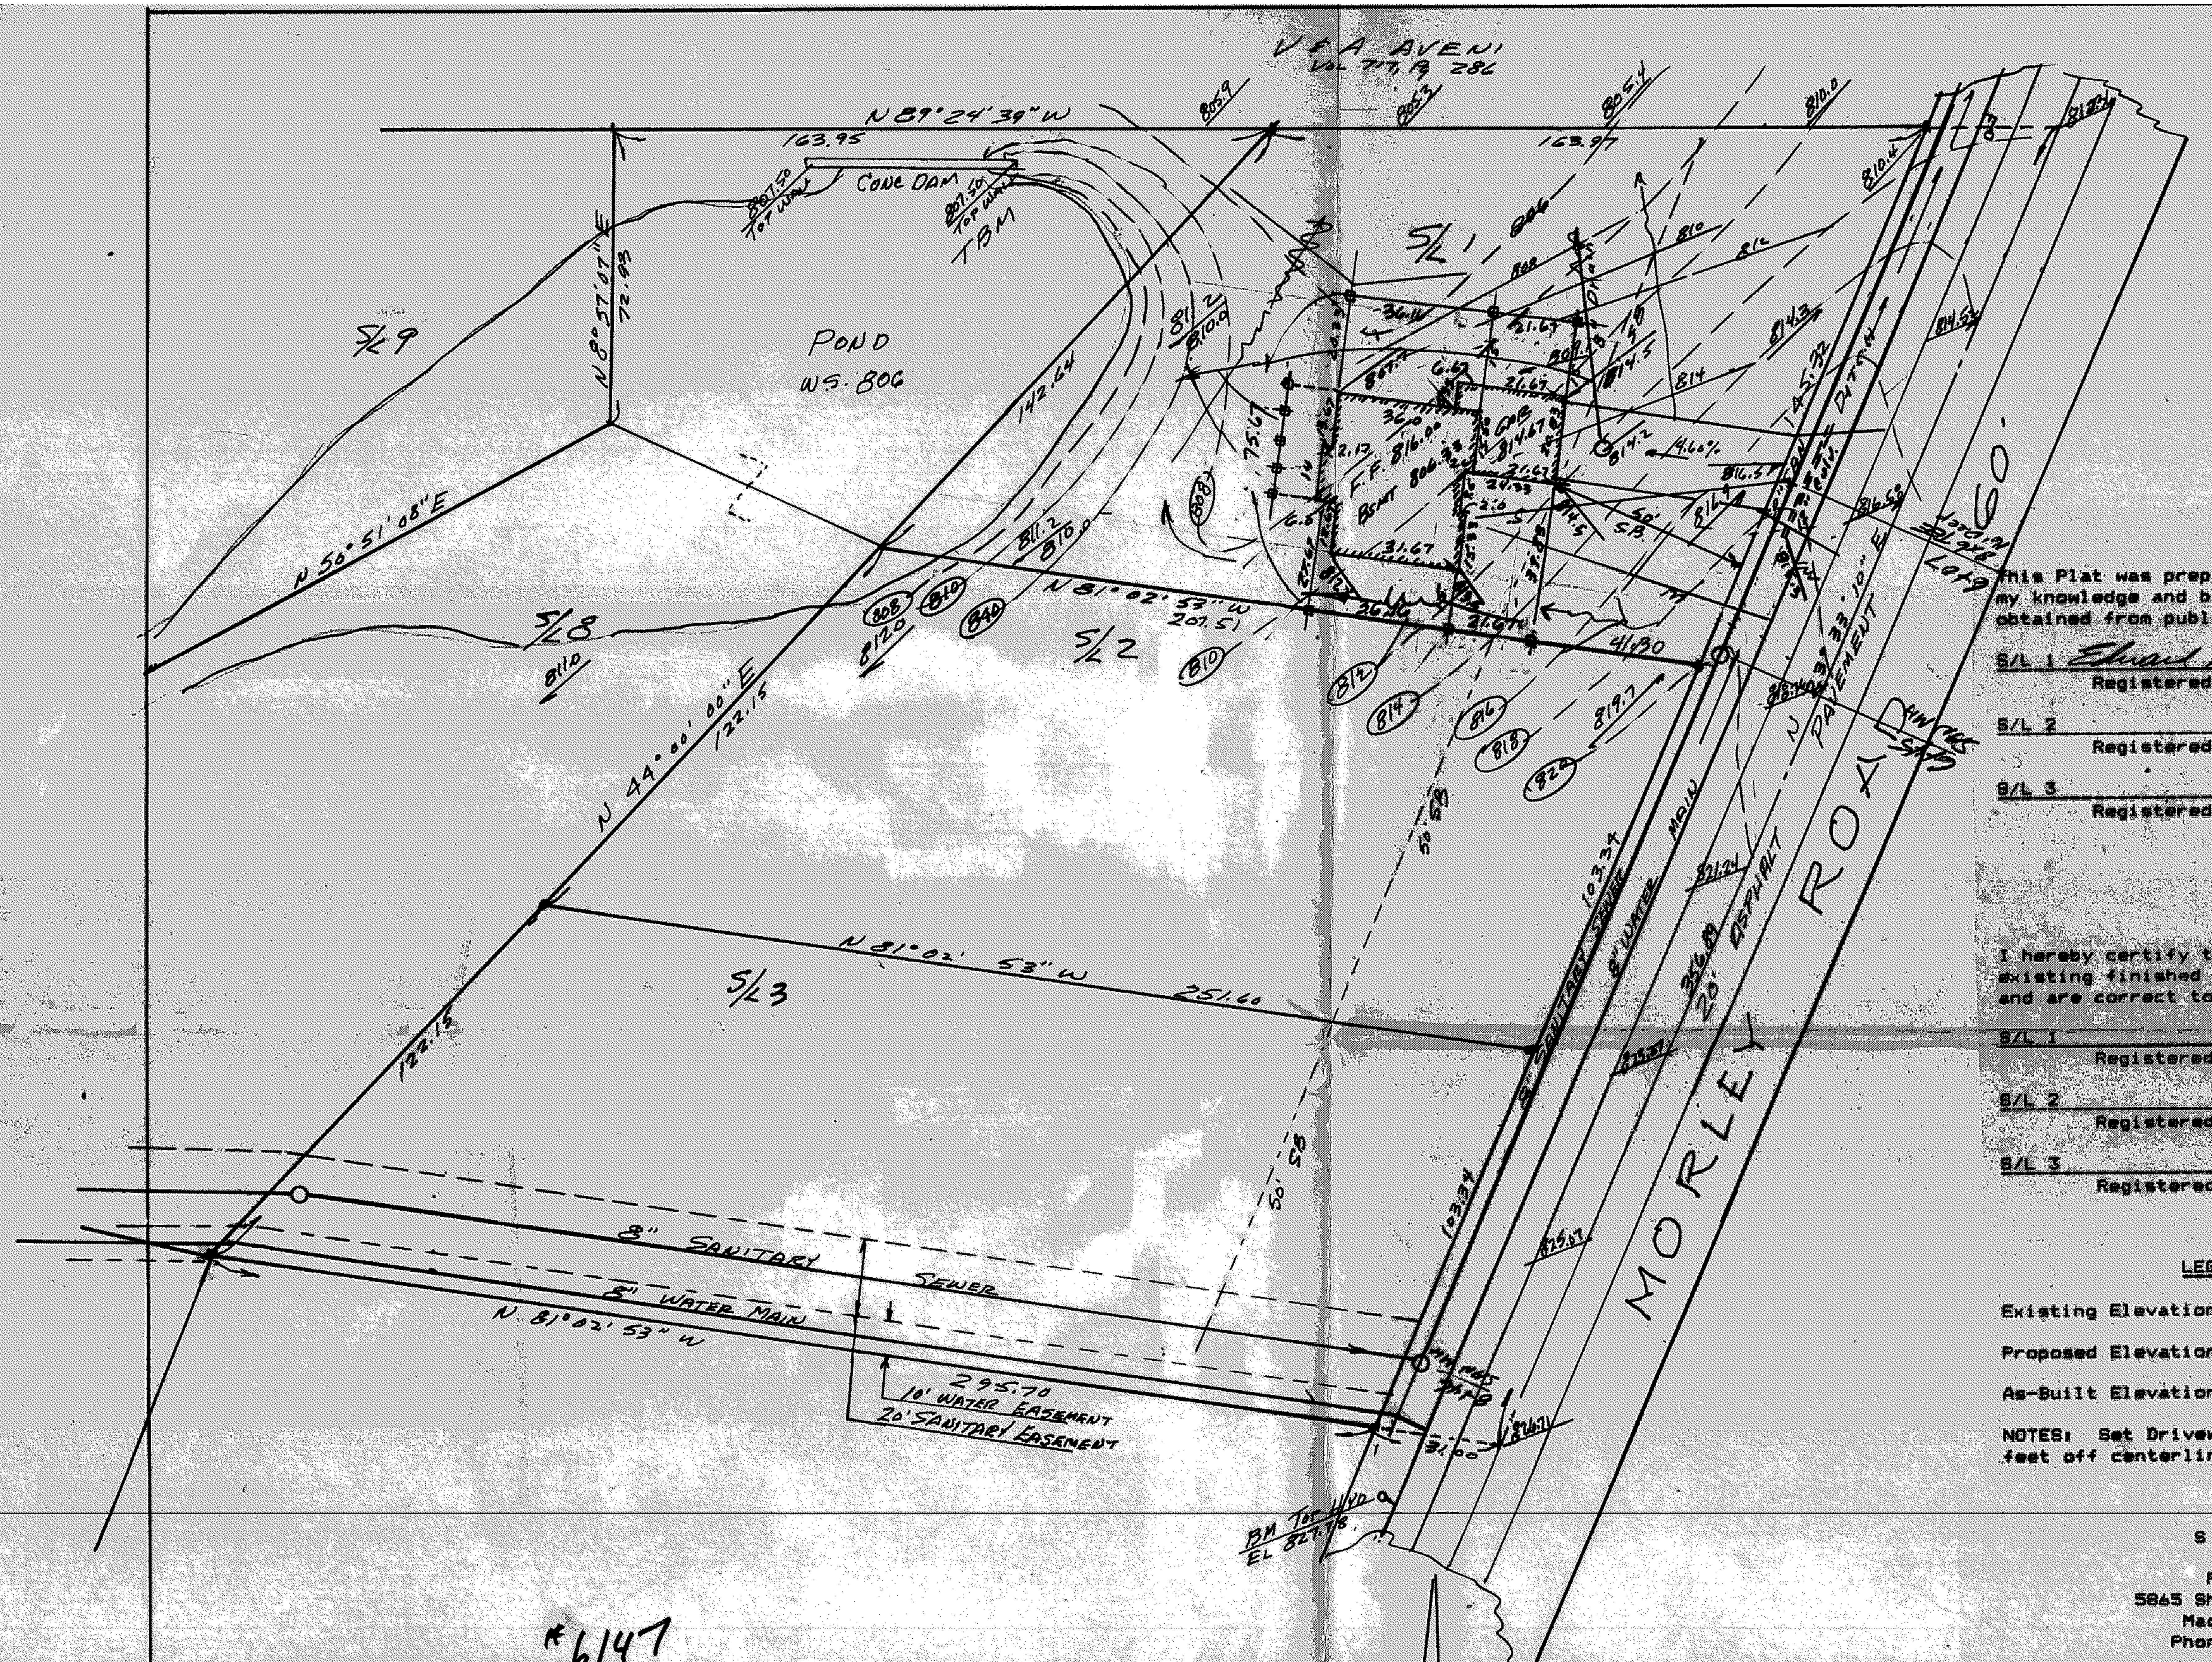

DESIGN CERTIFICATION

This Plat was prepared by me, and is correct to the best of my knowledge and belief. All boundary data shown hereon was obtained from public records.

S/L 1 Edward L. Debevc 7514 4/14/89
Registered Surveyor's Signature Reg. No. Date

S/L 2
Registered Surveyor's Signature Reg. No. Date

S/L 3
Registered Surveyor's Signature Reg. No. Date

"AS BUILT" CERTIFICATION

I hereby certify that the circled grades shown hereon are existing finished grades checked in the field on date shown and are correct to the best of my knowledge and belief.

S/L 1
Registered Surveyor's Signature Reg. No. Date

S/L 2
Registered Surveyor's Signature Reg. No. Date

S/L 3
Registered Surveyor's Signature Reg. No. Date

LEGEND

Existing Elevation: 800 Existing Contour:

Proposed Elevation: 800 Proposed Contour:

As-Built Elevation: 800

NOTES: Set Driveway culvert 15" below edge of pavement, 24 feet off centerline. Use 12" CMP, 12 gauge culvert pipe.

SITE PLAN

For Ray Zirkle
5865 Shore Drive, PO Box 25
Madison, Ohio 44057
Phone (216) 428-2058

Of Sublot No 1, 2, and 3
OLDE MILL SUBDIVISION
Concord Township,
Lake County, Ohio

Prepared By:

Debevec-Balo & Associates, Inc.
860 Bryn Mawr Avenue
Wickliffe, Ohio 44092
Phone (216) 944-2589

Scale: 1"=30'

Rev 5/5/89
March 1989

BG0089-1, 2, 3

1" = 30'

BENCHMARK:
TOP HYDRANT S/L 9 @ CALDUSAC
OF HOBBY HORSE LANE
ELEV 814.67

Grading Plan Approved
as shown and/or noted
THOMAS P. GILLES, P.E.
Lake County Engineer

By [signature] Date 5-12-89

ZONING PERMIT #6147
ISSUED 5-9-89
SUBJECT TO APPROVAL BY:
Lake County Sanitary Eng. ☐
Lake County Eng. Dept. ☒
Lake County Planning Comm. ☐
Lake County Bldg. Dept. ☒
Tom A. Marano