THE NORTH COAST ENGINEERING AND SURVEYING CO., INC
2570 SUPERIOR AVENUE, SUITE 501
CLEVELAND, OHIO 44114
(216) 241-7070

2 WORKING DAYS BEFORE YOU DIG
CALL TOLL FREE 800-362-2764
OHIO UTILITIES PROTECTION SERVICE

SITE PLAN

for: QUALITY HOMES

P.O. BOX 159 44081
ADDRESS STREET CITY

SUBLOT No.	SUBDIVISION NAME	VOL.	PAGE
LOT 258, TRACT 4	CONCORD TWP.	OHIO	
LOT, TRACT	CITY		

BENCHMARK: P.K. NAIL @ NORTH E. INTERSECTION WITH E. ELEV. = 1014.00

CHECK LIST

LOT DIMENSIONS & BEARINGS
TIE TO NEAREST STREET
SUBLOT No. (PARCEL No.)
SURROUNDING OWNERS
BUILDING DIMENSIONS
SETBACK, SIDEYARD, REARYARD
FINISHED GRADES
DRIVE & APRON TYPE, WIDTH, THICKNESS
SIDEWALK TYPE, WIDTH, THICKNESS
CULVERT TYPE, DIAM., LENGTH
WATER MAIN SIZE, LOCATION
SAN. SEWER SIZE, % GRADE, LOCATION
SAN. M.H. CAST. ELEV., INV. ELEV.
SAN. CONN. SIZE, % GRADE, LOCATION
STORM SEWER SIZE, % GRADE, LOCATION
STORM M.H. CAST. ELEV., INV. ELEV.
PAVT. TYPE, GRADE, CURBS
GAS LINE LOC., SIZE
SEPTIC SYSTEM & DUPLICATION
WELL LOCATION & ISOLATION RADIUS

JOSEPH M. BUTOSKEY 61861 REGISTERED PROFESSIONAL ENGINEER
STATE SEAL

DESIGN CERTIFICATION

THIS PLAT WAS PREPARED BY ME, AND IS CORRECT TO THE BEST OF MY KNOWLEDGE

Joseph Butoskey PE 3/10/93
NAME DATE

"AS-BUILT" CERTIFICATION

I HEREBY CERTIFY THAT THE CIRCLED INFORMATION IS EXISTING AS OBTAINED ON THE SITE _____ 19___ AND IS CORRECT TO THE BEST OF MY KNOWLEDGE AND BELIEF.

NAME

LEGEND

STORM MANHOLE
SANITARY MANHOLE
EXISTING CONTOURS ---100---
PROPOSED CONTOURS (100)
EXIST. ELEV. 100.0
100.0 PROP. ELEV.
DIRECTION OF SURFACE DRAINAGE

DRAWN BY: PWH T	SCALE: 1"=30'
CH'D BY: J.G.	DATE: MAR. '93'
REV. MOVED HOUSE	5/4/93
REVISED DRIVE & SWALE	7/6/93
REV.	

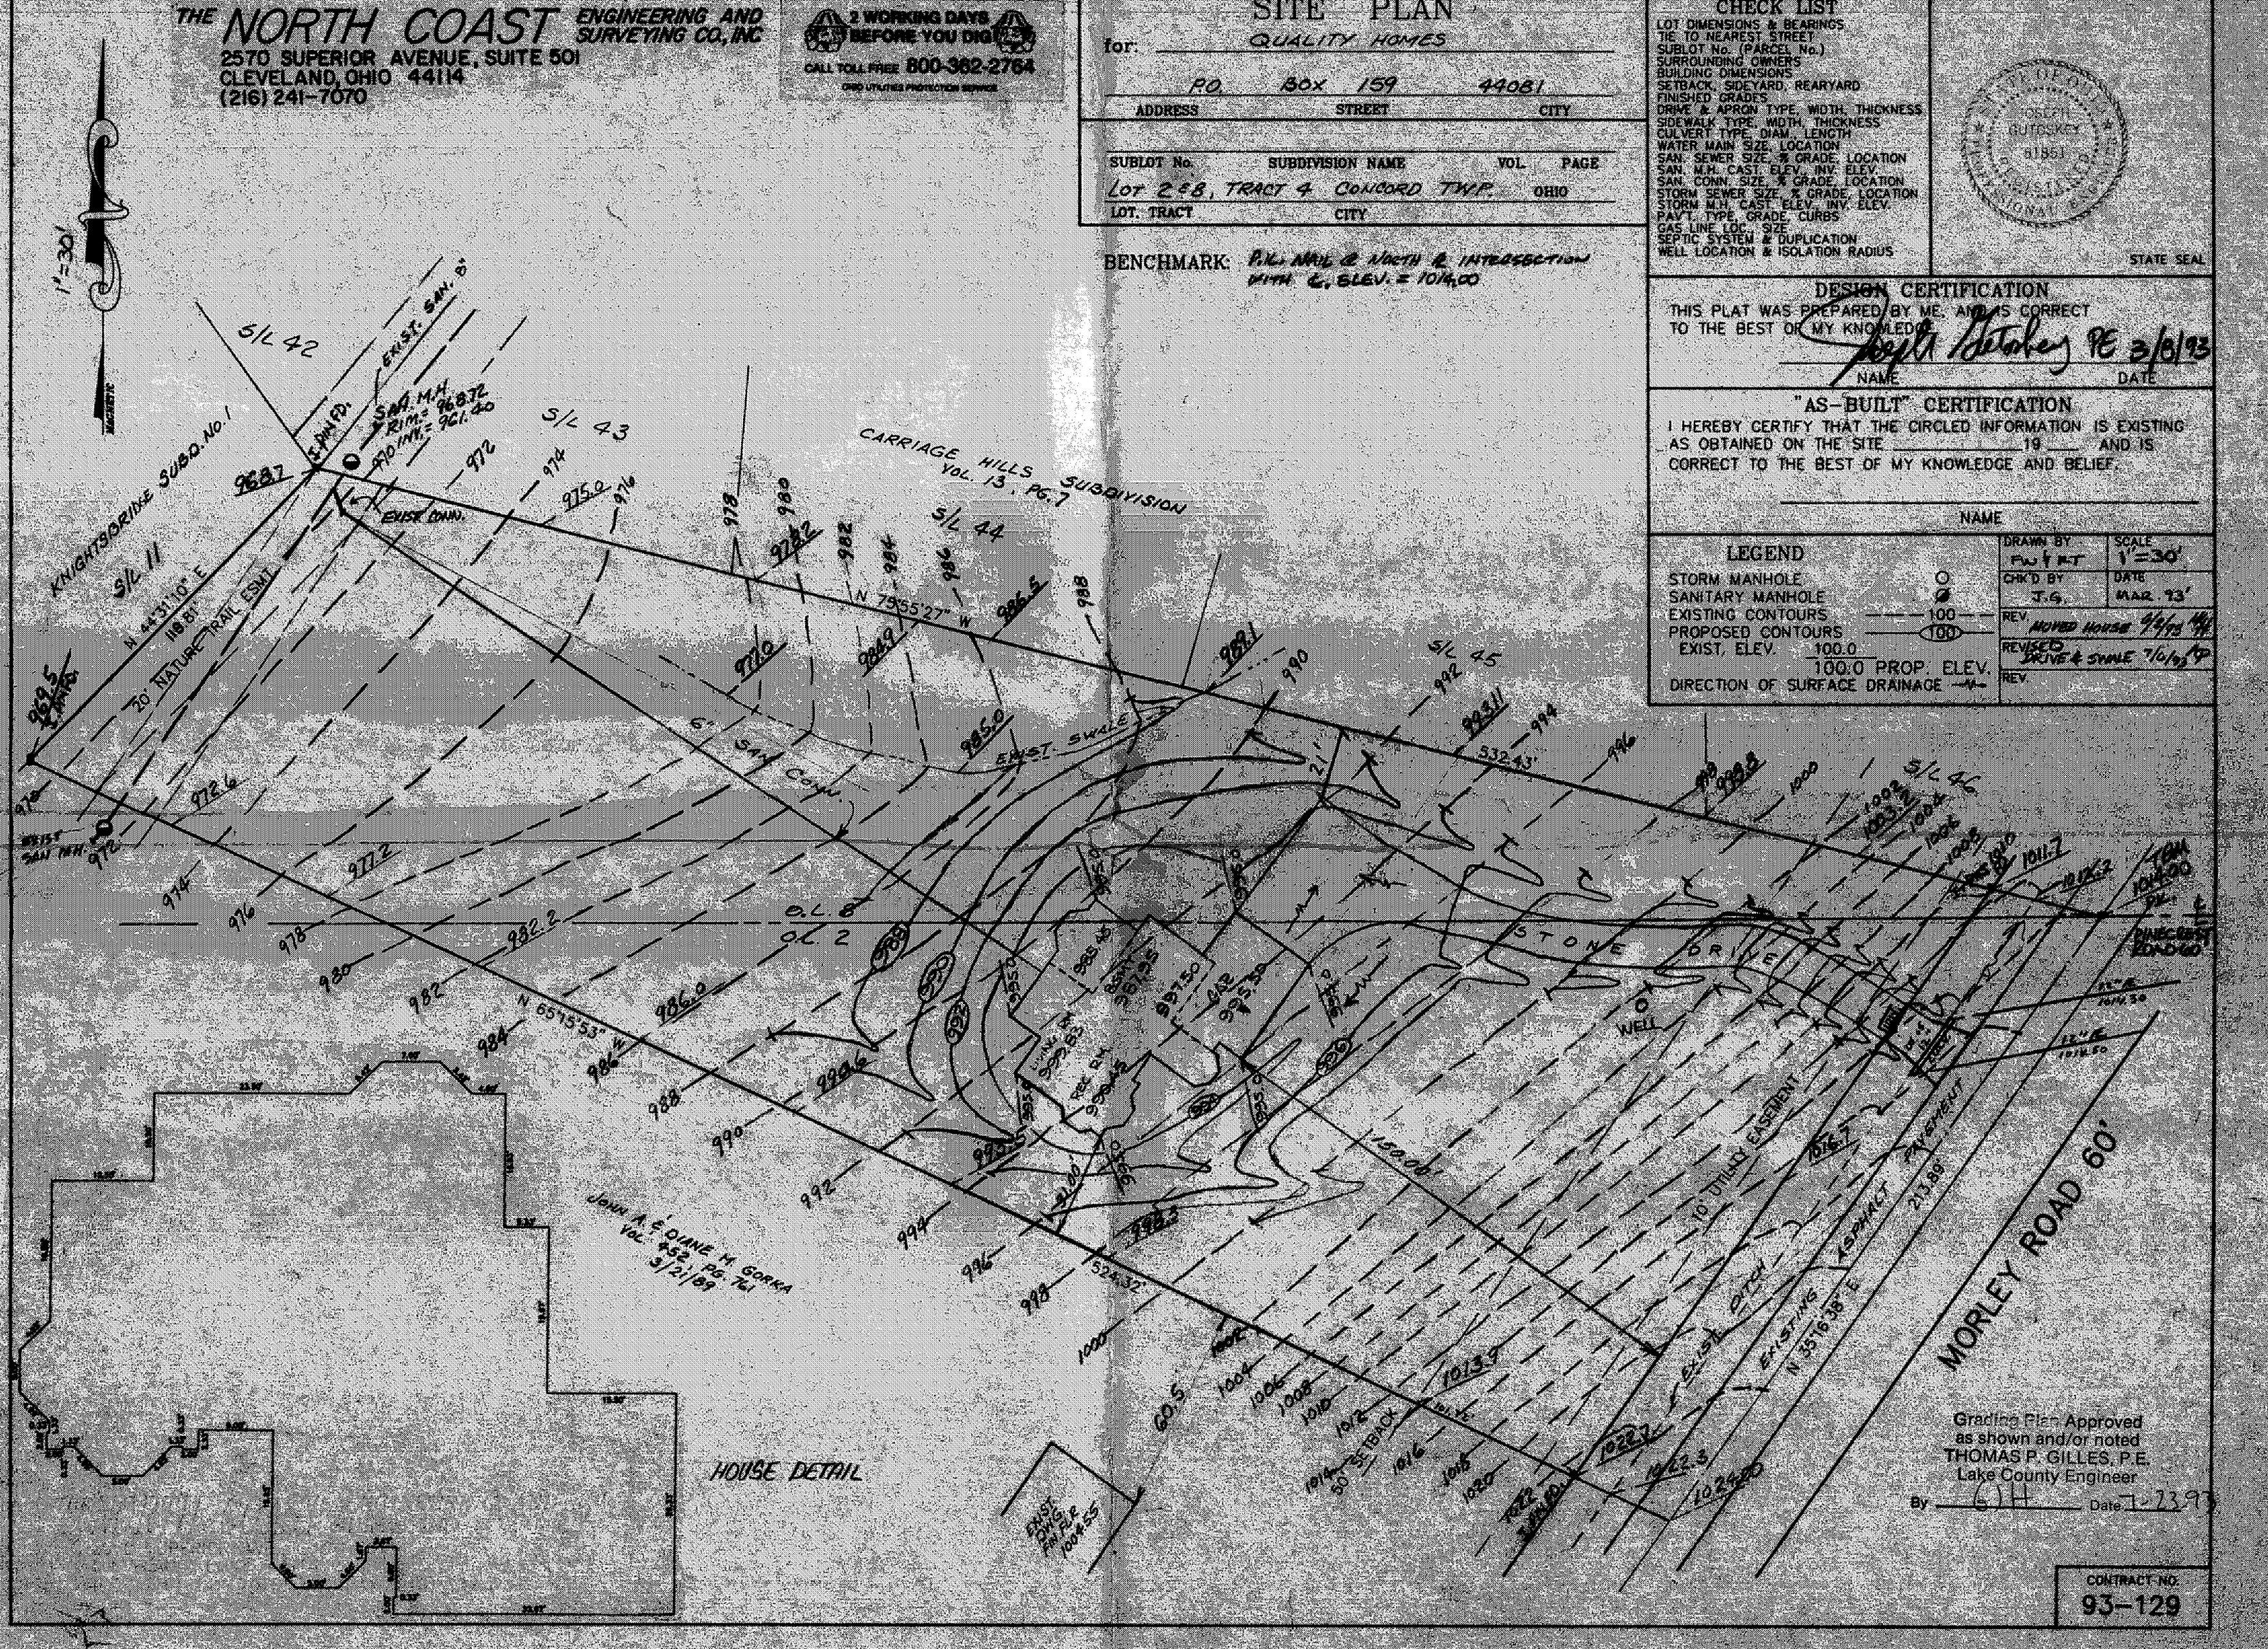

Grading Plan Approved as shown and/or noted
THOMAS P. GILLES, P.E.
Lake County Engineer
By _____ Date 7-23-93

CONTRACT NO.
93-129