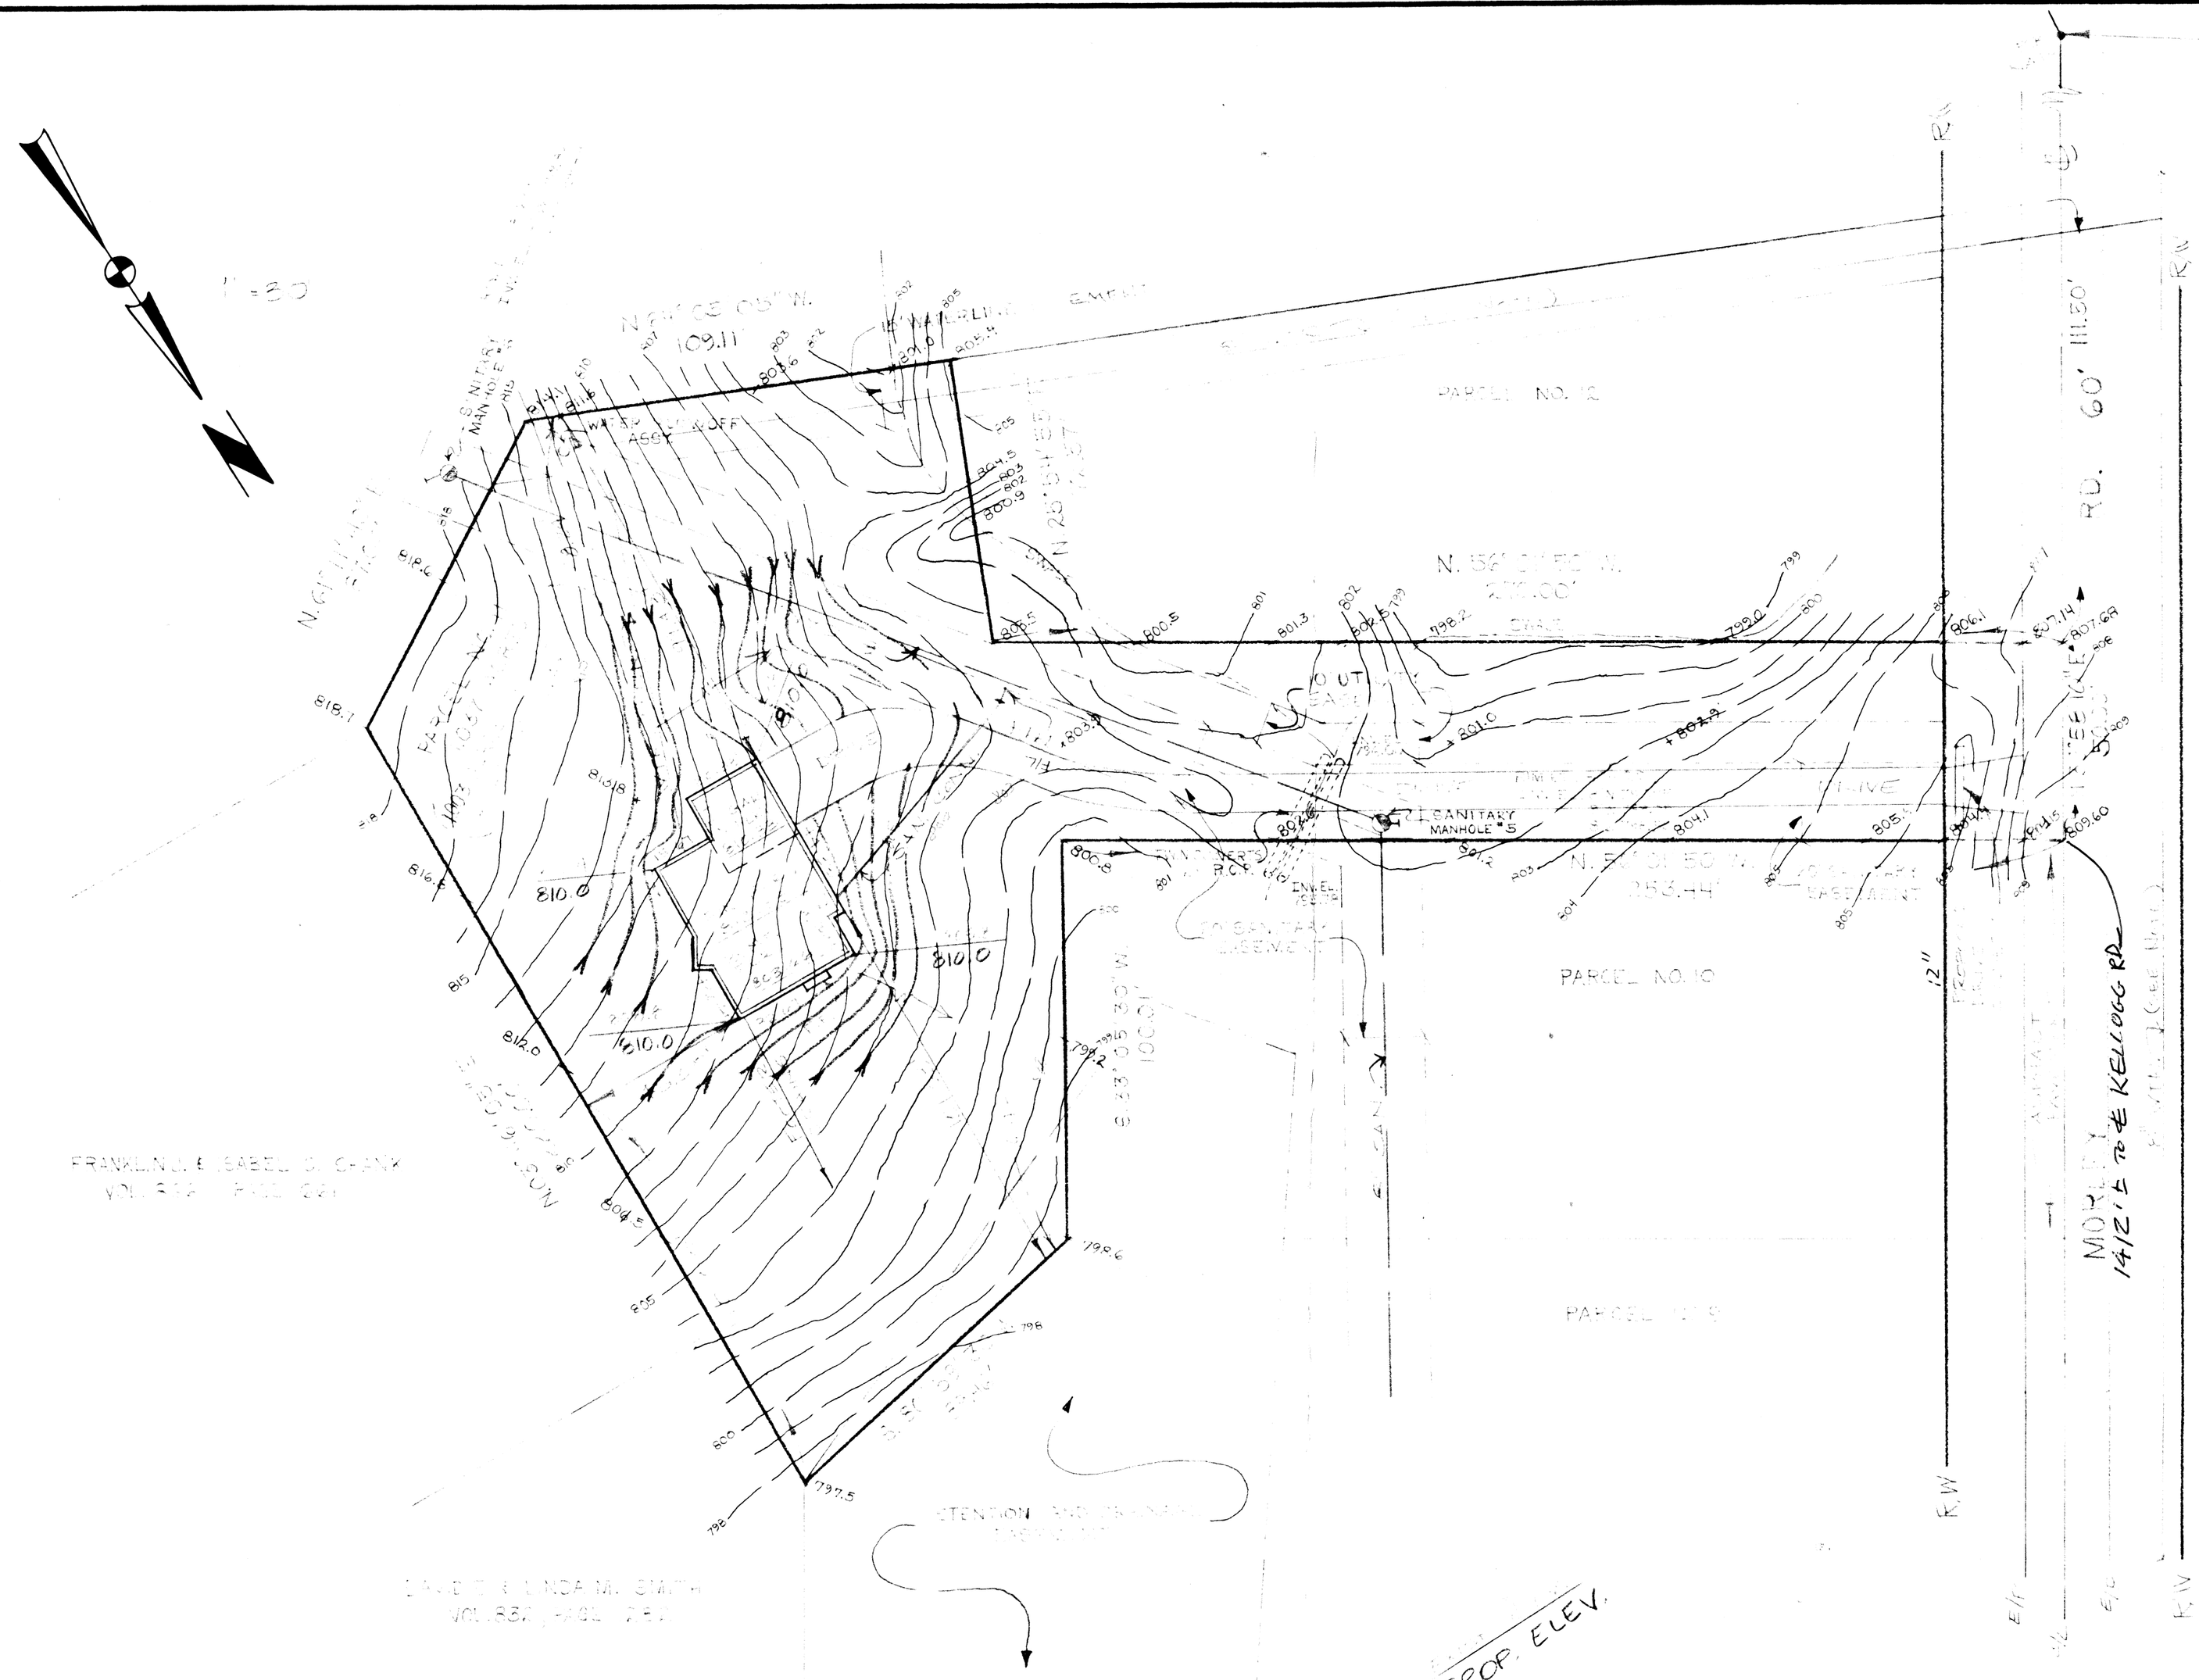

ZONING PERMIT #5627
ISSUED 9-9-87
SUBJECT TO APPROVAL BY:
Lake County Sanitary Eng. ☐
Lake County Eng. Dept. ☒
Lake County Planning Comm. ☐
Lake County Bldg. Dept. ☒

Teno S. Marano

Grading Plan Approved
as shown and/or noted
THOMAS P. GILLES, P.E.
Lake County Engineer
By [signature] Date 9/17/87

NOTE: Q10 DESIGN INDICATES THE NEED FOR HARD SURFACE DRIVE. DRIVE SHALL BE INSTALLED AS PER ATTACHED PLAN & PROFILE

NOTE:
SAN. & WATER LINES SHOWN ARE UNDER CONSTRUCTION BY PLAN APPROVED BY THE LAKE COUNTY ENGINEERS & LAKE COUNTY SAN. ENGINEERS.

NOTE:
[illegible] THROUGH [illegible] 24" [illegible]
[illegible] PEAK [illegible] 43.7 [illegible]
AS CALCULATED IN [illegible] CREEK
WATER SHED [illegible] TRIBUTARY No. 1

CERTIFICATION
THIS PLAT WAS PREPARED BY ME AND IS CORRECT TO THE BEST OF MY KNOWLEDGE AND BELIEF
[signature]
REG. SURVEYOR NO. 5244

SITE PLAN FOR WHITAKER DEVELOPMENT INC.
NORMANDY DEVELOPMENT - PART OF O.L.22 TR.4
CONCORD TOWNSHIP - COUNTY OF LAKE - STATE OF OHIO

DATE [illegible]
SCALE 1"=50'
DRAWN BY [illegible]
CH'K'D BY [illegible]

COLPETZER-THOMAS, INC.
AN ENGINEERING GROUP
WILLOUGHBY - MENTOR - NORTH CANTON - STEUBENVILLE - LORAIN

SHEET 1 OF 1
CONTRACT NO. [illegible]