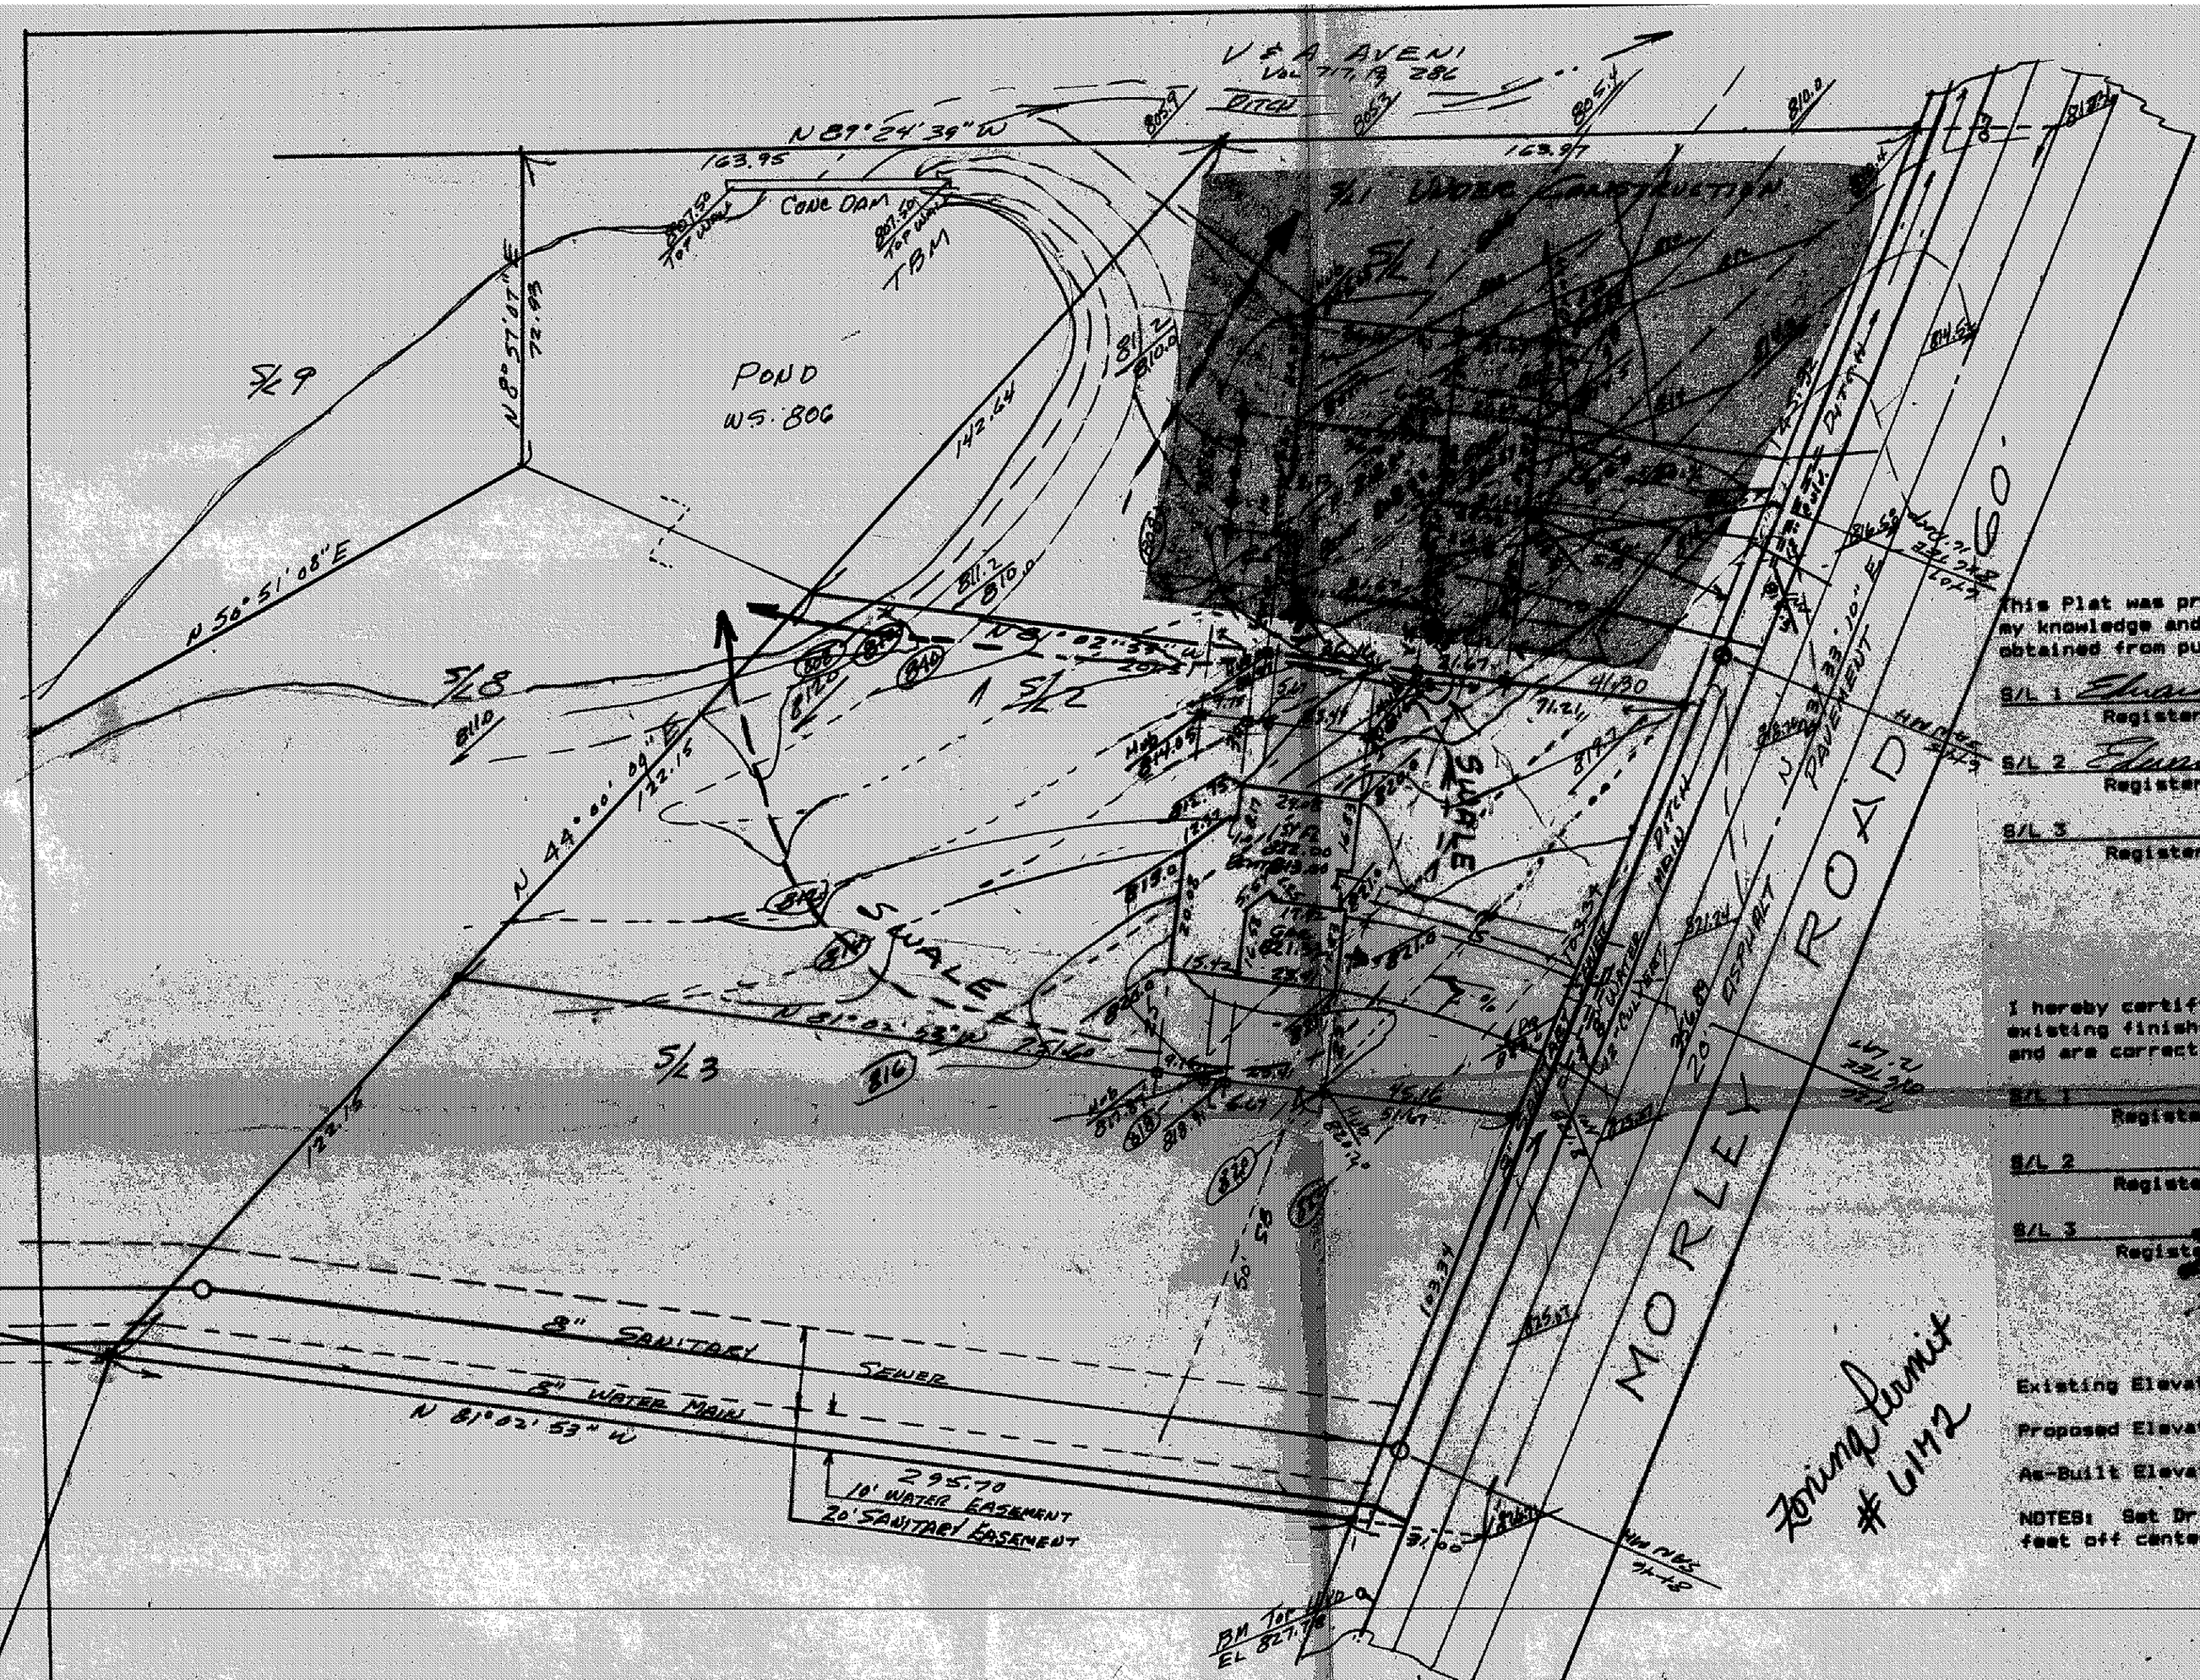

DESIGN CERTIFICATION

This Plat was prepared by me, and is correct to the best of my knowledge and belief. All boundary data shown hereon was obtained from public records.

S/L 1 Edward L Oben — 4514 — 4/24/89
Registered Surveyor's Signature Reg. No. Date

S/L 2 Edward L Oben — 4514 — 5/22/89
Registered Surveyor's Signature Reg. No. Date

S/L 3 _____
Registered Surveyor's Signature Reg. No. Date

"AS BUILT" CERTIFICATION

I hereby certify that the circled grades shown hereon are existing finished grades checked in the field on date shown and are correct to the best of my knowledge and belief.

S/L 1 _____
Registered Surveyor's Signature Reg. No. Date

S/L 2 _____
Registered Surveyor's Signature Reg. No. Date

S/L 3 _____
Registered Surveyor's Signature Reg. No. Date

LEGEND

Existing Elevation: 800 — Existing Contour: ——

Proposed Elevation: 805 — Proposed Contour: ——

As-Built Elevation: 808

NOTES: Set Driveway culvert 18" below edge of pavement, 24 feet off centerline. Use 12" CMP, 12 gauge culvert pipe.

S/L 2 REVISED 6/5/89 EJO

Subdot No. 2 Only!

Grading Plan Approved
as shown and/or noted
THOMAS P. GILLES, P.E.
Lake County Engineer
By _____ Date 6-6-89

Sump Pump Required.

BENCHMARK:
TOP HYDRANT S/L 9 @ CALDWELL
OF HOBBY HORSE LANE
ELEV 814.67

SITE PLAN

For Ray Zirkle
5865 Shore Drive, PO Box 25
Madison, Ohio 44057
Phone (216) 428-2058

Of Sublot No. 1, 2, and 3
OLDE MILL SUBDIVISION
Concord Township,
Lake County, Ohio

Prepared By:

Debevec-Salo & Associates, Inc.
840 Bryn Mawr Avenue
Wickliffe, Ohio 44092
Phone (216) 944-2589

S/L 2 5/22/89
Rev 5/5/89

Scale: 1"=30'

March 1989

860089-1, 2, 3