N

GRAPHIC SCALE

30 0 15 30 60 120

(IN FEET)
1 inch = 30 ft.

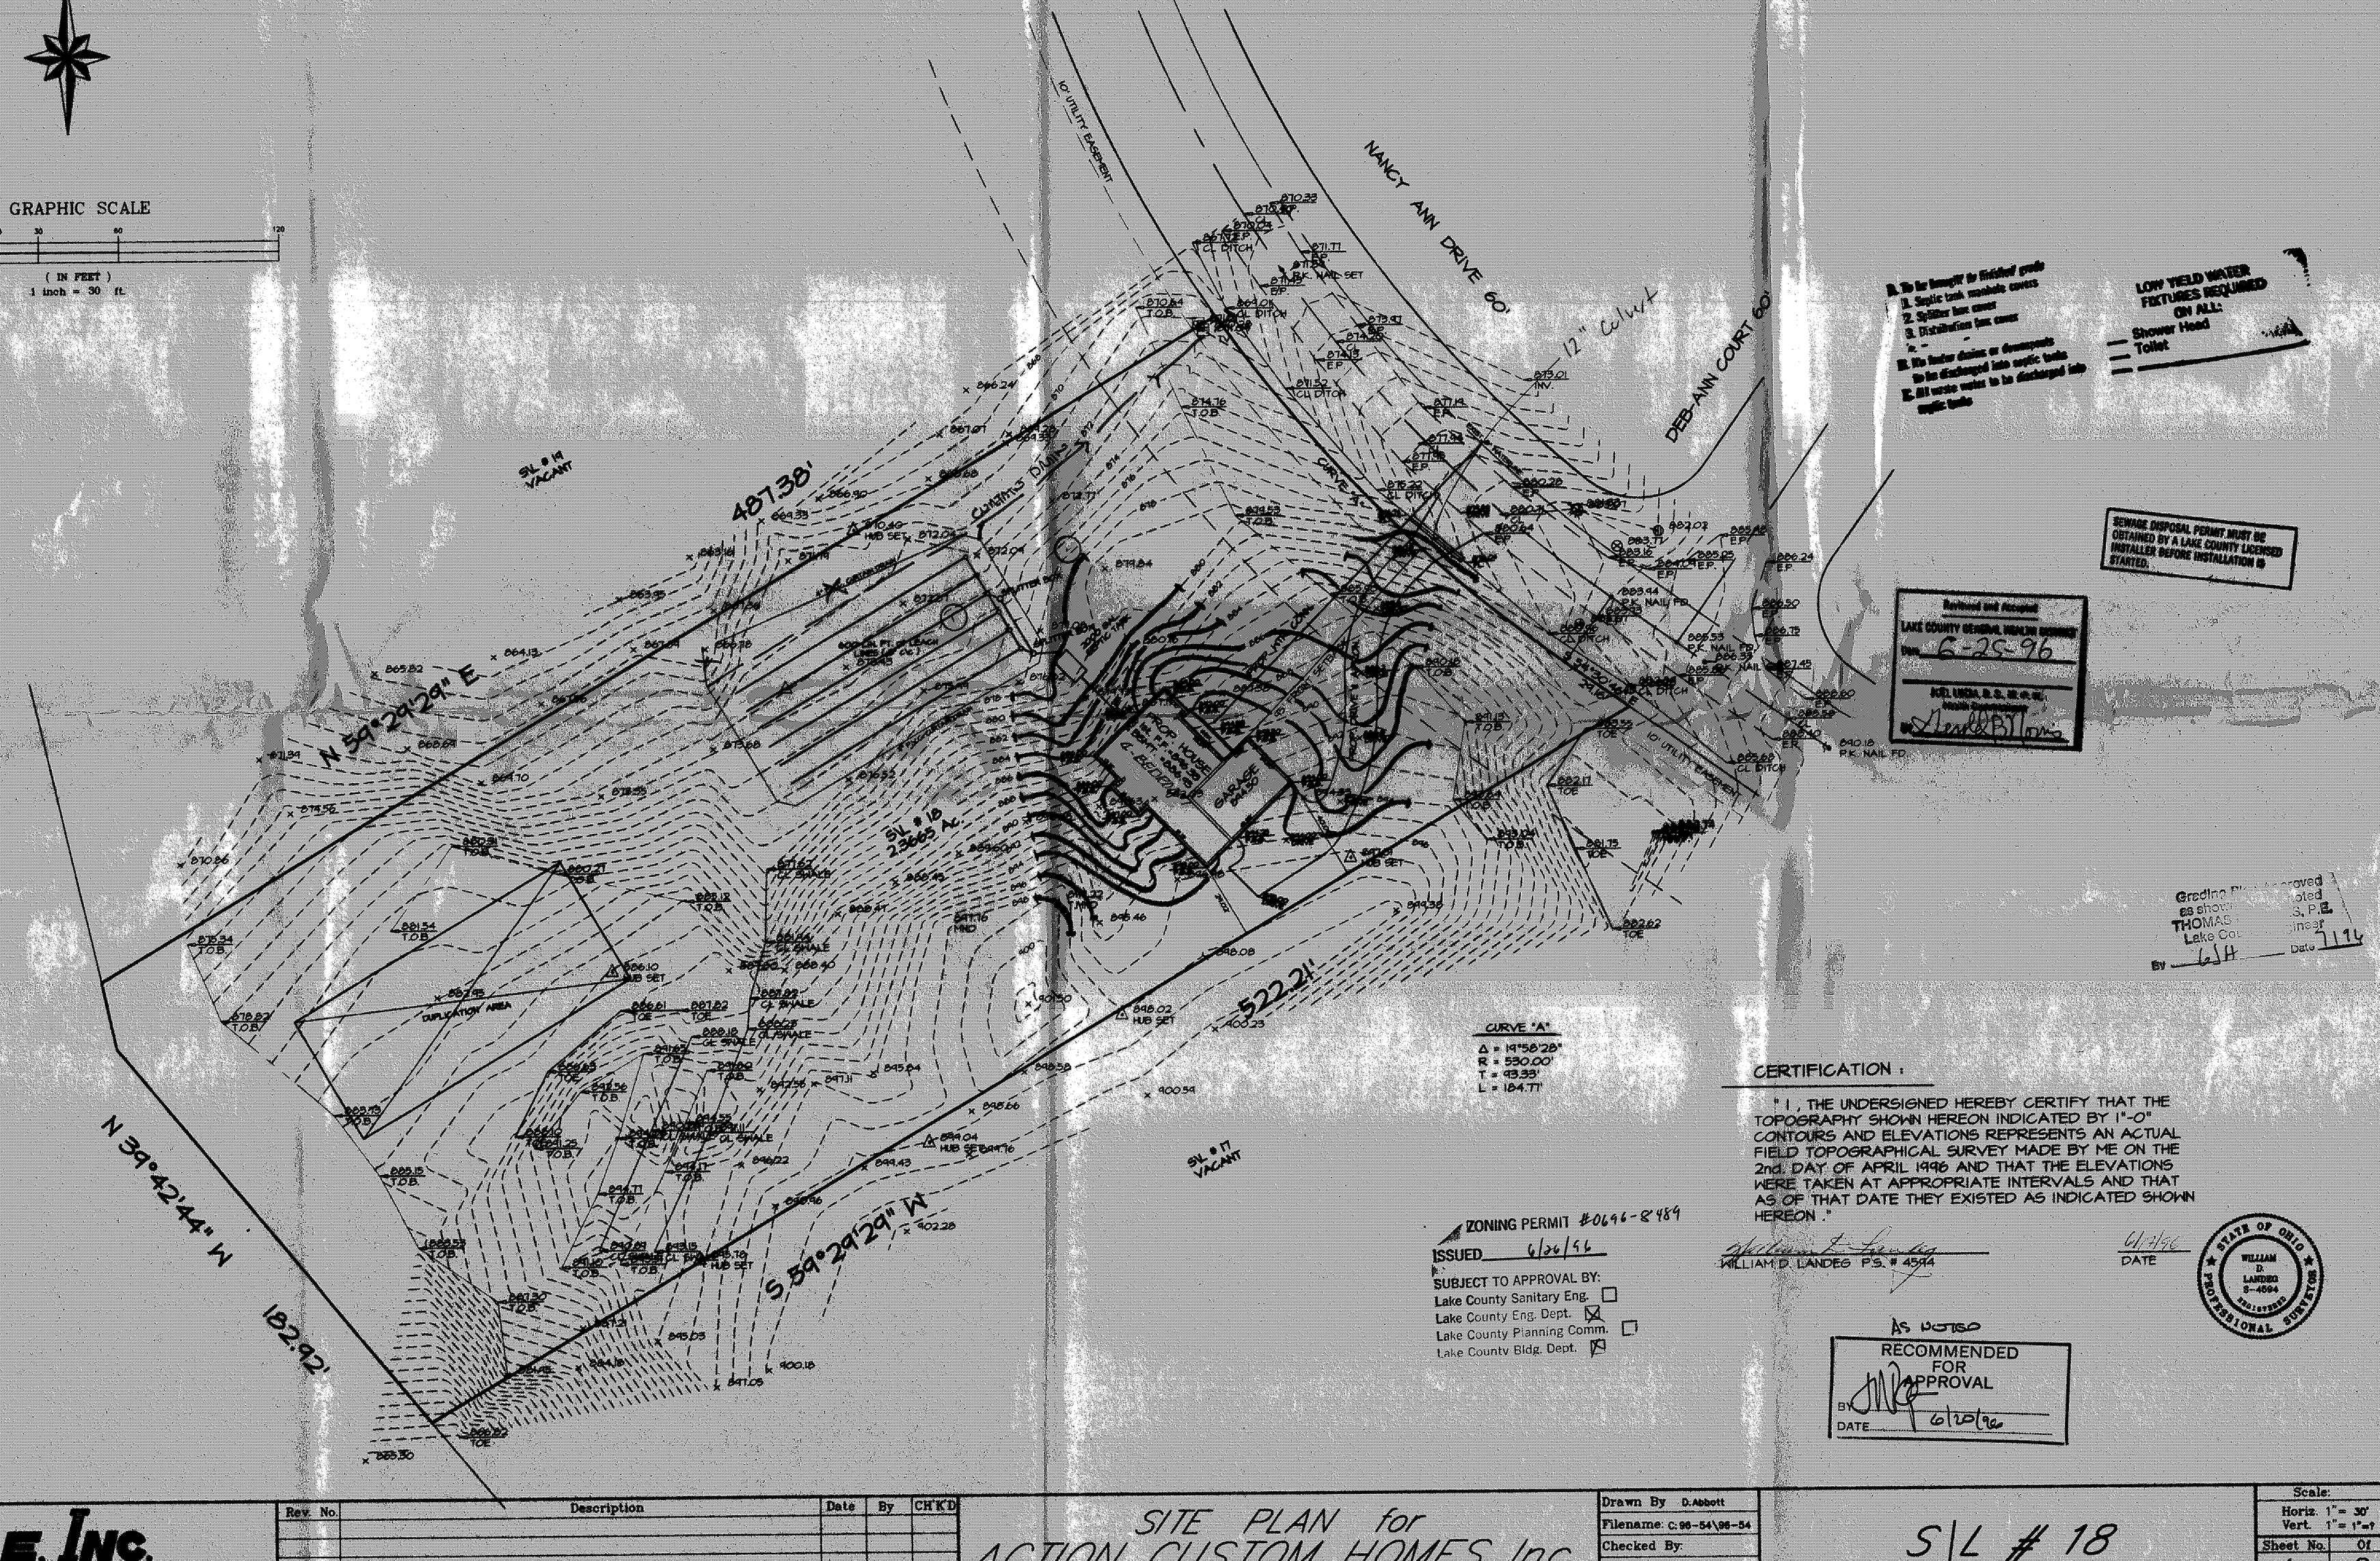

A. No lot drought to finished grade
1. Septic tank manhole covers
2. Splitter box cover
3. Distribution box cover
4. -
B. No water drains or downspouts to be discharged into septic tanks
C. All water mains to be discharged into septic tanks

LOW YIELD WATER FIXTURES REQUIRED ON ALL:
— Shower Head
— Toilet
—

SEWAGE DISPOSAL PERMIT MUST BE OBTAINED BY A LAKE COUNTY LICENSED INSTALLER BEFORE INSTALLATION IS STARTED.

Reviewed and Accepted
LAKE COUNTY GENERAL HEALTH DISTRICT
Date 6-25-96
JOEL LIKOVICH, R.S., M.P.H., M.B.A.
Health District Director
By [signature]

Grading Plan Approved as shown
THOMAS P. LINEAR, P.E.
Lake County Engineer
By [signature] Date 7/1/96

ZONING PERMIT #0696-8489
ISSUED 6/26/96
SUBJECT TO APPROVAL BY:
Lake County Sanitary Eng. ☐
Lake County Eng. Dept. ☒
Lake County Planning Comm. ☐
Lake County Bldg. Dept. ☒

CERTIFICATION :

" I, THE UNDERSIGNED HEREBY CERTIFY THAT THE TOPOGRAPHY SHOWN HEREON INDICATED BY 1'-0" CONTOURS AND ELEVATIONS REPRESENTS AN ACTUAL FIELD TOPOGRAPHICAL SURVEY MADE BY ME ON THE 2nd. DAY OF APRIL 1996 AND THAT THE ELEVATIONS WERE TAKEN AT APPROPRIATE INTERVALS AND THAT AS OF THAT DATE THEY EXISTED AS INDICATED SHOWN HEREON."

[signature]
WILLIAM D. LANDES P.S. # 4594

6/17/96
DATE

STATE OF OHIO
WILLIAM D. LANDES
S-4594
REGISTERED
PROFESSIONAL SURVEYOR

AS NOTED
RECOMMENDED FOR APPROVAL
BY [signature]
DATE 6/20/96

LAKE, INC.
ENGINEERS & SURVEYORS

Rev. No.	Description	Date	By	CH'KD

SITE PLAN for ACTION CUSTOM HOMES Inc.

CAL WOODS SUBD. CONCORD

Drawn By	D.Abbott
Filename:	C:\96-54\96-54
Checked By:	
Approved By:	

S/L # 18

Scale:	
Horiz.	1" = 30'
Vert.	1" = 1'=7
Sheet No.	Of
1	2