SITE DRAINAGE PLAN FOR:

CHANDLE CONST.

8353 MENTOR AVENUE
MENTON, OHIO 44060

BEING SUBLOT NO. 7 IN MORLEY HILLS ESTATES SUBDIVISION IN CONCORD TOWNSHIP, OHIO.

PREPARED BY:

WM. R. GRAY ASSOC. INC.
7547 MENTOR AVENUE
MENTON, OHIO 44060

CIVIL ENGINEERS
SURVEYORS.

DATE: APRIL 23, 1974 SCALE 1" = 20'

CERTIFICATION:

I HEREBY CERTIFY THAT THIS PLAT IS CORRECT TO THE BEST OF MY KNOWLEDGE.

BY: Wm. R. Gray
Wm. R. Gray P.E.S. #2162
P.E. #2421

Grading Permit Issued 4-26-74
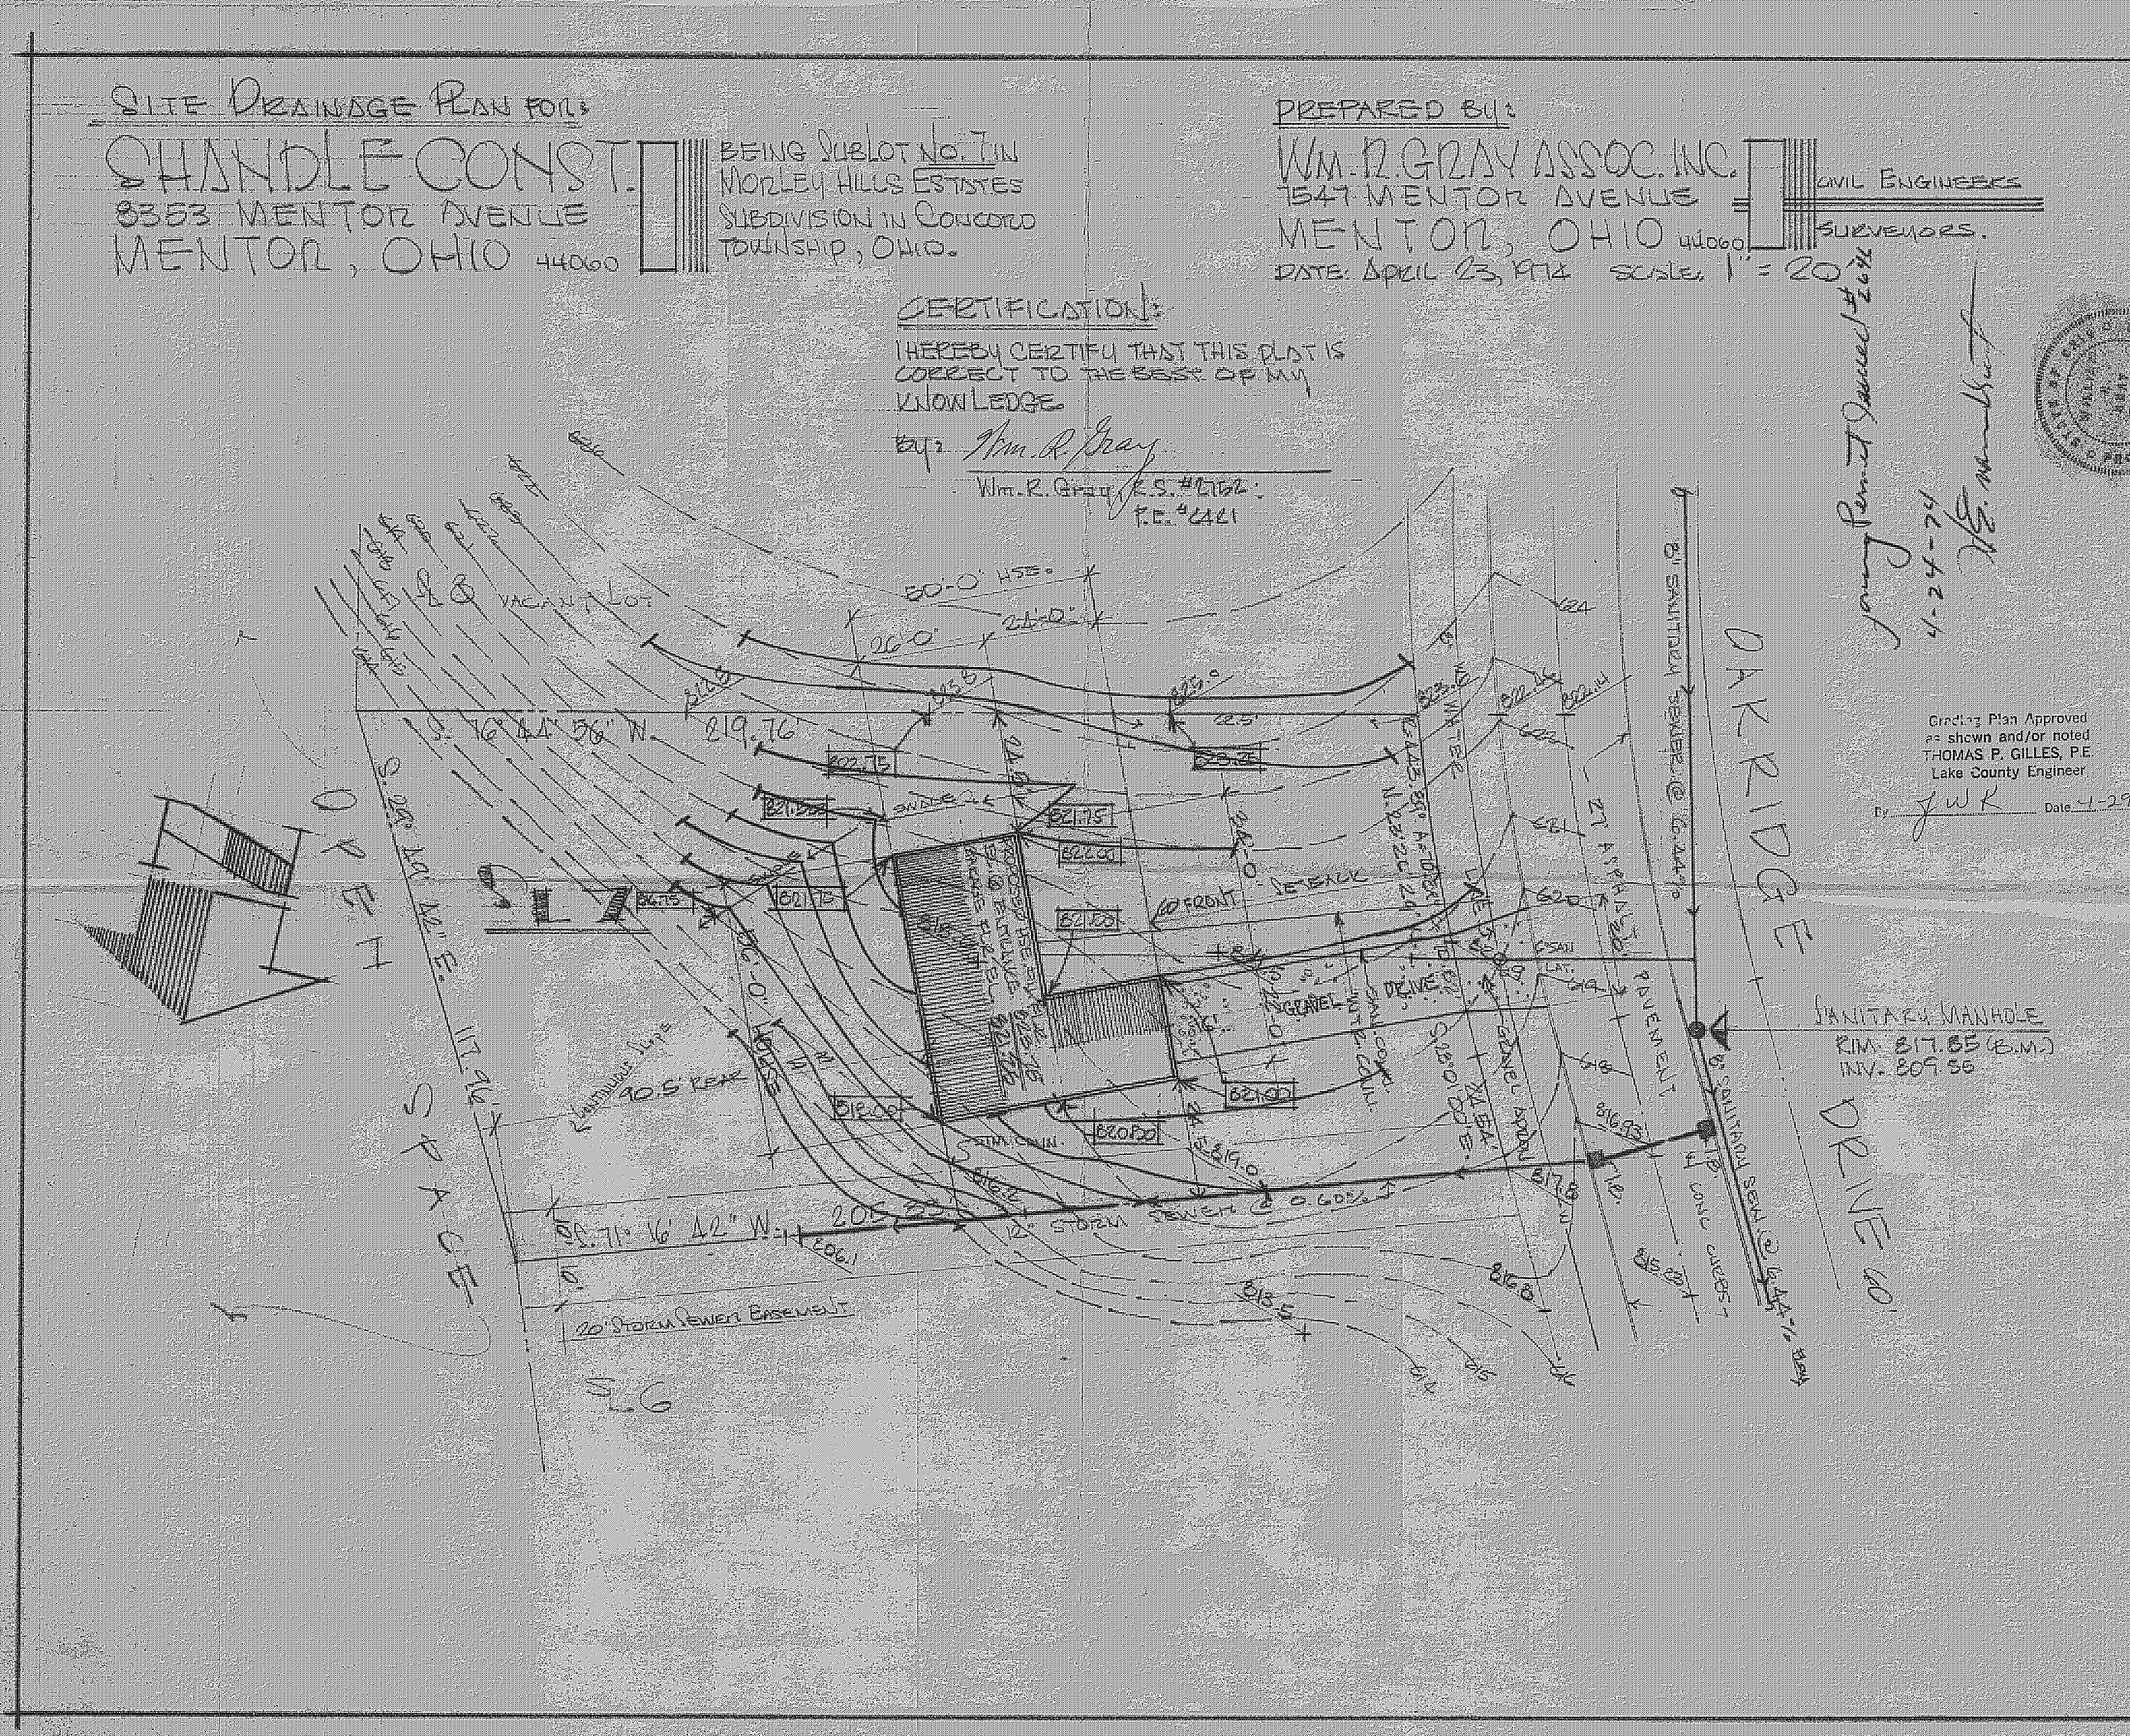
Grading Plan Approved as shown and/or noted
THOMAS P. GILLES, P.E.
Lake County Engineer
By J W K Date 4-29-74