SITE PLAN FOR:

SHANDLE CONSTR.

8353 MENTOR AVE.

MENTOR, OHIO

BEING SUBLOT No. 10 IN THE MORLEY HILLS ESTATES SUBD. No. 1 LOCATED IN CONCORD TWP., OHIO.

PREPARED BY:

WM. R. GRAY ASSOC. INC.

7547 MENTOR AVE.

MENTOR, OHIO

DATE: JAN. 14, 1975 SCALE: 1" = 20'

CERTIFICATION:

I HEREBY CERTIFY THAT THIS PLAT IS CORRECT TO THE BEST OF MY KNOWLEDGE.

BY: Wm. R. Gray

STATE OF OHIO WM. R. GRAY 2752 REGISTERED PROFESSIONAL SURVEYOR

WM. R. GRAY REG. SURV. # 27

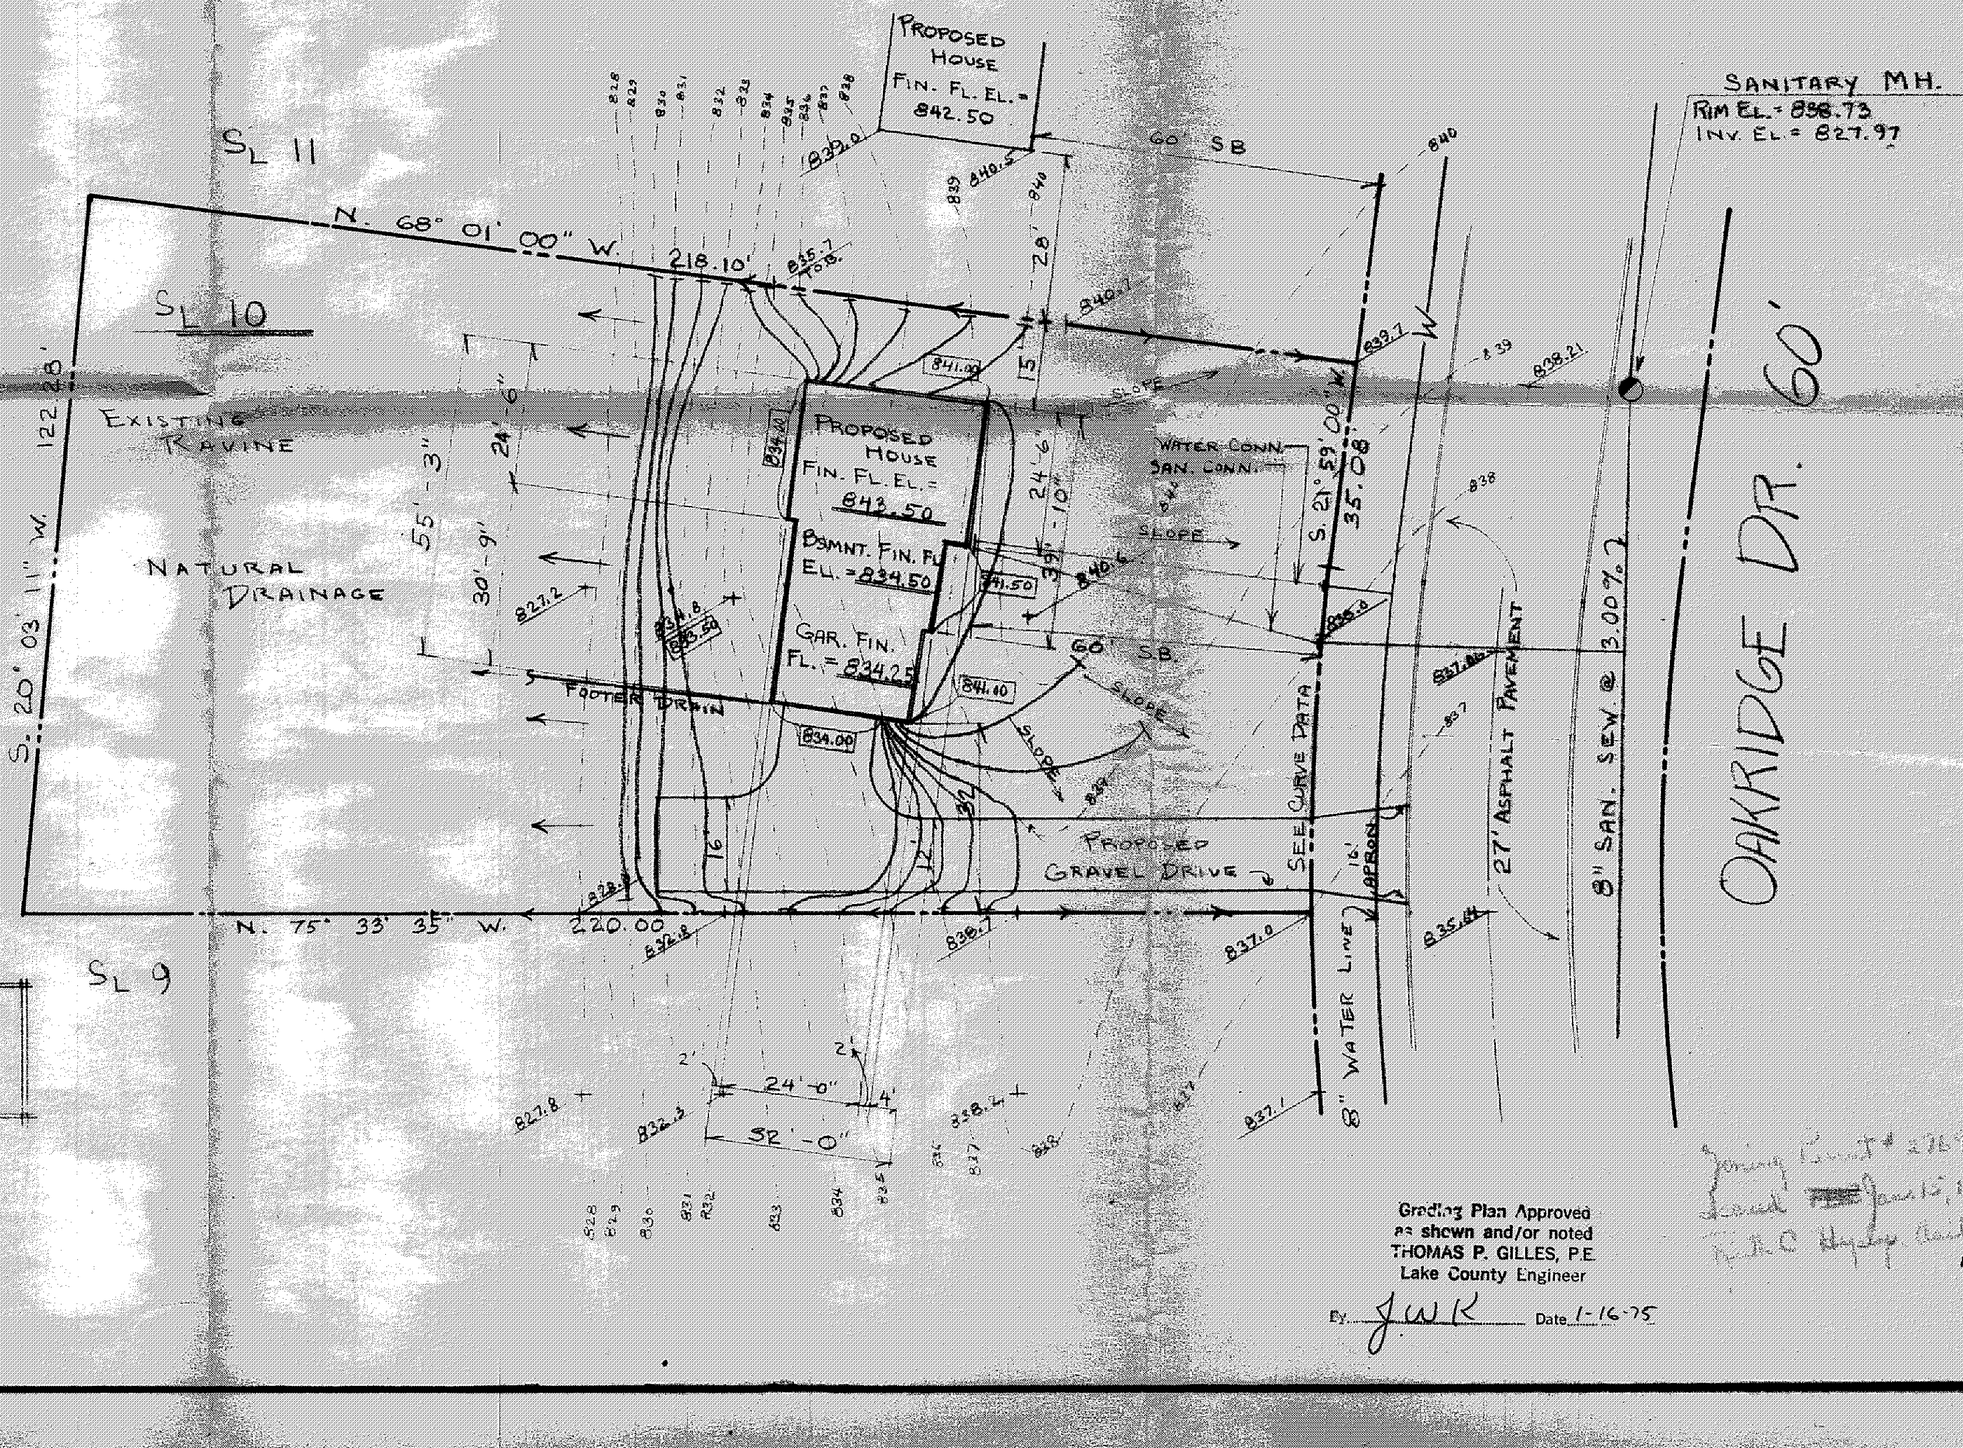

CURVE DATA:

RAD. = 443.89' ARC. = 58.44'

CH. = 58.39' N. 18° 12' 43" E.

Grading Plan Approved as shown and/or noted
THOMAS P. GILLES, P.E.
Lake County Engineer

By: J.W.K. Date 1-16-75