SITE PLAN FOR:

PEOPLES HOMES INC.
7000 GRANGER RD.
CLEVELAND, OHIO

BEING SUBLOT NO. 12 IN THE MORLEY HILLS ESTATES SUBD. LOCATED IN CONCORD TWP., OHIO

PREPARED BY:

WM. R. GRAY ASSOC. INC.
7547 MENTOR AVE.
MENTOR, OHIO

DATE: JULY 14, 1975 SCALE: 1" = 20'

CERTIFICATION:

I HEREBY CERTIFY THAT THE PLAT IS CORRECT TO THE BEST OF MY KNOWLEDGE.

By: Wm. R. Gray
WM. R. GRAY R.S. # 2752

STATE OF OHIO
WM. R. GRAY
2752
REGISTERED
PROFESSIONAL SURVEYOR
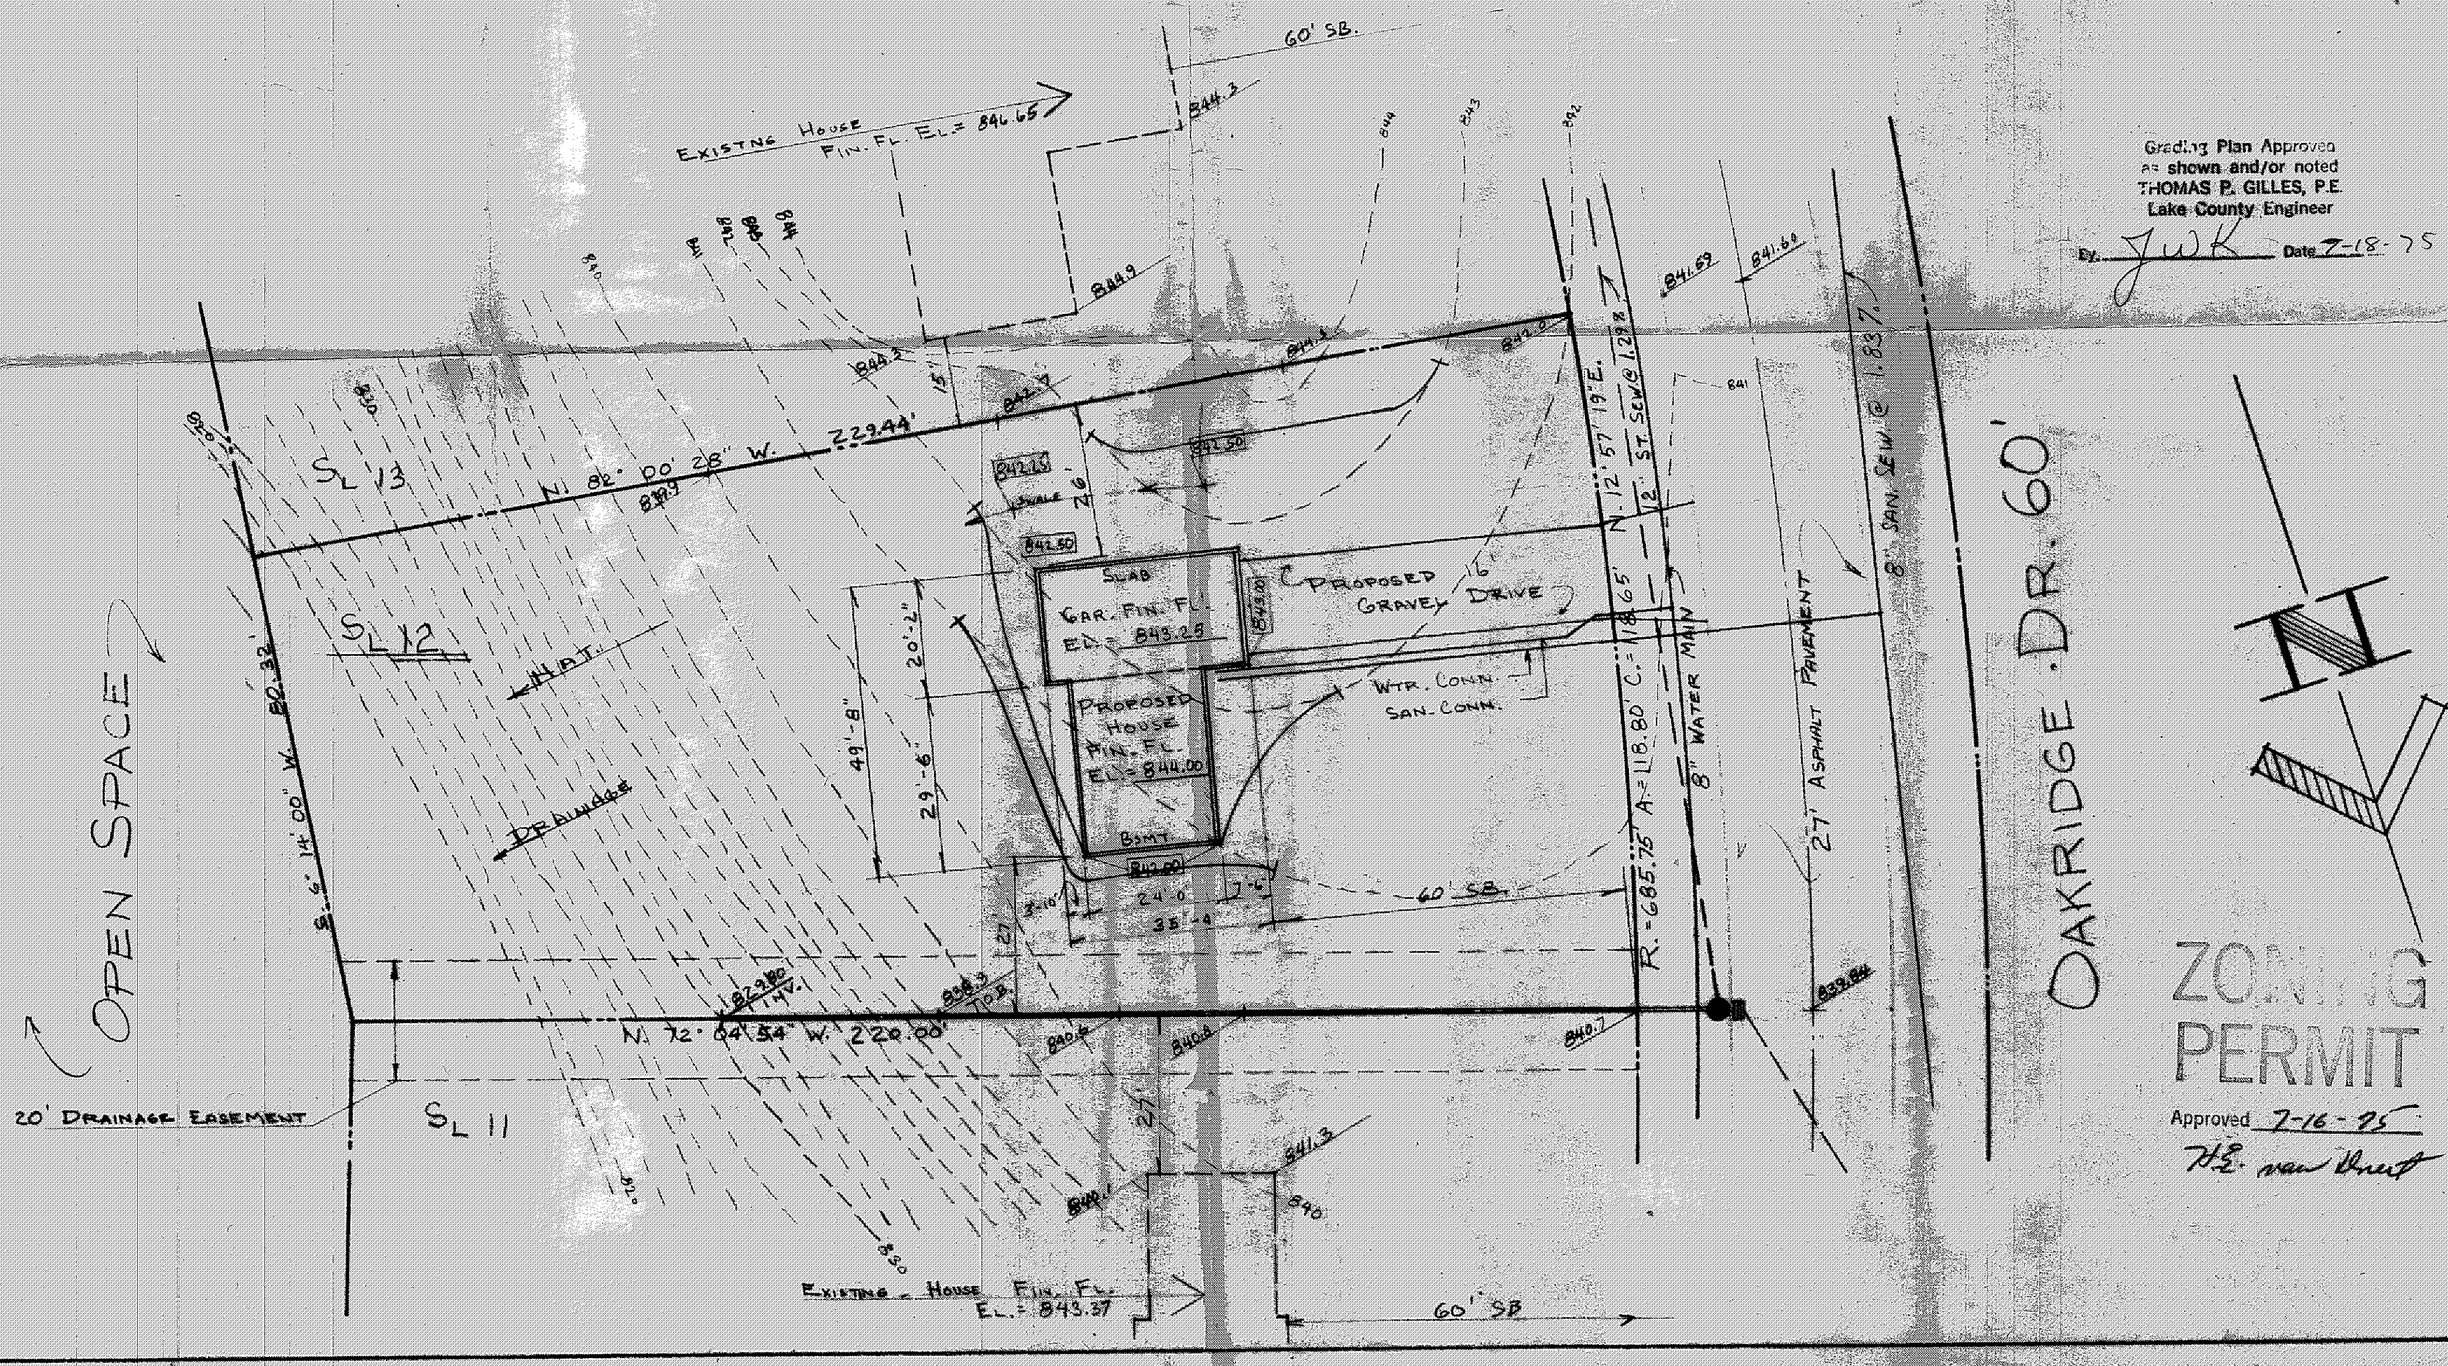
Grading Plan Approved as shown and/or noted
THOMAS P. GILLES, P.E.
Lake County Engineer
By: JWK Date 7-18-75