SITE PLAN FOR:

SHANDLE CONST.
8353 MENTOR AVE.
MENTOR, OHIO

BEING SUBLOT NO. 35 IN THE MORLEY HILLS ESTATES SUBDIVISION NO. 2 LOCATED IN CONCORD TWP., OHIO.

PREPARED BY

WM. R. GRAY ASSOC. INC.
7547 MENTOR AVE.
MENTOR, OHIO

DATE: JULY 28, 1975 SCALE: 1" = 20'
REVD. JULY 30, 1975

CERTIFICATION:

I HEREBY CERTIFY THAT THIS PLAT IS CORRECT TO THE BEST OF MY KNOWLEDGE.

By: Wm. R. Gray
WM. R. GRAY REG. SURV. #2

STATE OF OHIO
WM. R. GRAY
2752
REGISTERED SURVEYOR

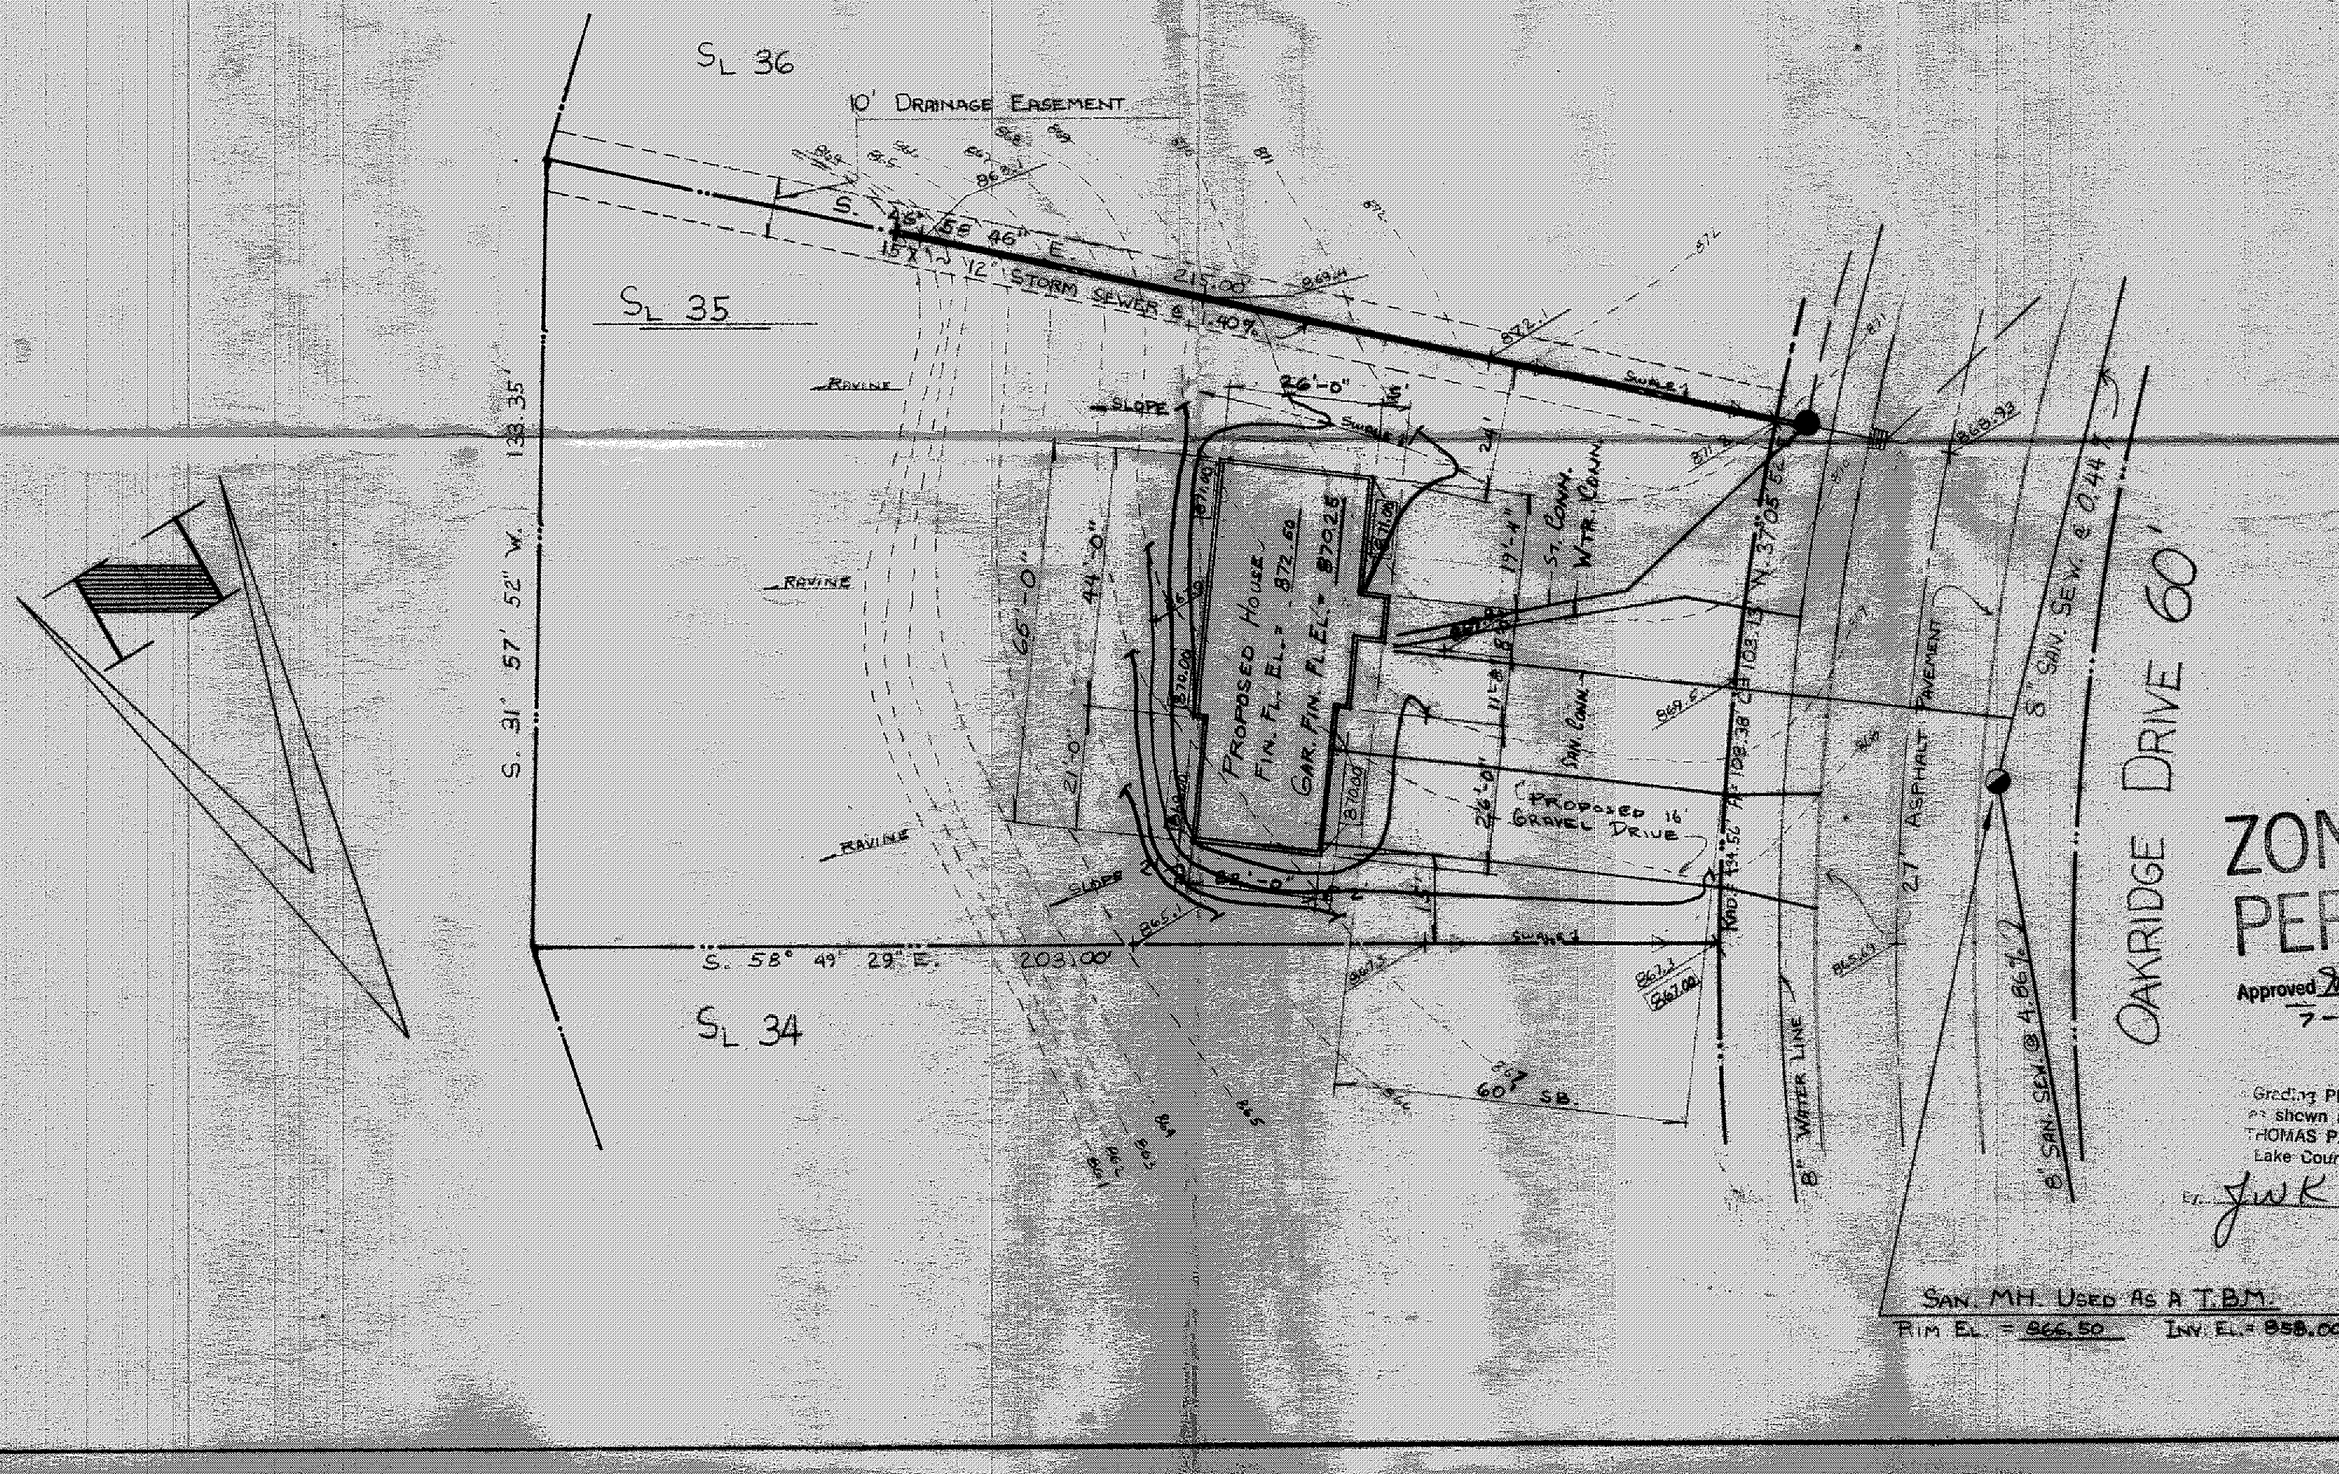

ZONING PERMIT
Approved
7-30-75

Grading Plan Approved as shown and/or noted
THOMAS P. GILLES, P.E.
Lake County Engineer
By: JWK Date 7-3

SAN. MH. USED AS A T.B.M.
RIM EL. = 866.50 INV. EL. = 858.00