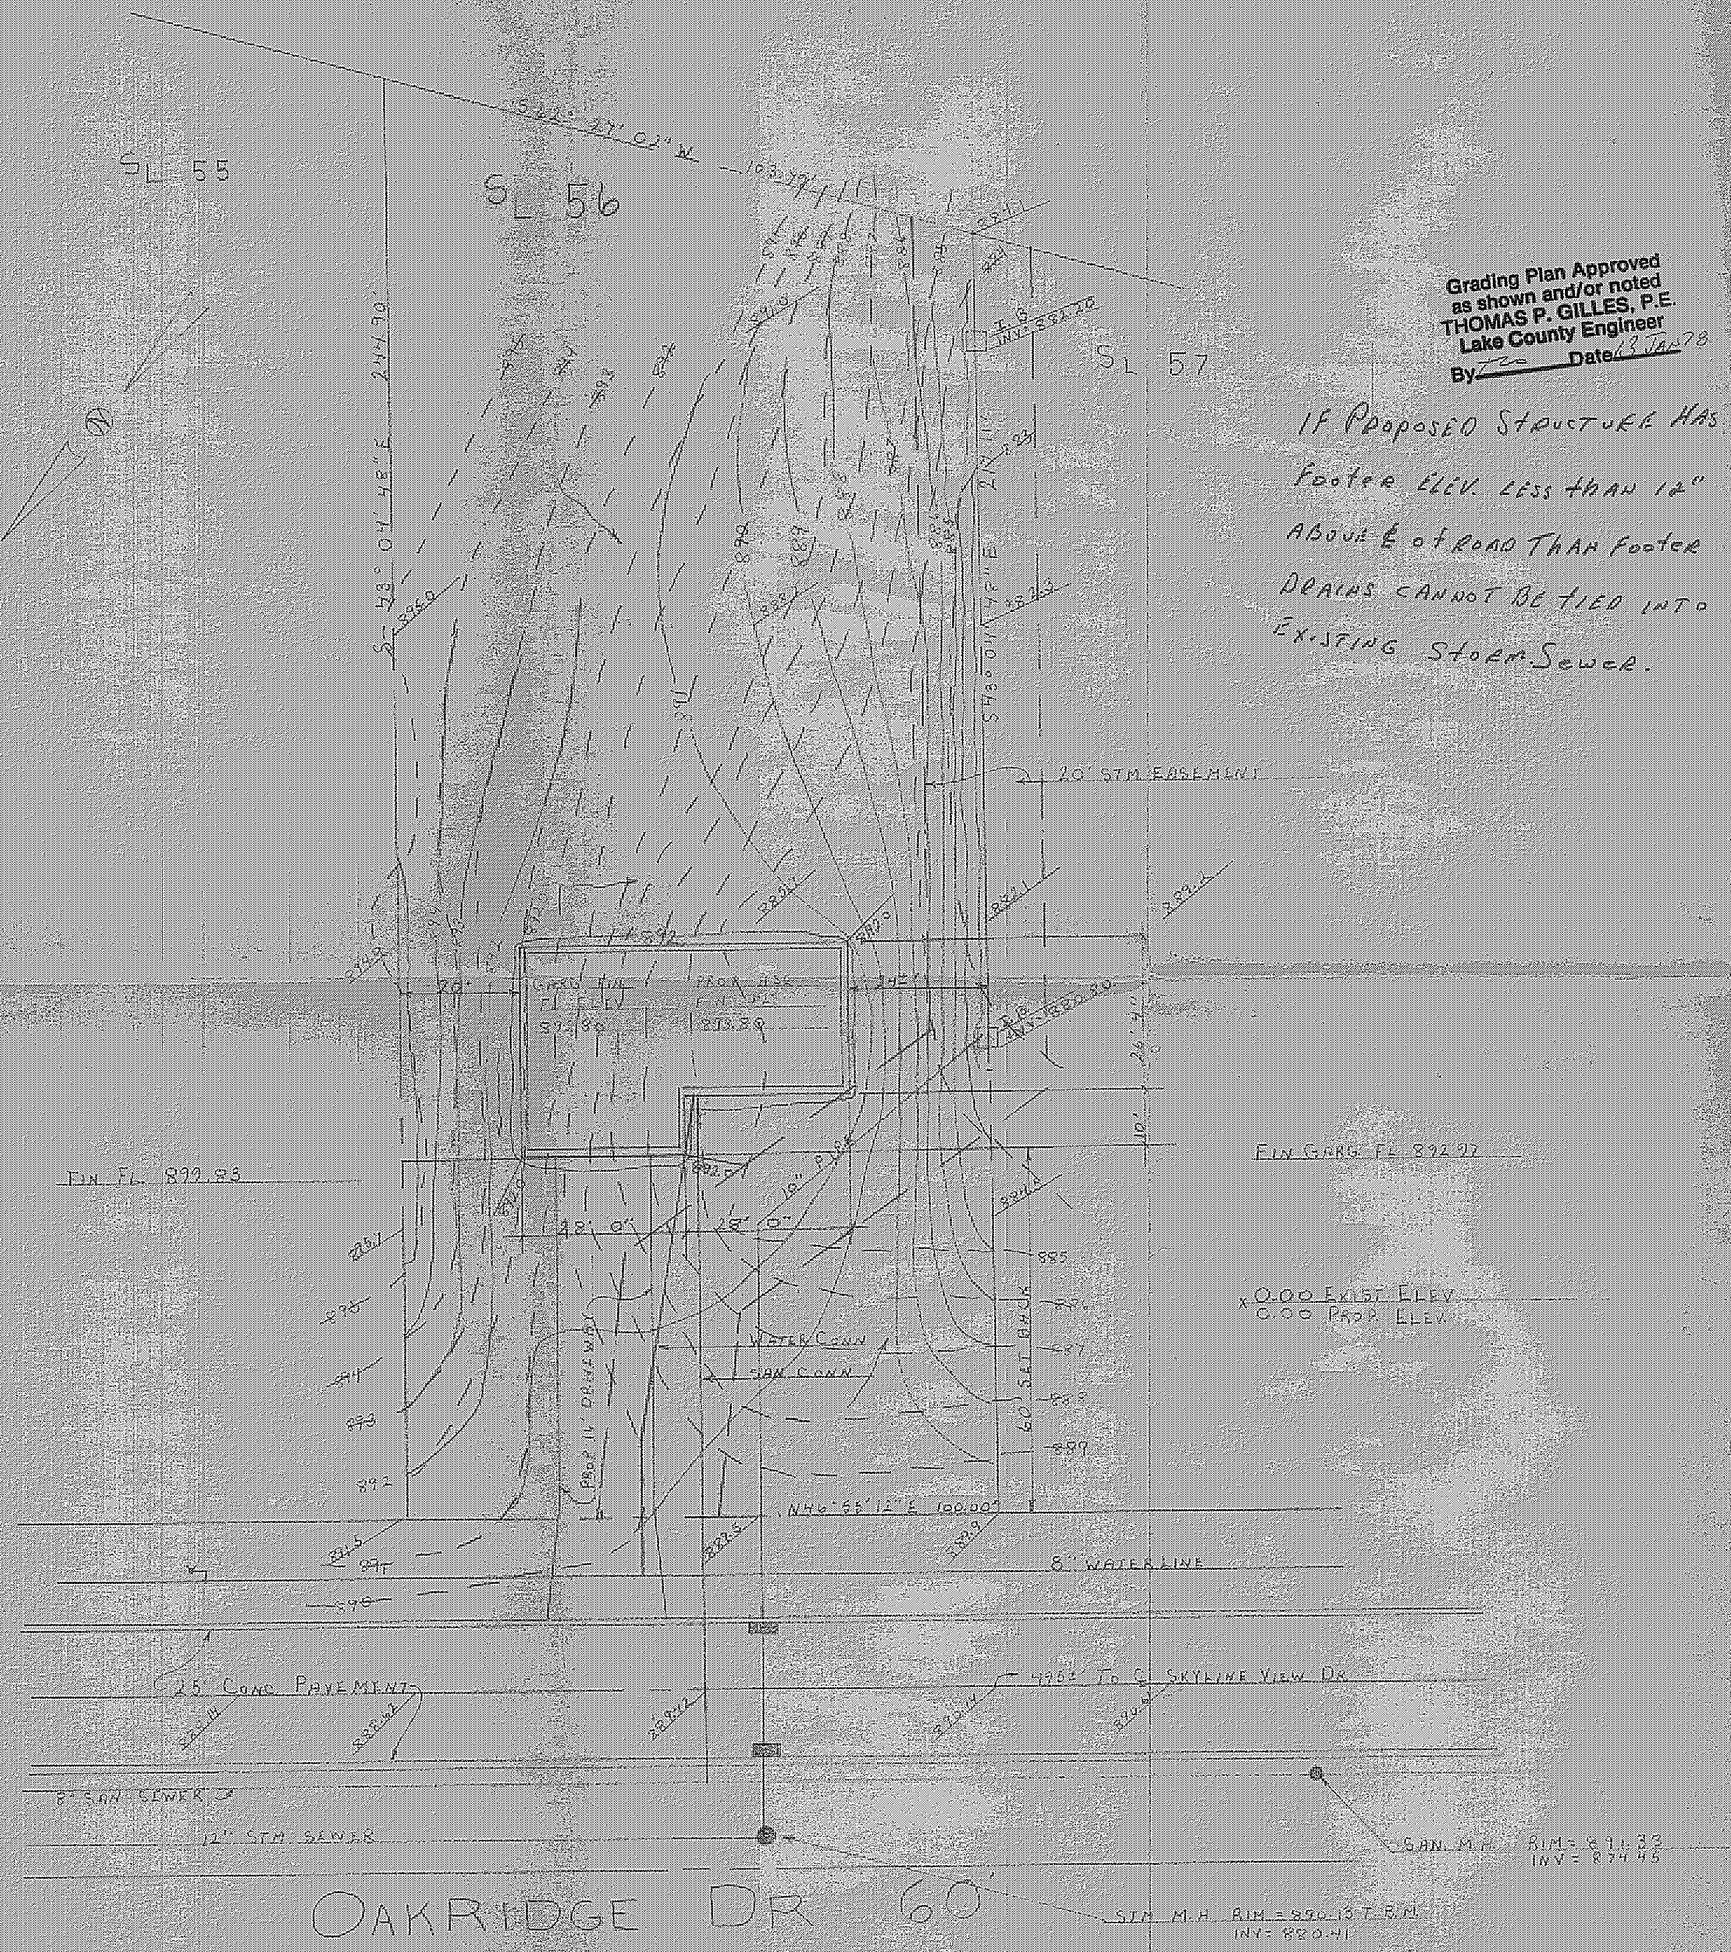

Grading Plan Approved
as shown and/or noted
THOMAS P. GILLES, P.E.
Lake County Engineer
By ___ Date 13 JAN 78

IF PROPOSED STRUCTURE HAS FOOTER ELEV. LESS THAN 12" ABOVE ℄ OF ROAD THAN FOOTER DRAINS CANNOT BE TIED INTO EXISTING STORM SEWER.

SITE PLAN FOR:

SHANDLE CONST
8353 MENTOR AVE
MENTOR, OHIO

BEING SUBLOT NO 56 IN THE MORLEY HILLS ESTATES SUBDIVISION NO. 2 LOCATED IN CONCORD TWP., OHIO

PREPARED BY:

WM. R. GRAY ASSOC. INC
7547 MENTOR AVE
MENTOR, OHIO
DATE: DEC 12, 1977 SCALE: 1" = 20'

CERTIFICATION:

I HEREBY CERTIFY THAT THIS PLAT IS CORRECT TO THE BEST OF MY KNOWLEDGE

By: Wm. R. Gray
WM. R. GRAY / REG. SURV # 2752

3504

ZONING PERMIT

7939 Oakridge

Approved 12-14-77
H. E. van Orsdel