House Change

3206

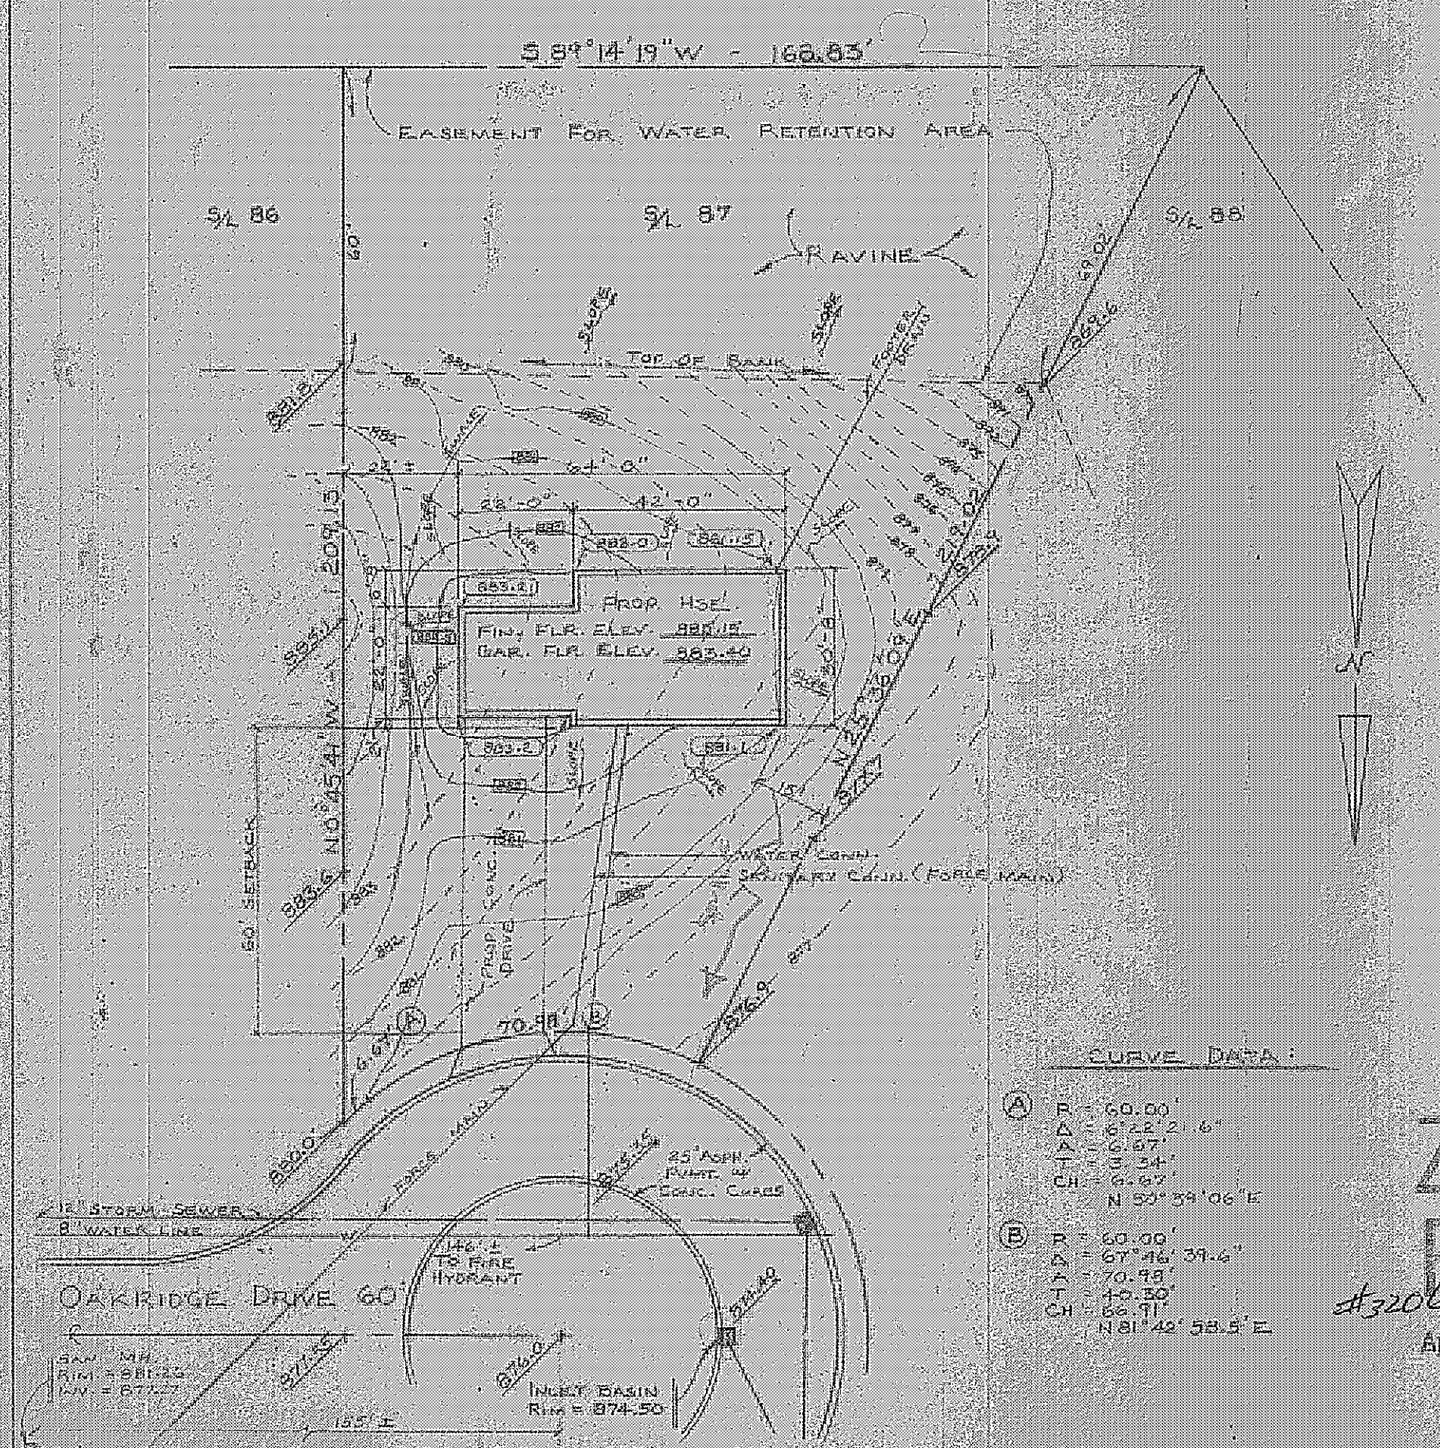

CURVE DATA :

(A) R = 60.00'
Δ = 6°22'21.6"
A = 6.67'
T = 3.34'
CH = 6.67'
N 52° 39' 06" E

(B) R = 60.00'
Δ = 67°16'39.4"
A = 70.98'
T = 40.30'
CH = 66.91'
N 81° 42' 58.5" E

SITE PLAN :

SHANDLE CONSTRUCTION
8353 MENTOR AVENUE
MENTOR, OHIO

BEING SUBLOT NUMBER 87 IN THE MORLEY HILLS ESTATES SUBDIVISION NO. 3A IN CONCORD TOWNSHIP, LAKE COUNTY, OHIO

PREPARED BY :

WM. R. GRAY ASSOC. INC.
7547 MENTOR AVENUE
MENTOR, OHIO

DATE : MARCH 17, 1977 SCALE : 1" = 30'
REV. : APRIL 1, 1977 / REV. : APRIL 28, 1977

CERTIFICATION :

I HEREBY CERTIFY THAT THIS PLAT IS CORRECT TO THE BEST OF MY KNOWLEDGE

BY : Wm R Gray

WM. R. GRAY REG. SURV. #2752

ZONING PERMIT
#3206
Approved 5-4-77
J. Evan Wiest

STATE OF OHIO
WM. R. GRAY
2752
REGISTERED SURVEYOR

Grading Plan Approved as shown and/or noted
THOMAS P. GILLES, P.E.
Lake County Engineer
By DJ Date 5/5/77