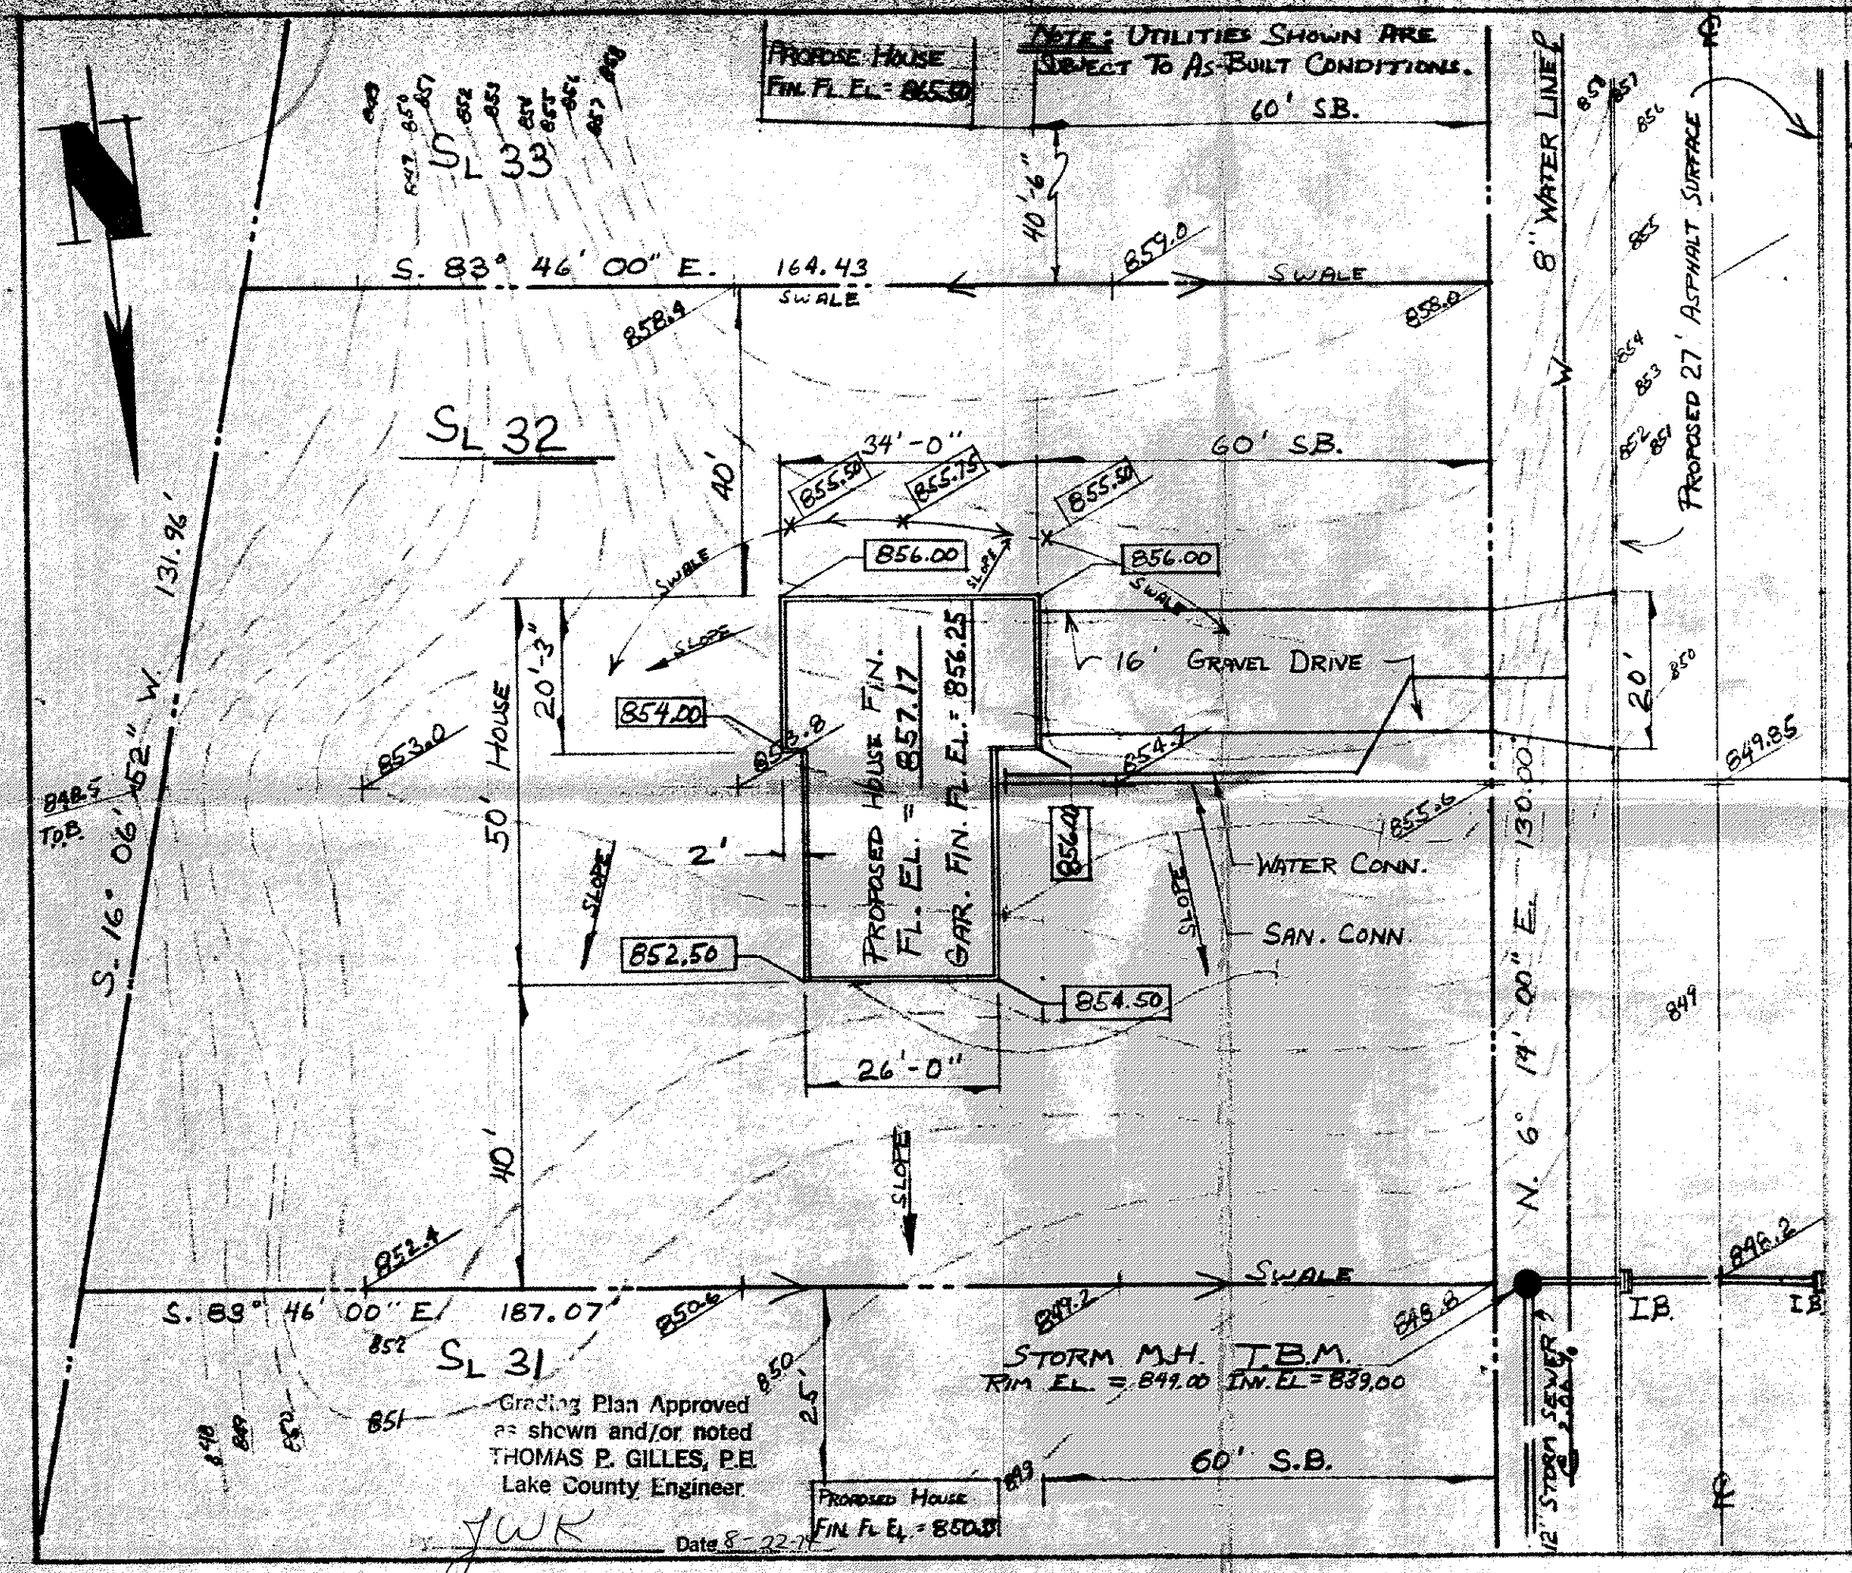

Grading Plan Approved as shown and/or noted
THOMAS P. GILLES, P.E.
Lake County Engineer
JWK
Date 8-22-74

SITE PLAN FOR:

SHANDLE CONST. CO.
8353 MENTOR AVE.
MENTOR, OHIO

BEING SUBLOT NO. 32 IN MORLEY HILLS ESTATES SUBDIVISION NO. 2 IN CONCORD TWP. OHIO.

PREPARED BY:

WM. R. GRAY ASSOC.
7547 MENTOR AVE.
MENTOR, OHIO

DATE: AUG. 12, 1974
SCALE: 1" = 20'

CERTIFICATION

I HEREBY CERTIFY THAT THIS PLAT IS CORRECT TO THE BEST OF MY KNOWLEDGE.

By: Wm R Gray
WM. R. GRAY REG. SURV. # 2752

Zoning Permit # 2719
issued 8-21-74
H.E. [illegible]