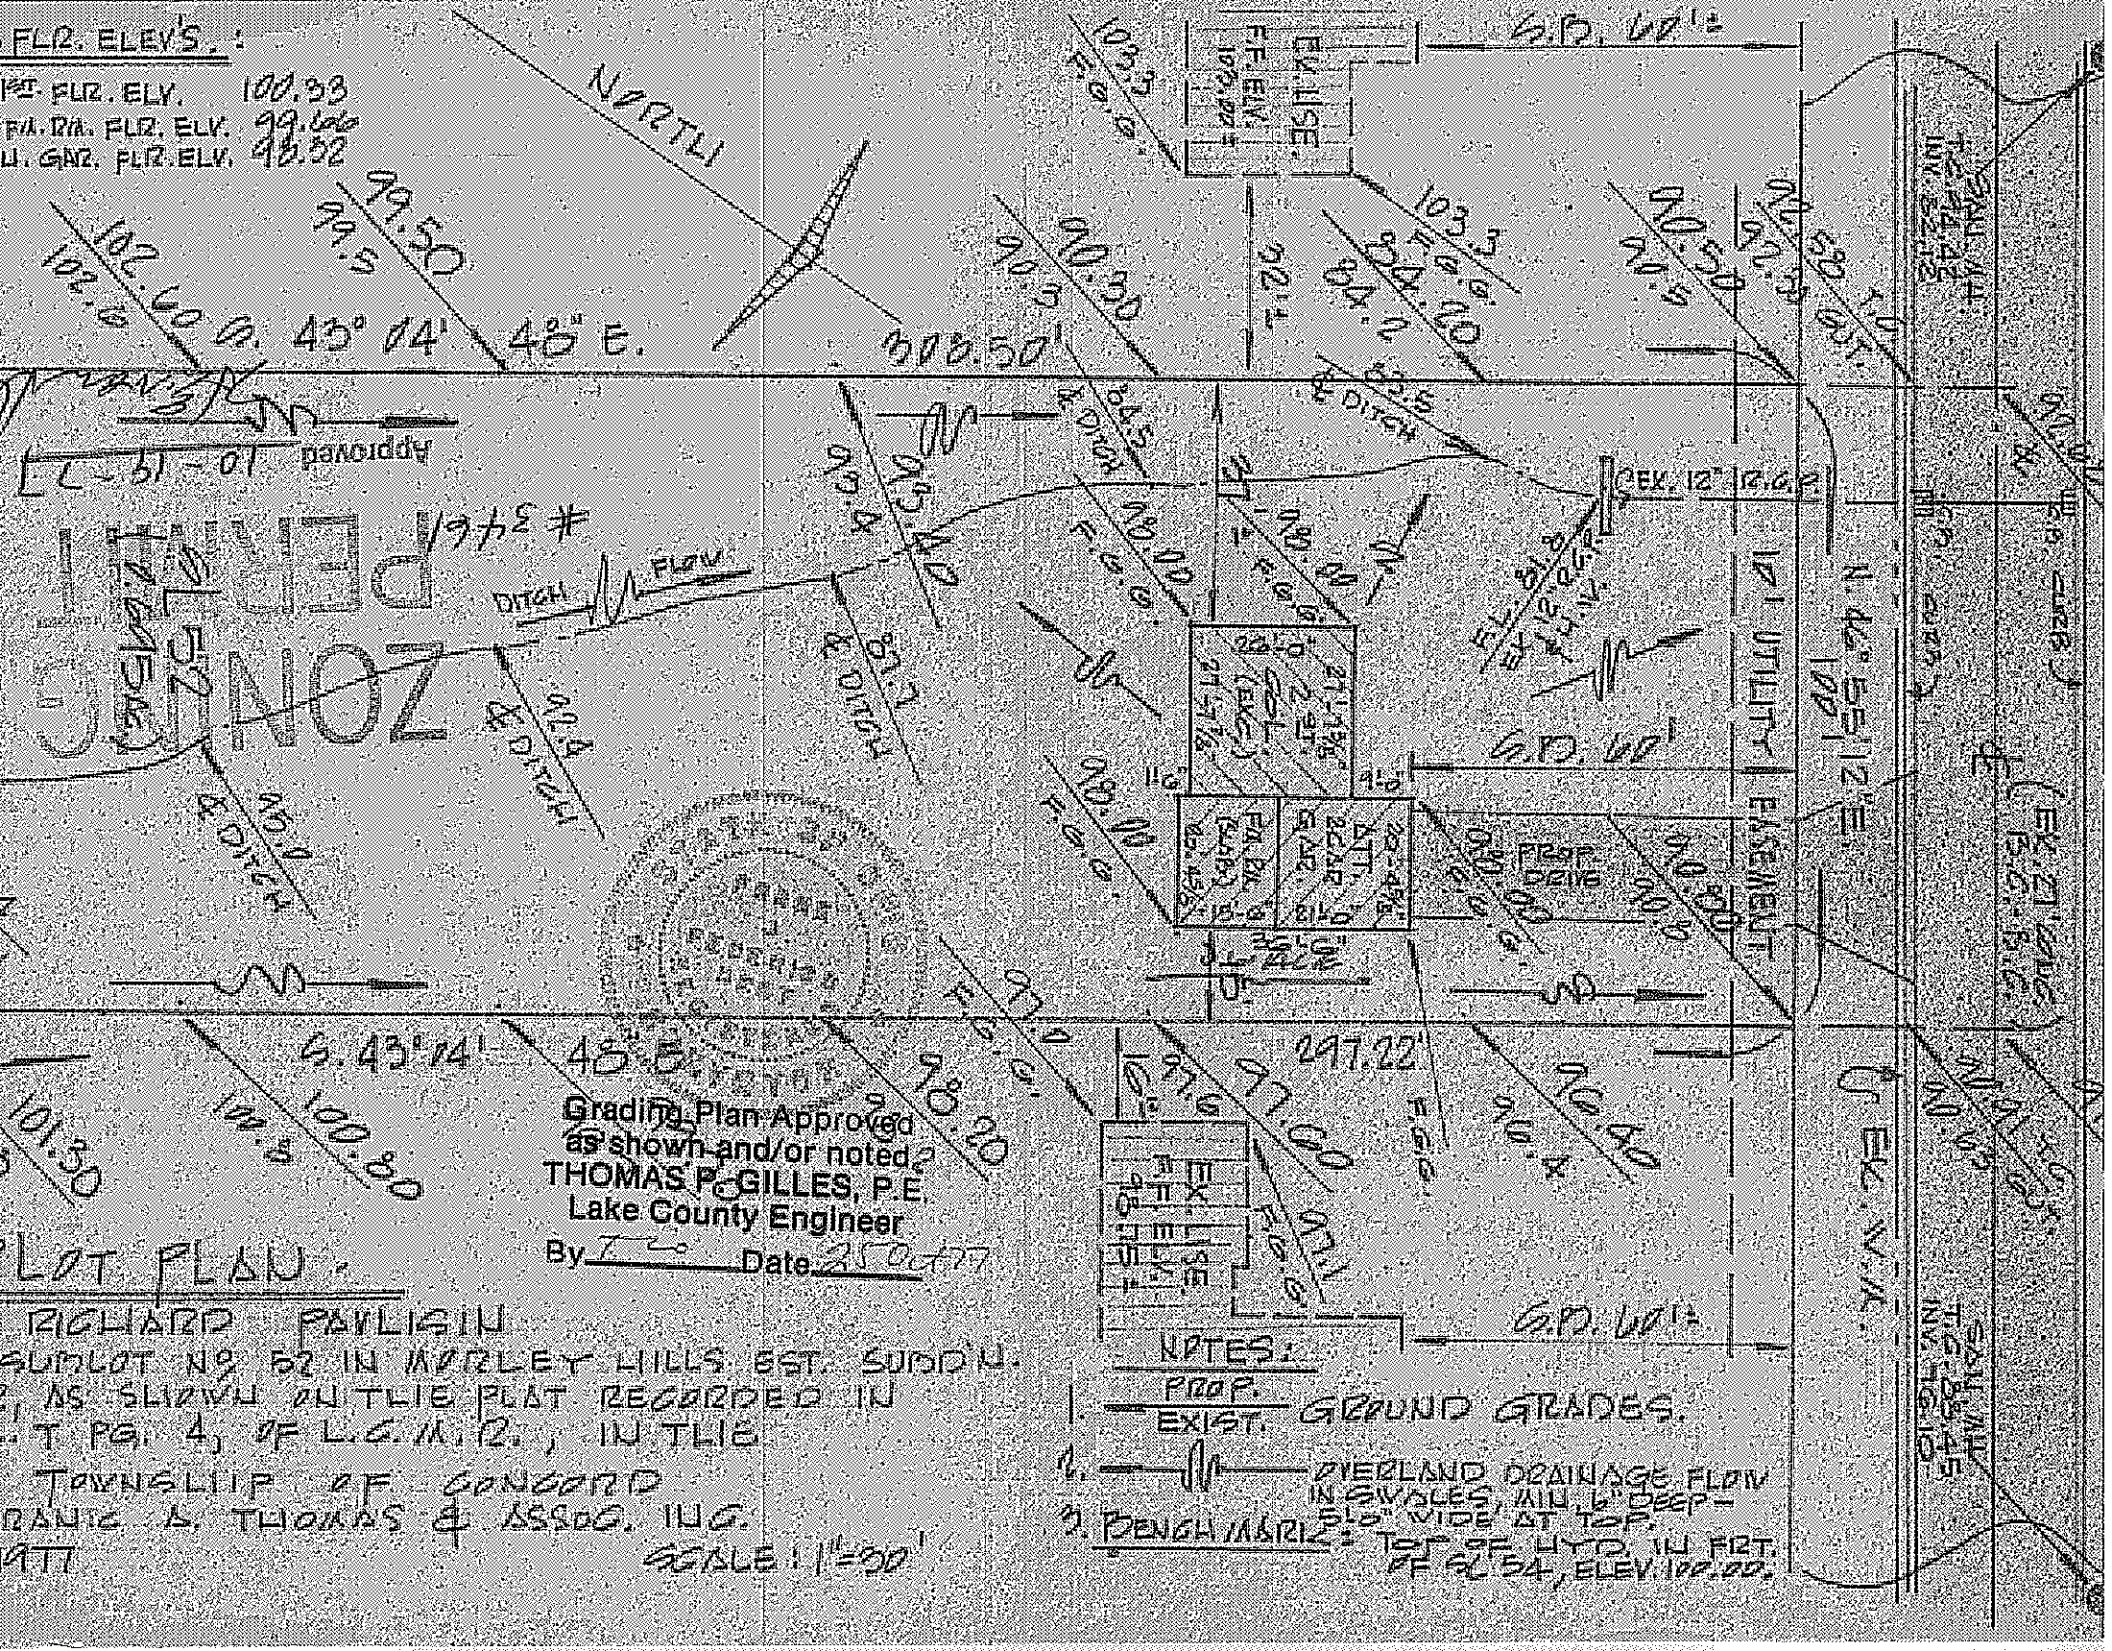
FLR. ELEV'S.:
1ST. FLR. ELV. 100.33
FM. RM. FLR. ELV. 99.66
LL. GAR. FLR. ELV. 98.52
NORTH
S. 43° 04' 48" E.
308.50'
S.B. 60'±
EX. LISE.
EX. 12" R.C.P.
DITCH
FLOW
PROP. DRIVE
UTILITY EASEMENT
EX. W.M.
S. 43° 04' 48" E.
297.22'
Approved
PERMIT
ZONING
Grading Plan Approved
as shown and/or noted
THOMAS P. GILLES, P.E.
Lake County Engineer
By
Date 25 Oct 77
PLOT PLAN.
RICHARD PAVLISIN
SUBLOT No 52 IN MORLEY HILLS EST. SUBD'N.
AS SHOWN ON THE PLAT RECORDED IN
T PG. 4, OF L.C.M.R., IN THE
TOWNSHIP OF CONCORD
RANK A. THOMAS & ASSOC. INC.
1977
SCALE: 1"=30'
NOTES:
1. PROP. / EXIST. GROUND GRADES.
2. OVERLAND DRAINAGE FLOW IN SWALES, MIN. 6" DEEP - 5'-0" WIDE AT TOP.
3. BENCH MARK: TOP OF HYD. IN FRT. OF SL 54, ELEV. 100.00.