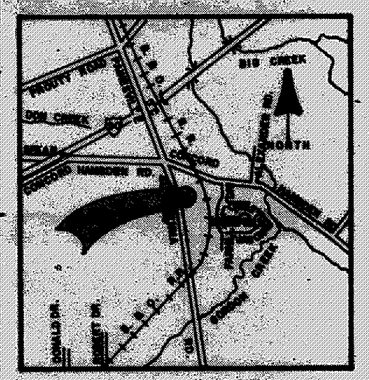

VICINITY MAP

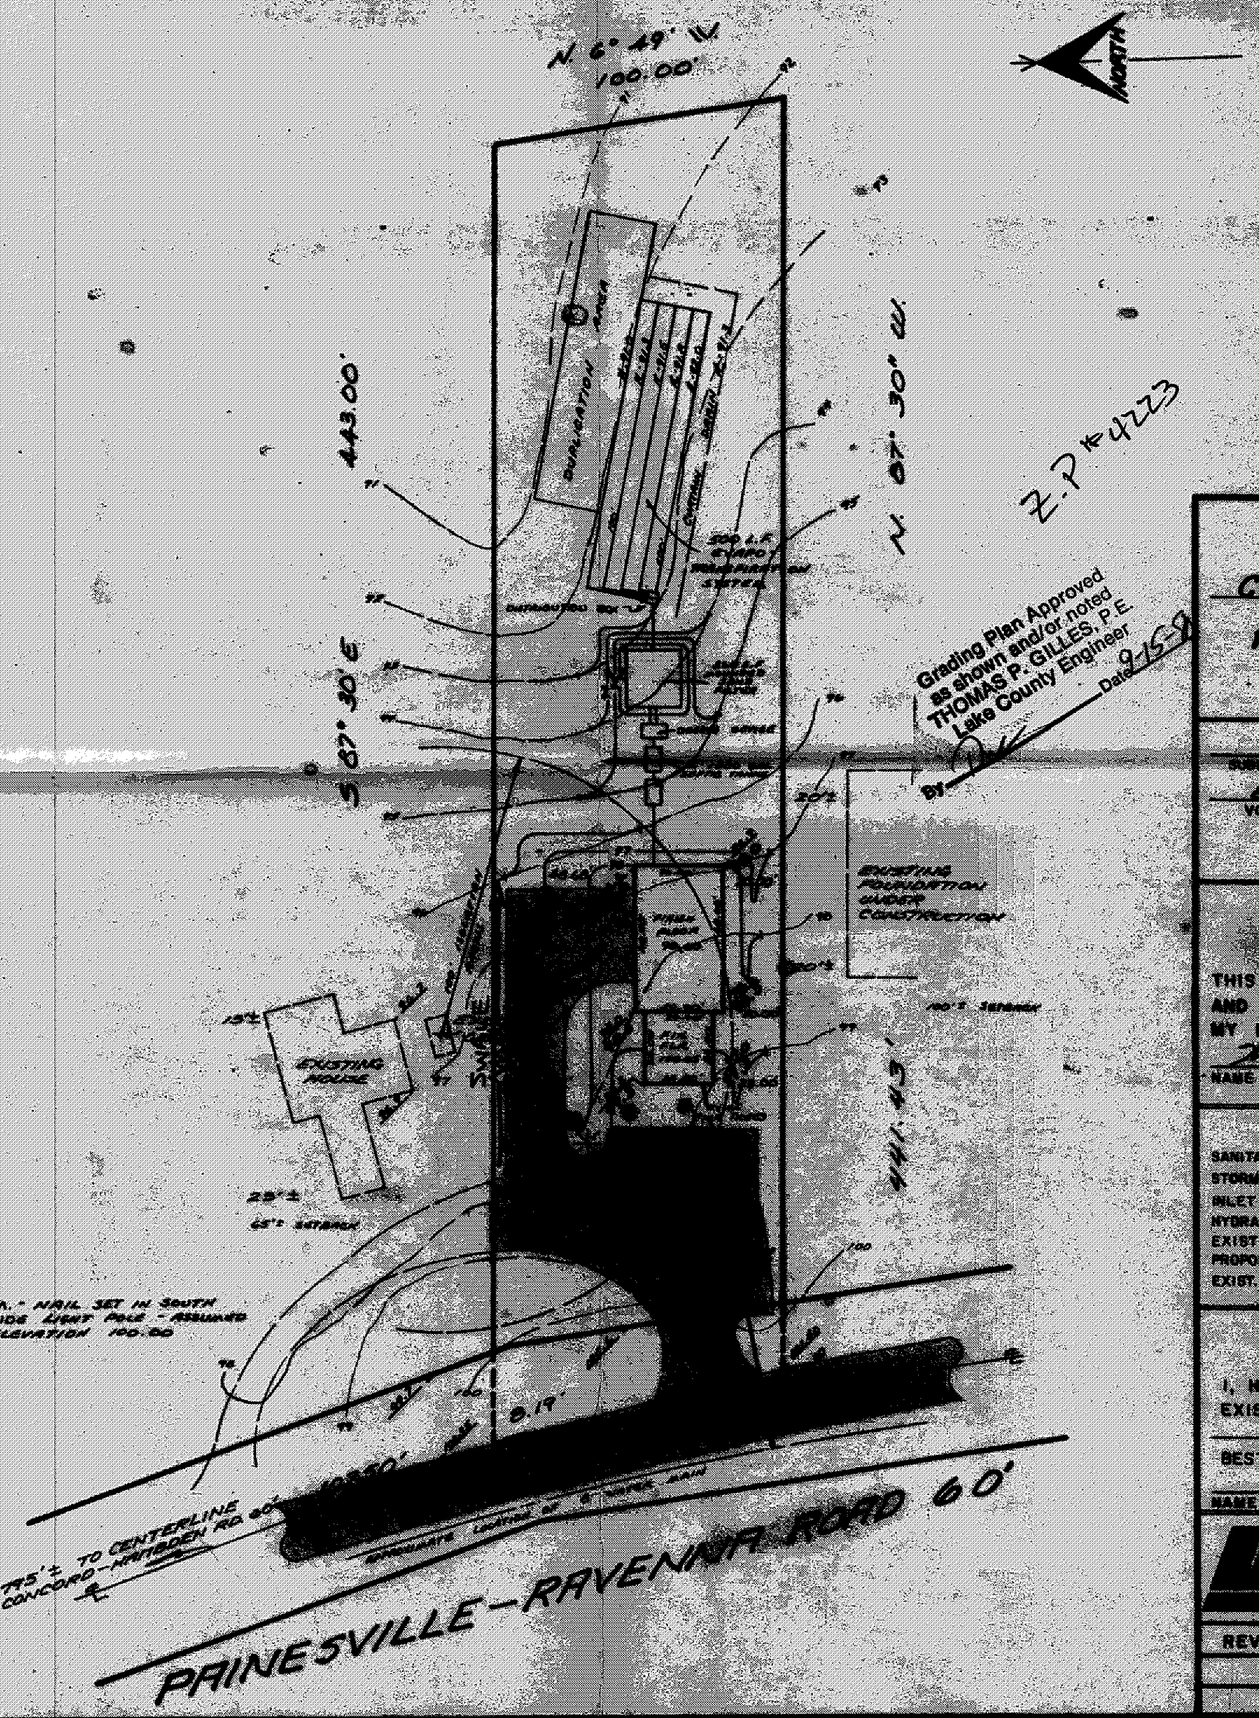

Z.P. #4223

Grading Plan Approved as shown and/or noted
THOMAS P. GILLES, P.E.
Lake County Engineer
By
Date 9-15-8

SITE PLAN

CONCORD LAKE COUNTY, OHIO

for: JAMES DOMINICK
CLIENT OWNER

ADDRESS STREET CITY ZIP

SUBDIVISION	SUBLOT NO.	LOT	TRACT
		No 10 No 4	No 1 No 2

VOLUME	PAGE	STREET
871	690	PAINESVILLE - RAVENNA

08A-005A-00-009
PERMANENT PARCEL NO.

CERTIFICATION

THIS PLAT WAS PREPARED BY ME, AND IS CORRECT TO THE BEST OF MY KNOWLEDGE.

William J. Haas 4793
NAME REGISTRATION NO.

STATE OF OHIO WILLIAM J. HAAS 4793 REGISTERED SURVEYOR

LEGEND

SANITARY MANHOLE
STORM MANHOLE
INLET OR CATCH BASIN
HYDRANT
EXISTING CONTOURS
PROPOSED CONTOURS
EXIST. ELEV. 100.00 / 100.00 PROP. ELEV.
WATER VALVE (GAS)
WATER METER (GAS)
AS BUILT ELEVATION (1000)
INDICATES DIRECTION OF SURFACE DRAINAGE

"AS BUILT" CERTIFICATION

I, HEREBY CERTIFY THAT THE CIRCLED GRADES ARE EXISTING FINISHED GRADES CHECKED IN THE FIELD ON _____, 19__ AND ARE CORRECT TO THE BEST OF MY KNOWLEDGE.

NAME REGISTRATION NO.

WRG PLAN PREPARED BY WM. R. GRAY, ASSOCIATES, INC.

REVISIONS	DRAWN BY: RK	SCALE: 1" = 40'	PHONE NO. 946-1616
	CHECKED BY:	DATE: 14 MAY 80	DRAWING NO. 1/2