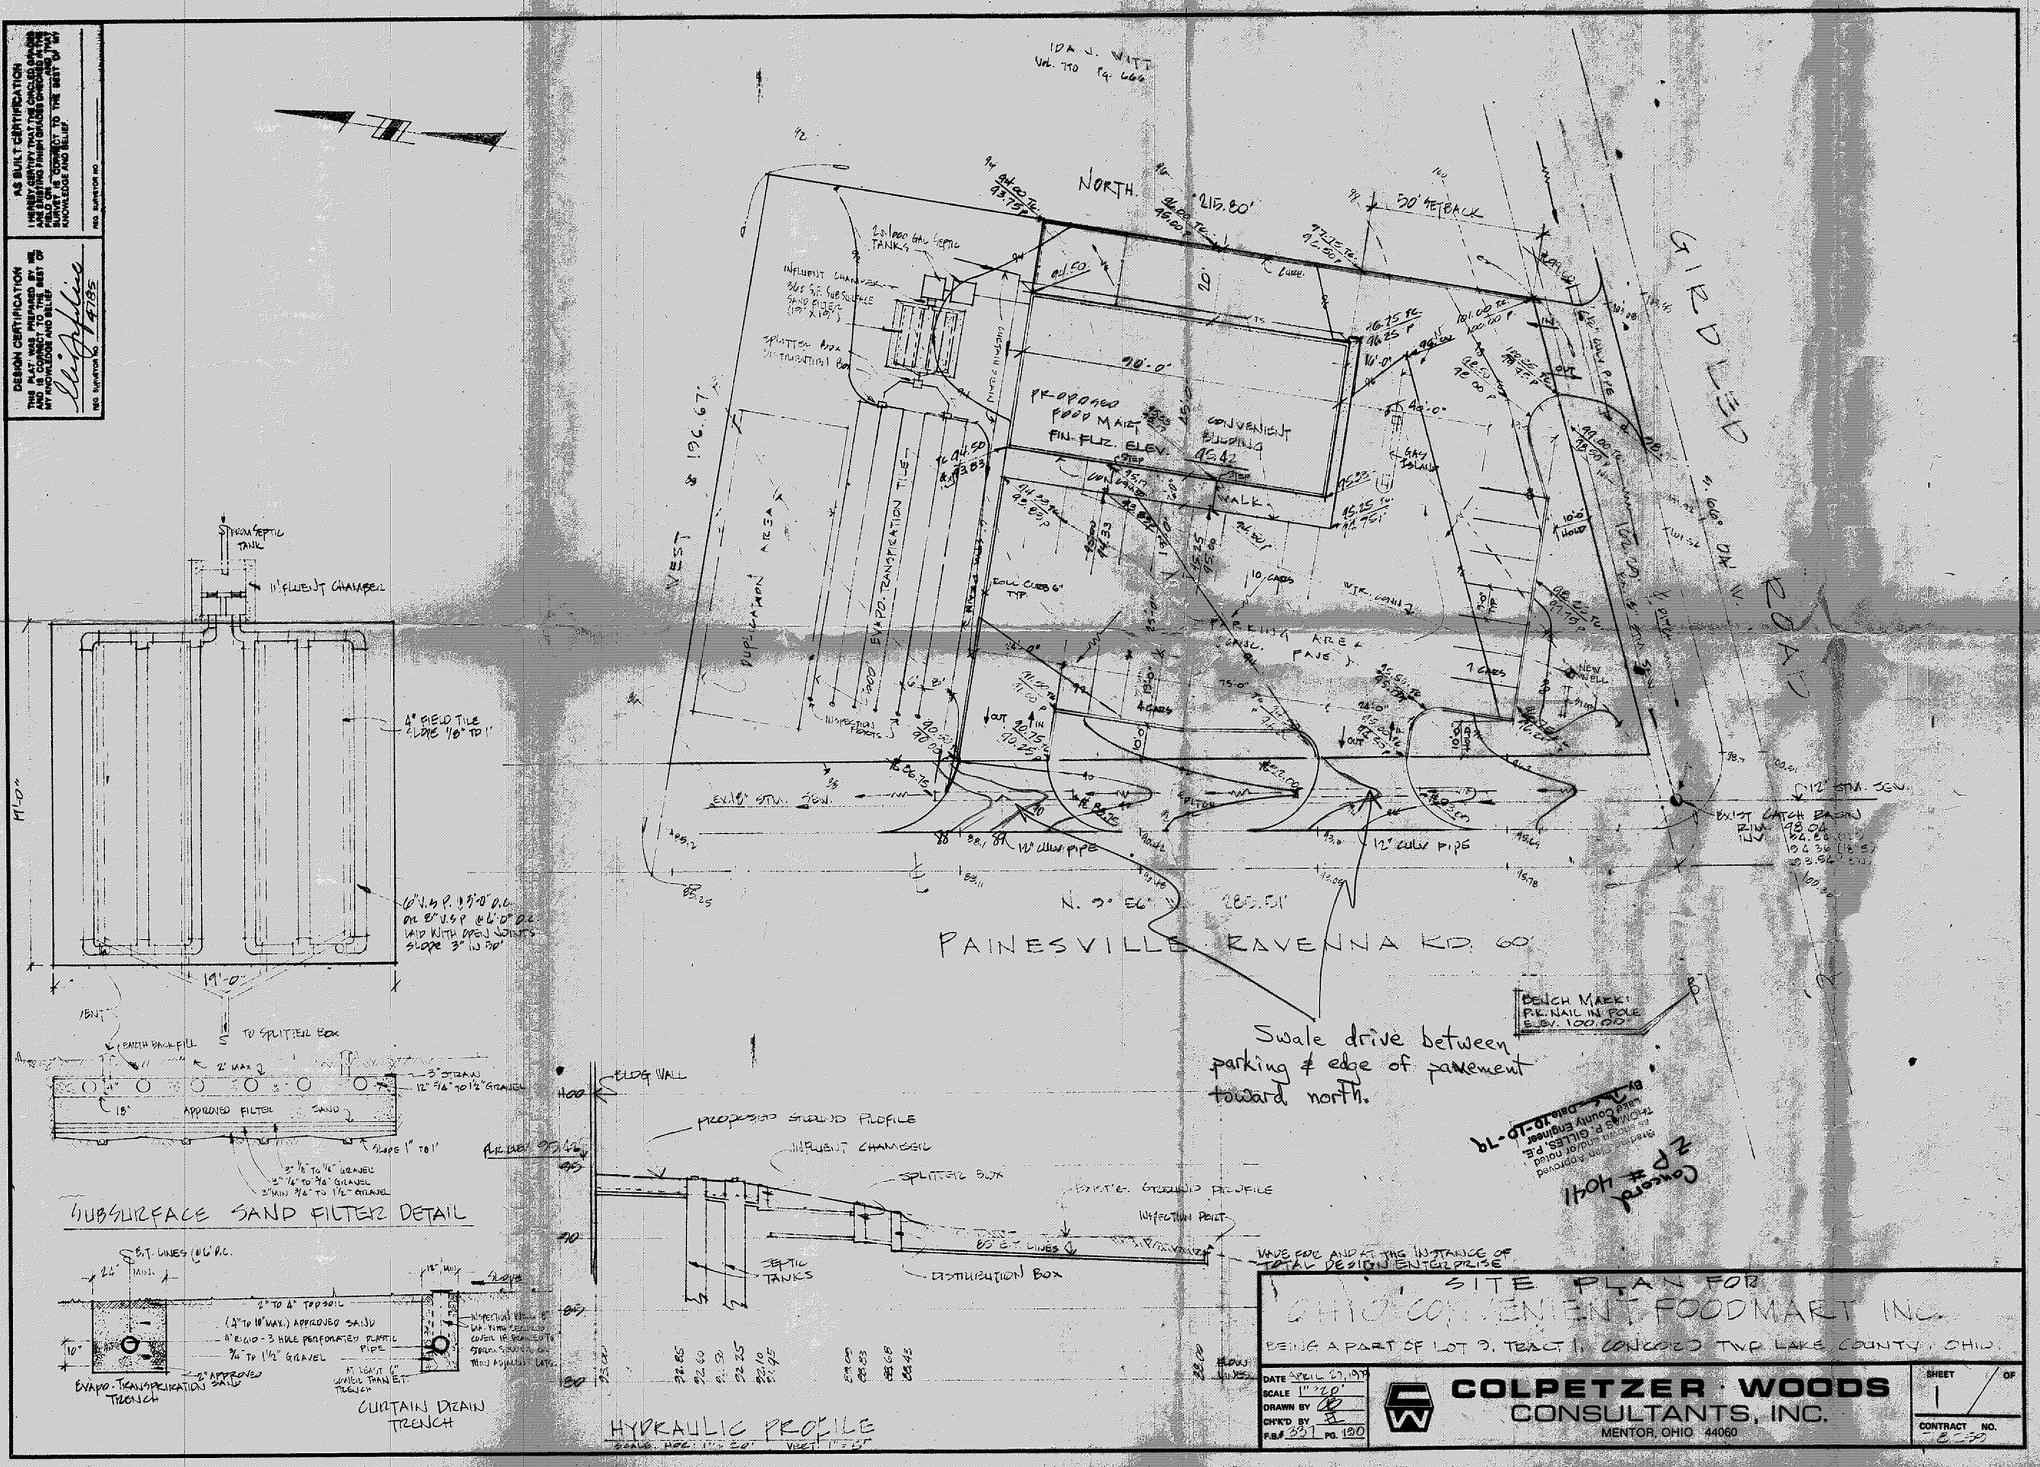

DESIGN CERTIFICATION
THIS PLAT WAS PREPARED BY ME AND IS CORRECT TO THE BEST OF MY KNOWLEDGE AND BELIEF.
REG. SURVEYOR NO. 4785
AS BUILT CERTIFICATION
I HEREBY CERTIFY THAT THE CIRCLED GRADES AND ERECTED FINISH GRADES SHOWN IN THE FIELD ON _____ AND THAT SURVEY IS CORRECT TO THE BEST OF MY KNOWLEDGE AND BELIEF.
REG. SURVEYOR NO.
IDA J. WITT
Vol. 790 Pg. 666
NORTH 215.80'
50' SETBACK
GIRDLED ROAD
PROPOSED FOOD MART FIN. FLR. ELEV. 95.42
CONVENIENT BUILDING
WALK
PARKING AREA
DUPLICATION AREA
EVAPO-TRANSPIRATION TILE
INFLUENT CHAMBER
SPLITTER BOX
DISTRIBUTION BOX
12" CULV. PIPE
EXIST. CATCH BASIN
N. 9° 56' W. 285.51'
PAINESVILLE RAVENNA RD. 60'
BENCH MARK: P.K. NAIL IN POLE ELEV. 100.00'
Swale drive between parking & edge of pavement toward north.
Concord ZP # 4041
Grading Plan Approved
THOMAS P. GILLES, P.E.
Lake County Engineer
By
Date 10-10-79
SUBSURFACE SAND FILTER DETAIL
APPROVED FILTER SAND
TO SPLITTER BOX
EVAPO-TRANSPIRATION TRENCH
CURTAIN DRAIN TRENCH
HYDRAULIC PROFILE
BLDG. WALL
PROPOSED GROUND PROFILE
INFLUENT CHAMBER
SPLITTER BOX
EXIST'G. GROUND PROFILE
INSPECTION PORT
SEPTIC TANKS
DISTRIBUTION BOX
MADE FOR AND AT THE INSTANCE OF TOTAL DESIGN ENTERPRISE
SITE PLAN FOR
OHIO CONVENIENT FOODMART INC.
BEING A PART OF LOT 9, TRACT 1, CONCORD TWP. LAKE COUNTY, OHIO.
DATE APRIL 27, 1979
SCALE 1" = 20'
DRAWN BY
CH'K'D BY
F.B.# 337 PG. 130
COLPETZER · WOODS
CONSULTANTS, INC.
MENTOR, OHIO 44060
SHEET 1 OF
CONTRACT NO.