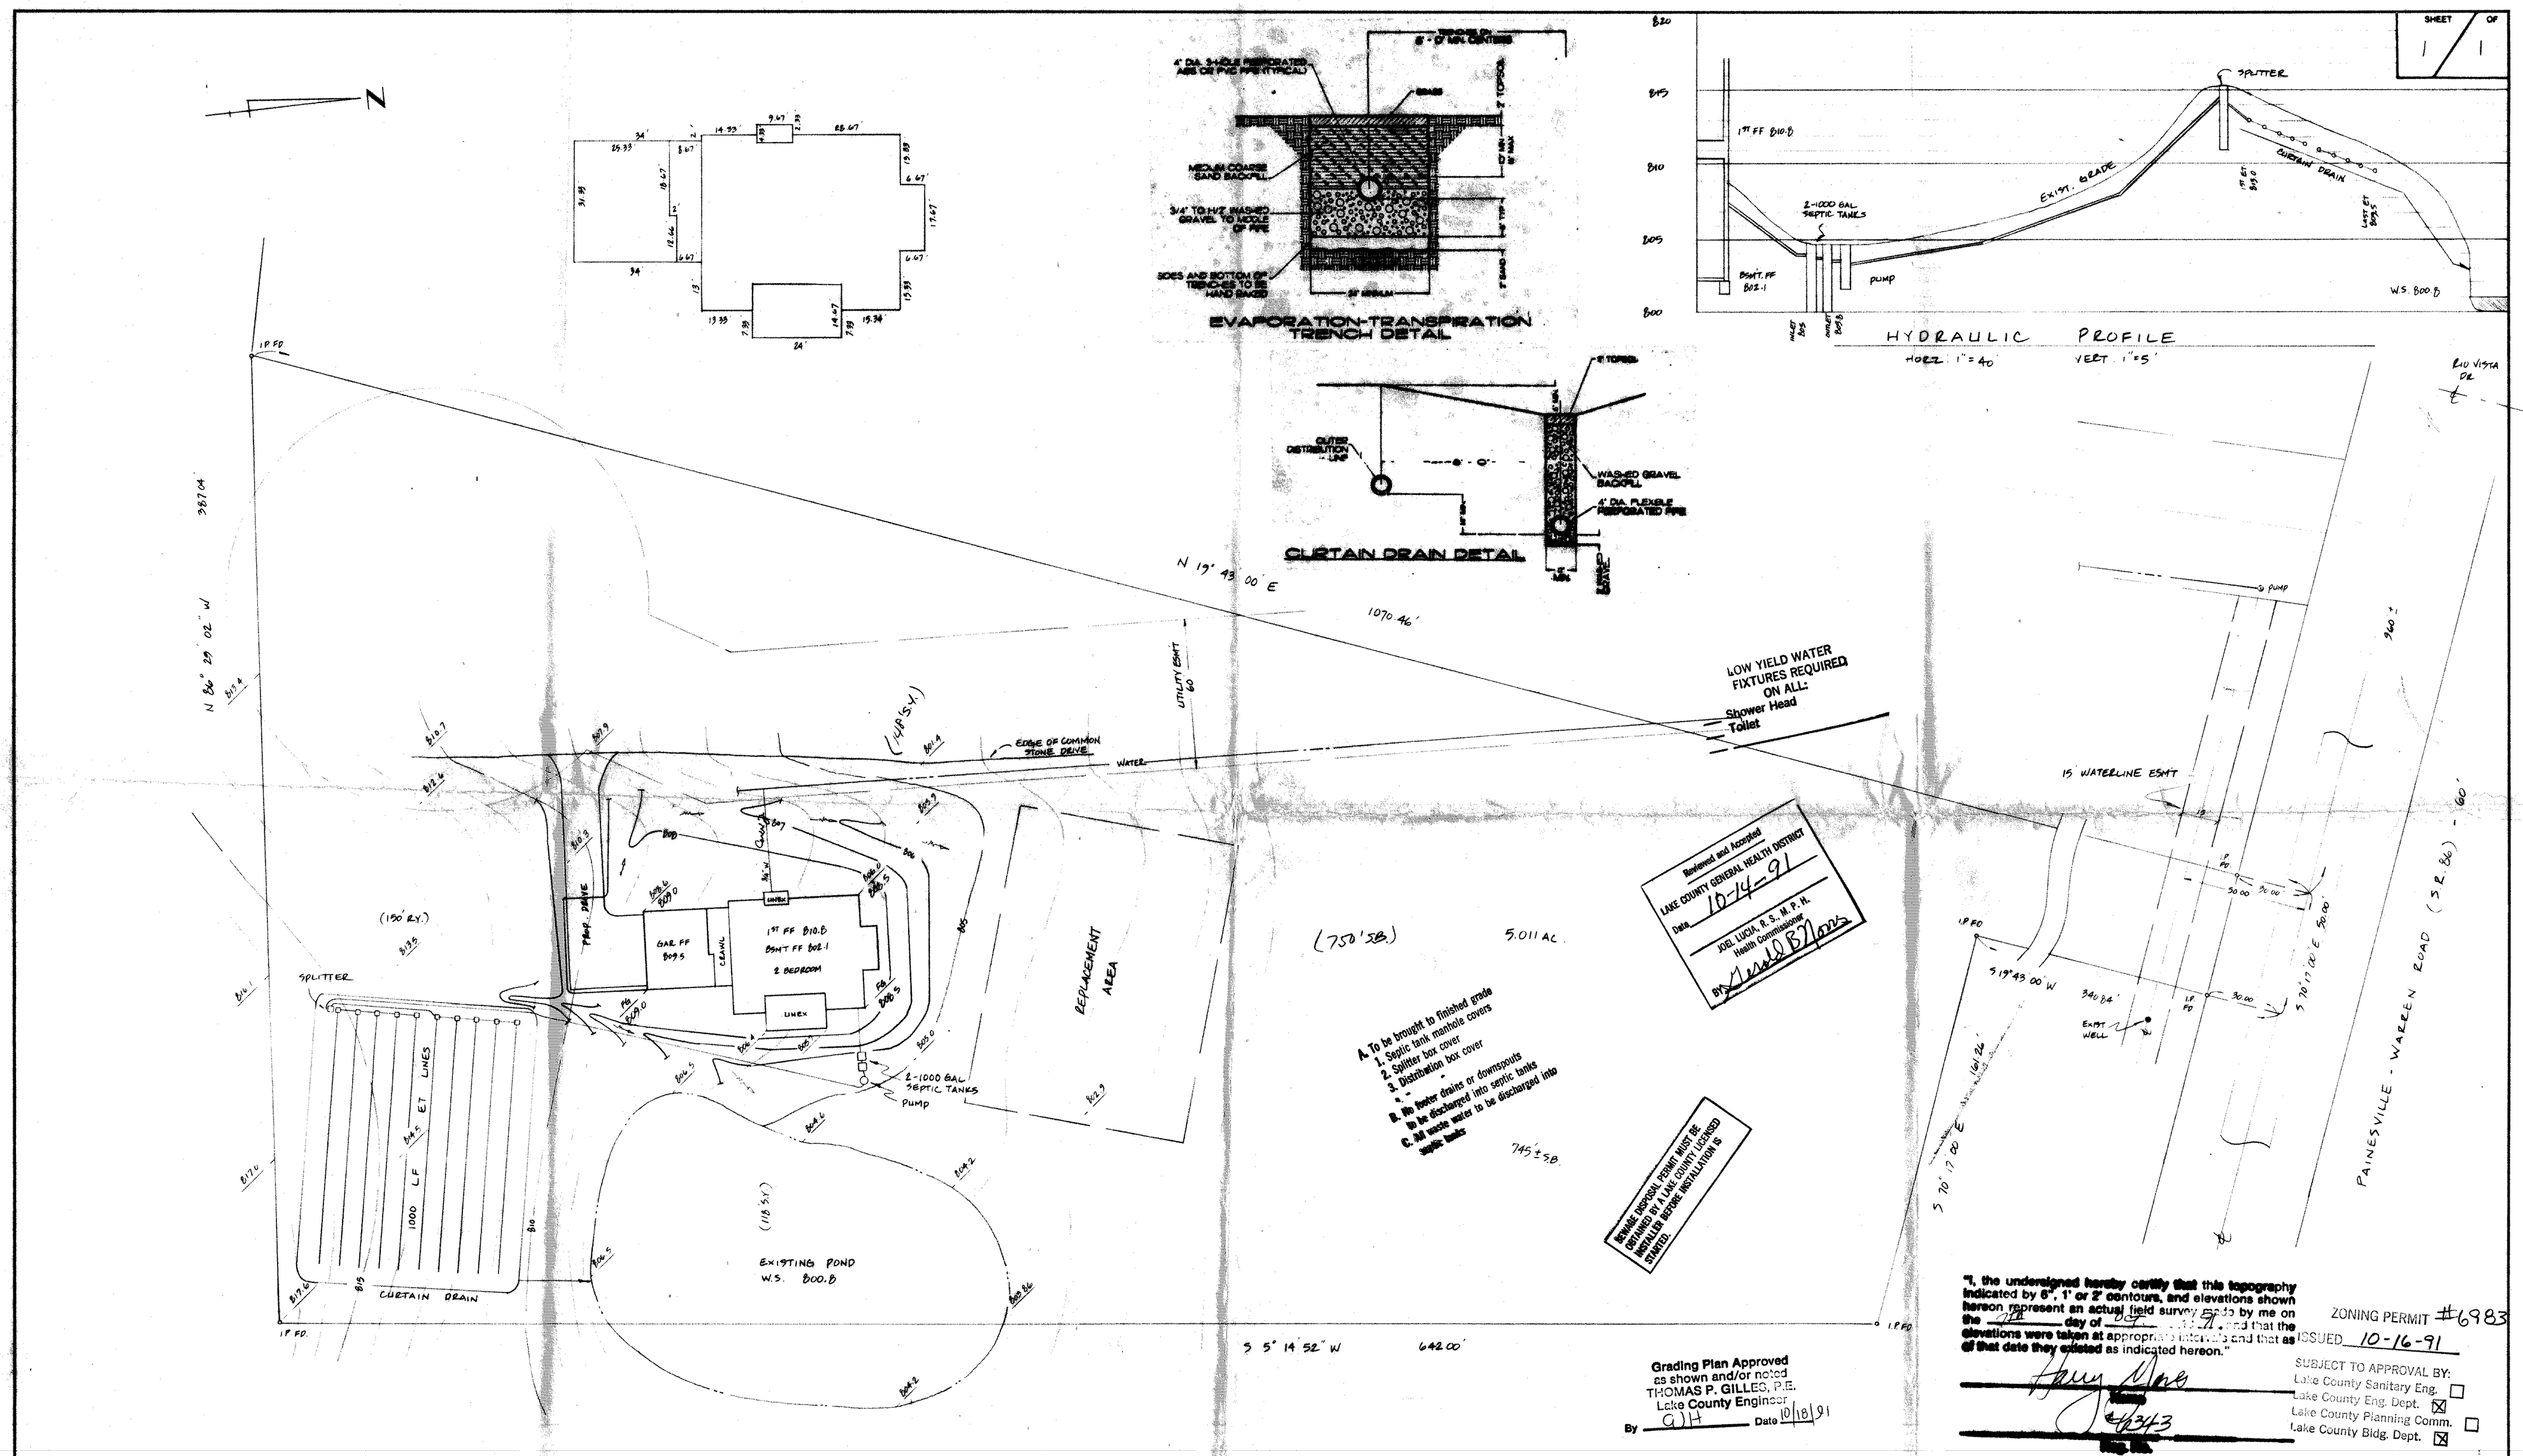

REV NO.	DESCRIPTION	DATE	BY	CHK'D

TOPOGRAPHICAL SITE PLAN FOR JIM COMINSKY

BABCOCK, JONES AND ASSOCIATES, INC
CIVIL ENGINEERS - SURVEYORS - LAND PLANNERS
PAINESVILLE OHIO 44077

DATE	OCTOBER 1991
DESIGN BY	HJT
DRAWN BY	[illegible]
APPROVED BY	HJT

CONCORD TWP LAKE COUNTY OHIO

SCALE	1" = 30'
JOB NO	90-035-5
SHEET	1 OF 1