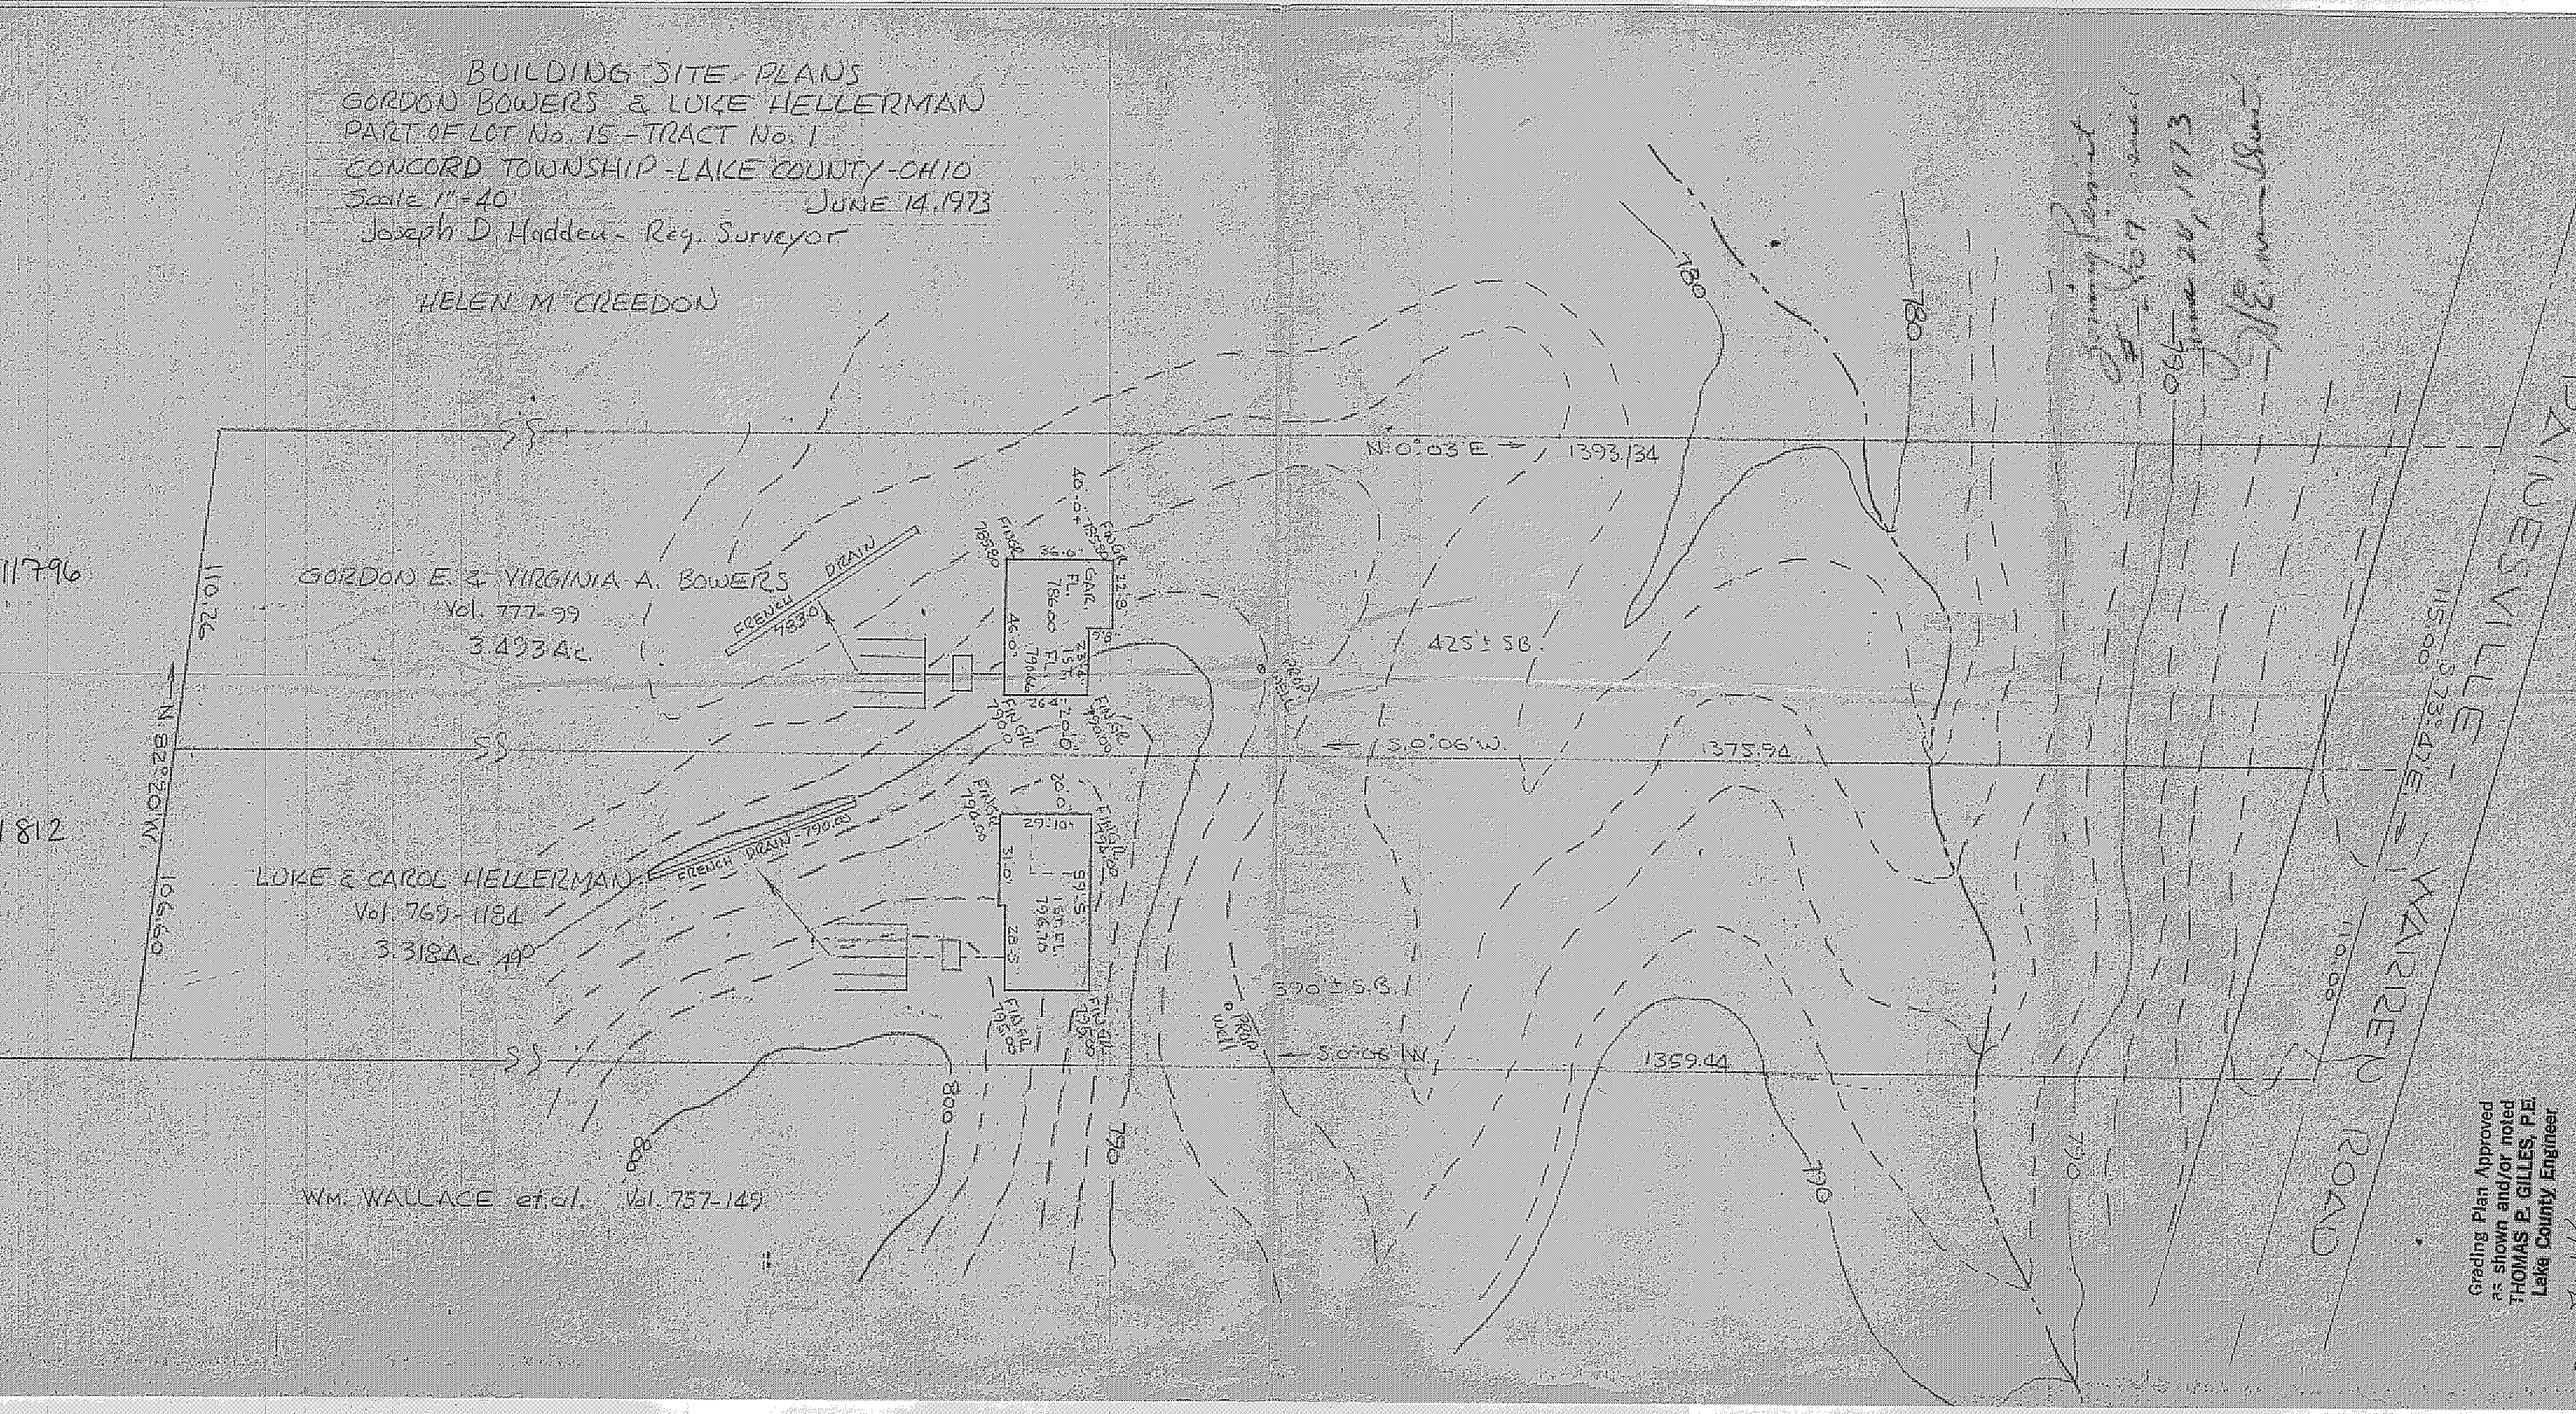
BUILDING SITE PLANS
GORDON BOWERS & LUKE HELLERMAN
PART OF LOT No. 15 - TRACT No. 1
CONCORD TOWNSHIP - LAKE COUNTY - OHIO
Scale 1" = 40'
JUNE 14, 1973
Joseph D. Hadden - Reg. Surveyor
HELEN M. CREEDON
GORDON E. & VIRGINIA A. BOWERS
Vol. 777-99
3.493 Ac.
LUKE & CAROL HELLERMAN
Vol. 769-1184
3.318 Ac.
WM. WALLACE et al. Vol. 757-149
FRENCH DRAIN
N 0°03' E
1393.34
425' ± S.B.
S 0°06' W
1375.94
390' ± S.B.
S 0°06' W
1359.44
N 82°20' W
110.26
106.60
11796
1812
780
790
800
PAINESVILLE - WARREN ROAD
Grading Plan Approved
as shown and/or noted
THOMAS P. GILLES, P.E.
Lake County Engineer