SITE PLAN
FOR
DAVID BANKER

BEING SUBLOT No. 1 ONDRICK SUB'D., IN THE TOWNSHIP OF CONCORD, COUNTY OF LAKE, STATE OF OHIO.

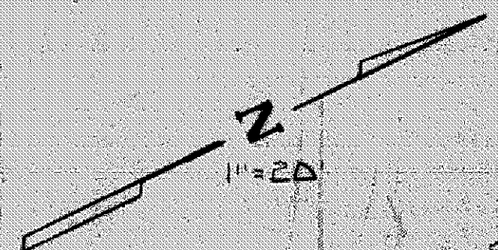

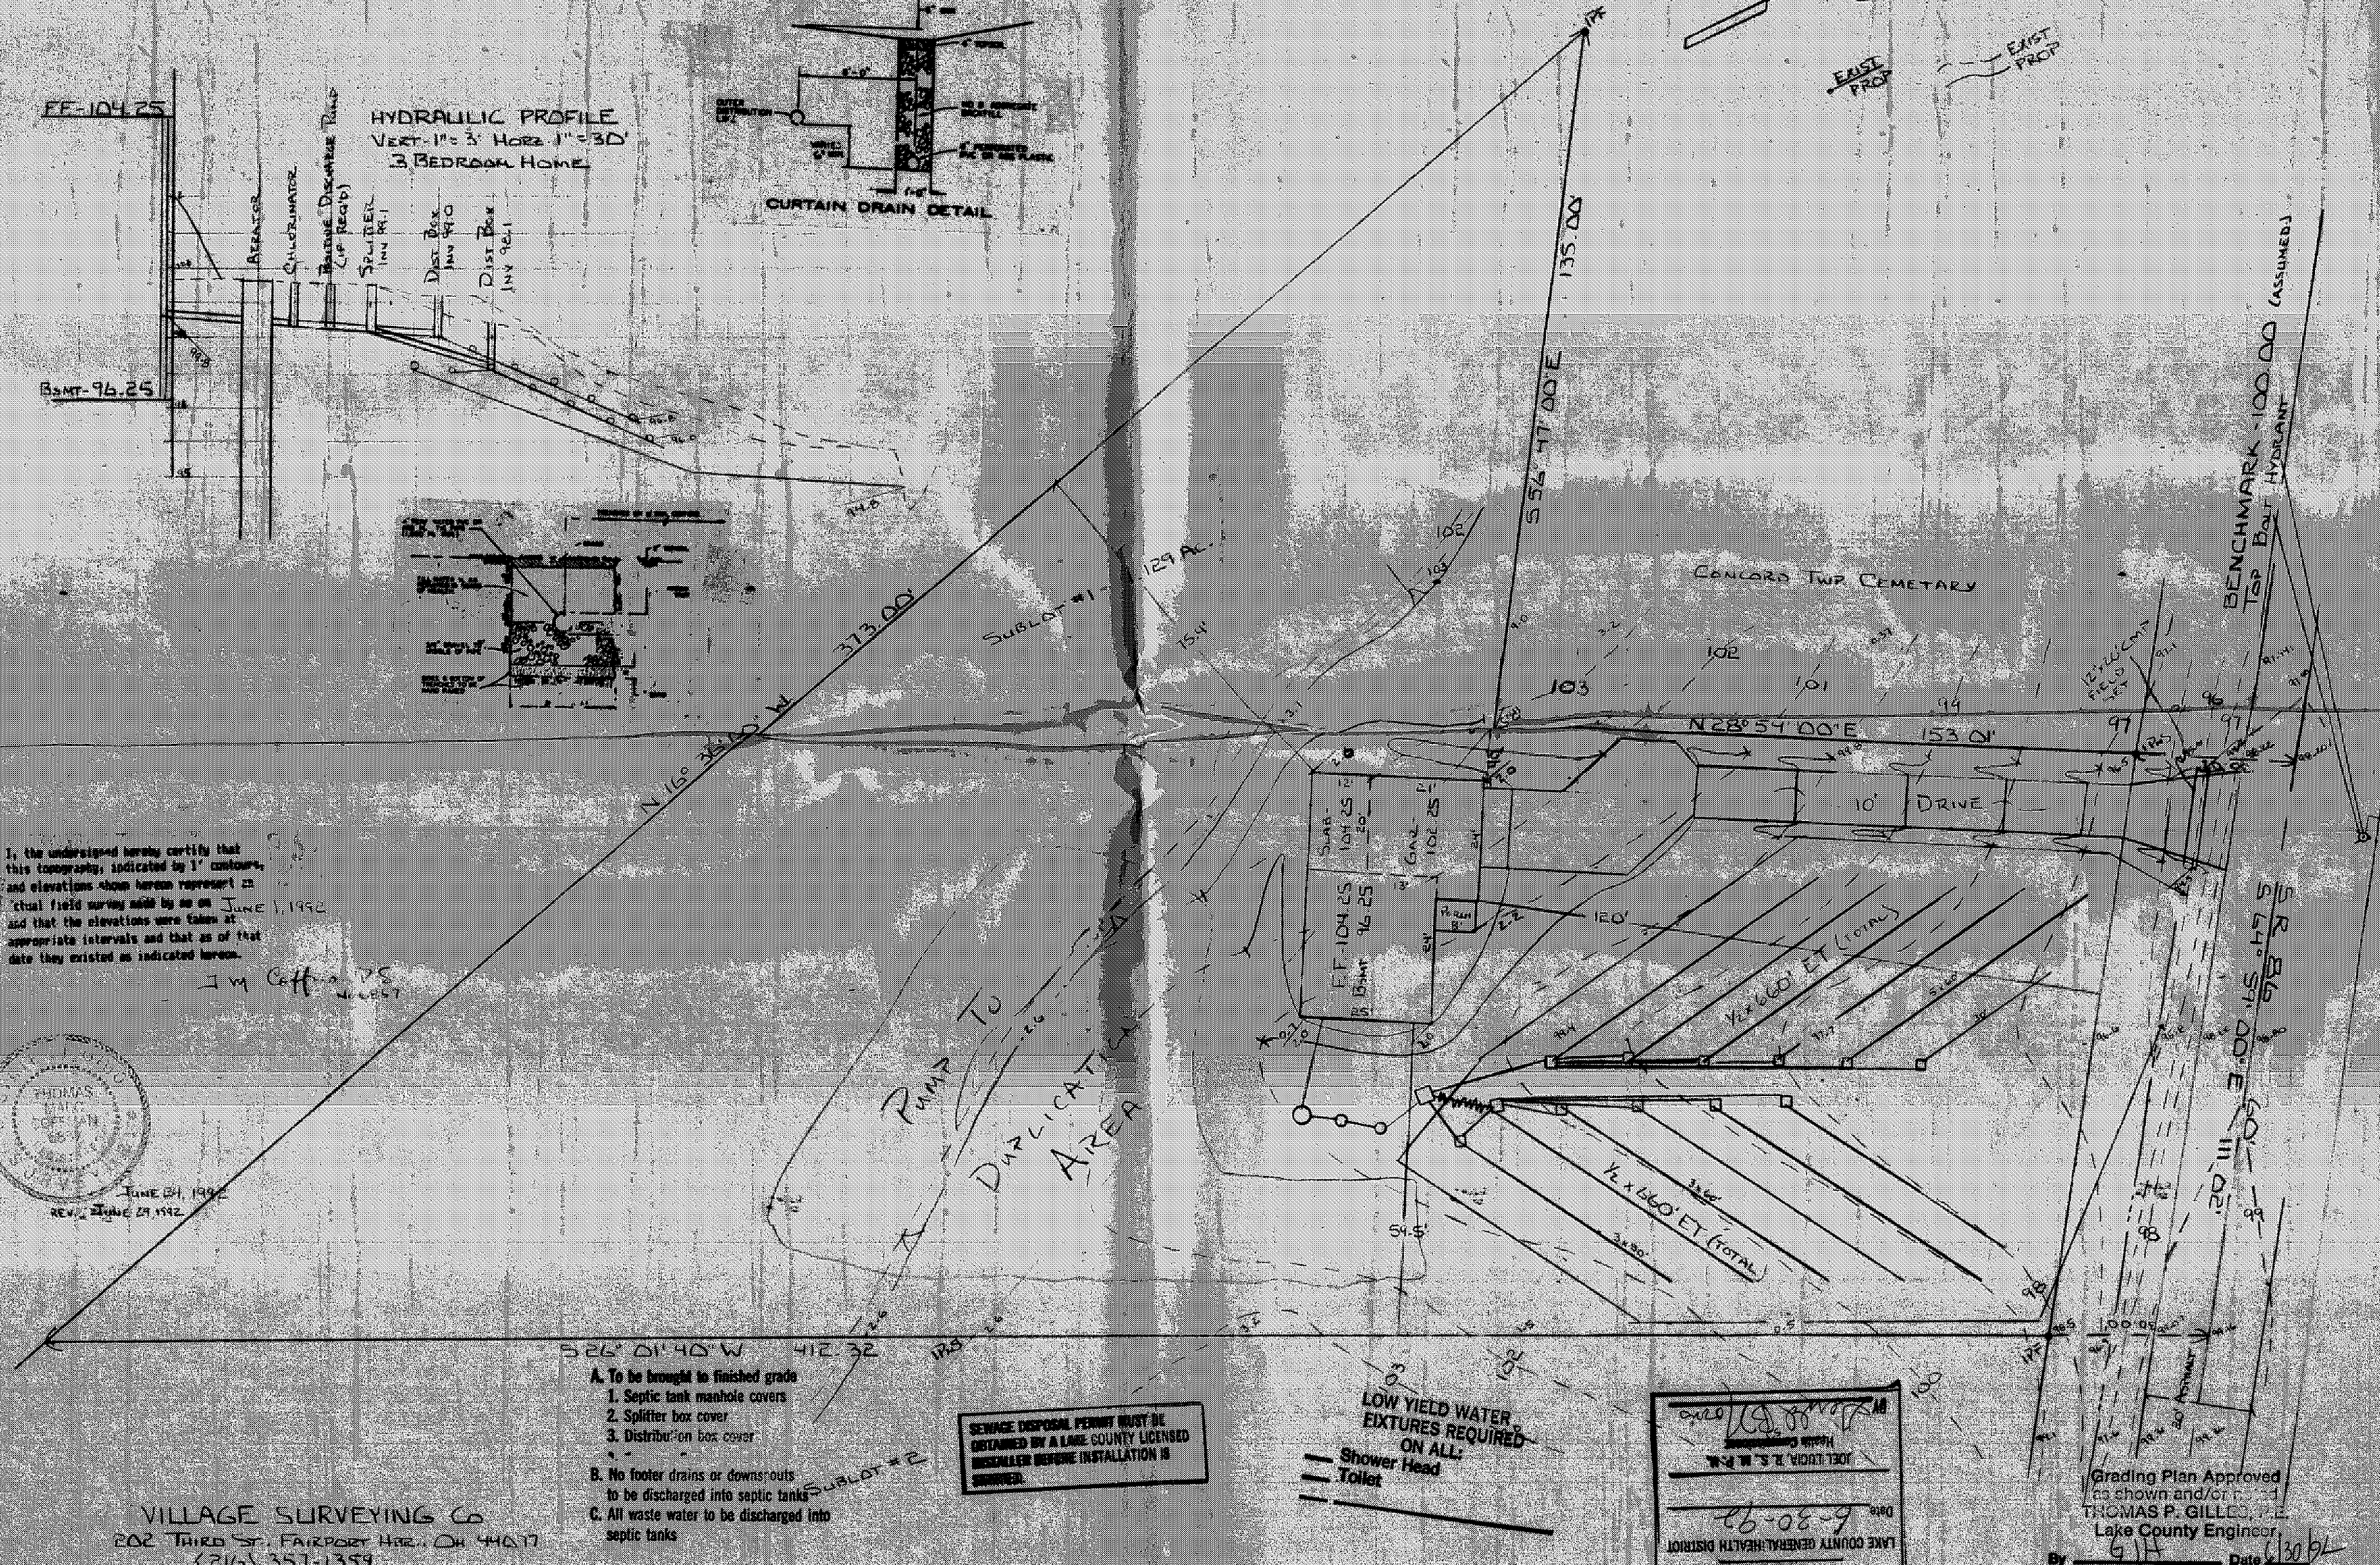

I, the undersigned hereby certify that this topography, indicated by 1' contours, and elevations shown hereon represent an actual field survey made by me on JUNE 1, 1992 and that the elevations were taken at appropriate intervals and that as of that date they existed as indicated hereon.

JM Coffman 7/8
JAMES M. COFFMAN
REGISTERED SURVEYOR
No. 6857

JUNE 24, 1992
REV. JUNE 29, 1992

A. To be brought to finished grade
1. Septic tank manhole covers
2. Splitter box cover
3. Distribution box cover
B. No footer drains or downspouts to be discharged into septic tanks
C. All waste water to be discharged into septic tanks

SEWAGE DISPOSAL PERMIT MUST BE OBTAINED BY A LAKE COUNTY LICENSED INSTALLER BEFORE INSTALLATION IS STARTED.

LOW YIELD WATER FIXTURES REQUIRED ON ALL:
Shower Head
Toilet

JOEL LUKIN, R.S., M.P.H.
Health Commissioner
Date 6-30-92
LAKE COUNTY GENERAL HEALTH DISTRICT
Reviewed and Accepted

Grading Plan Approved as shown and/or noted
THOMAS P. GILLEO, P.E.
Lake County Engineer
By GJH Date 6/30/92

VILLAGE SURVEYING Co
202 THIRD ST., FAIRPORT HBR., OH 44077
(216) 357-1359