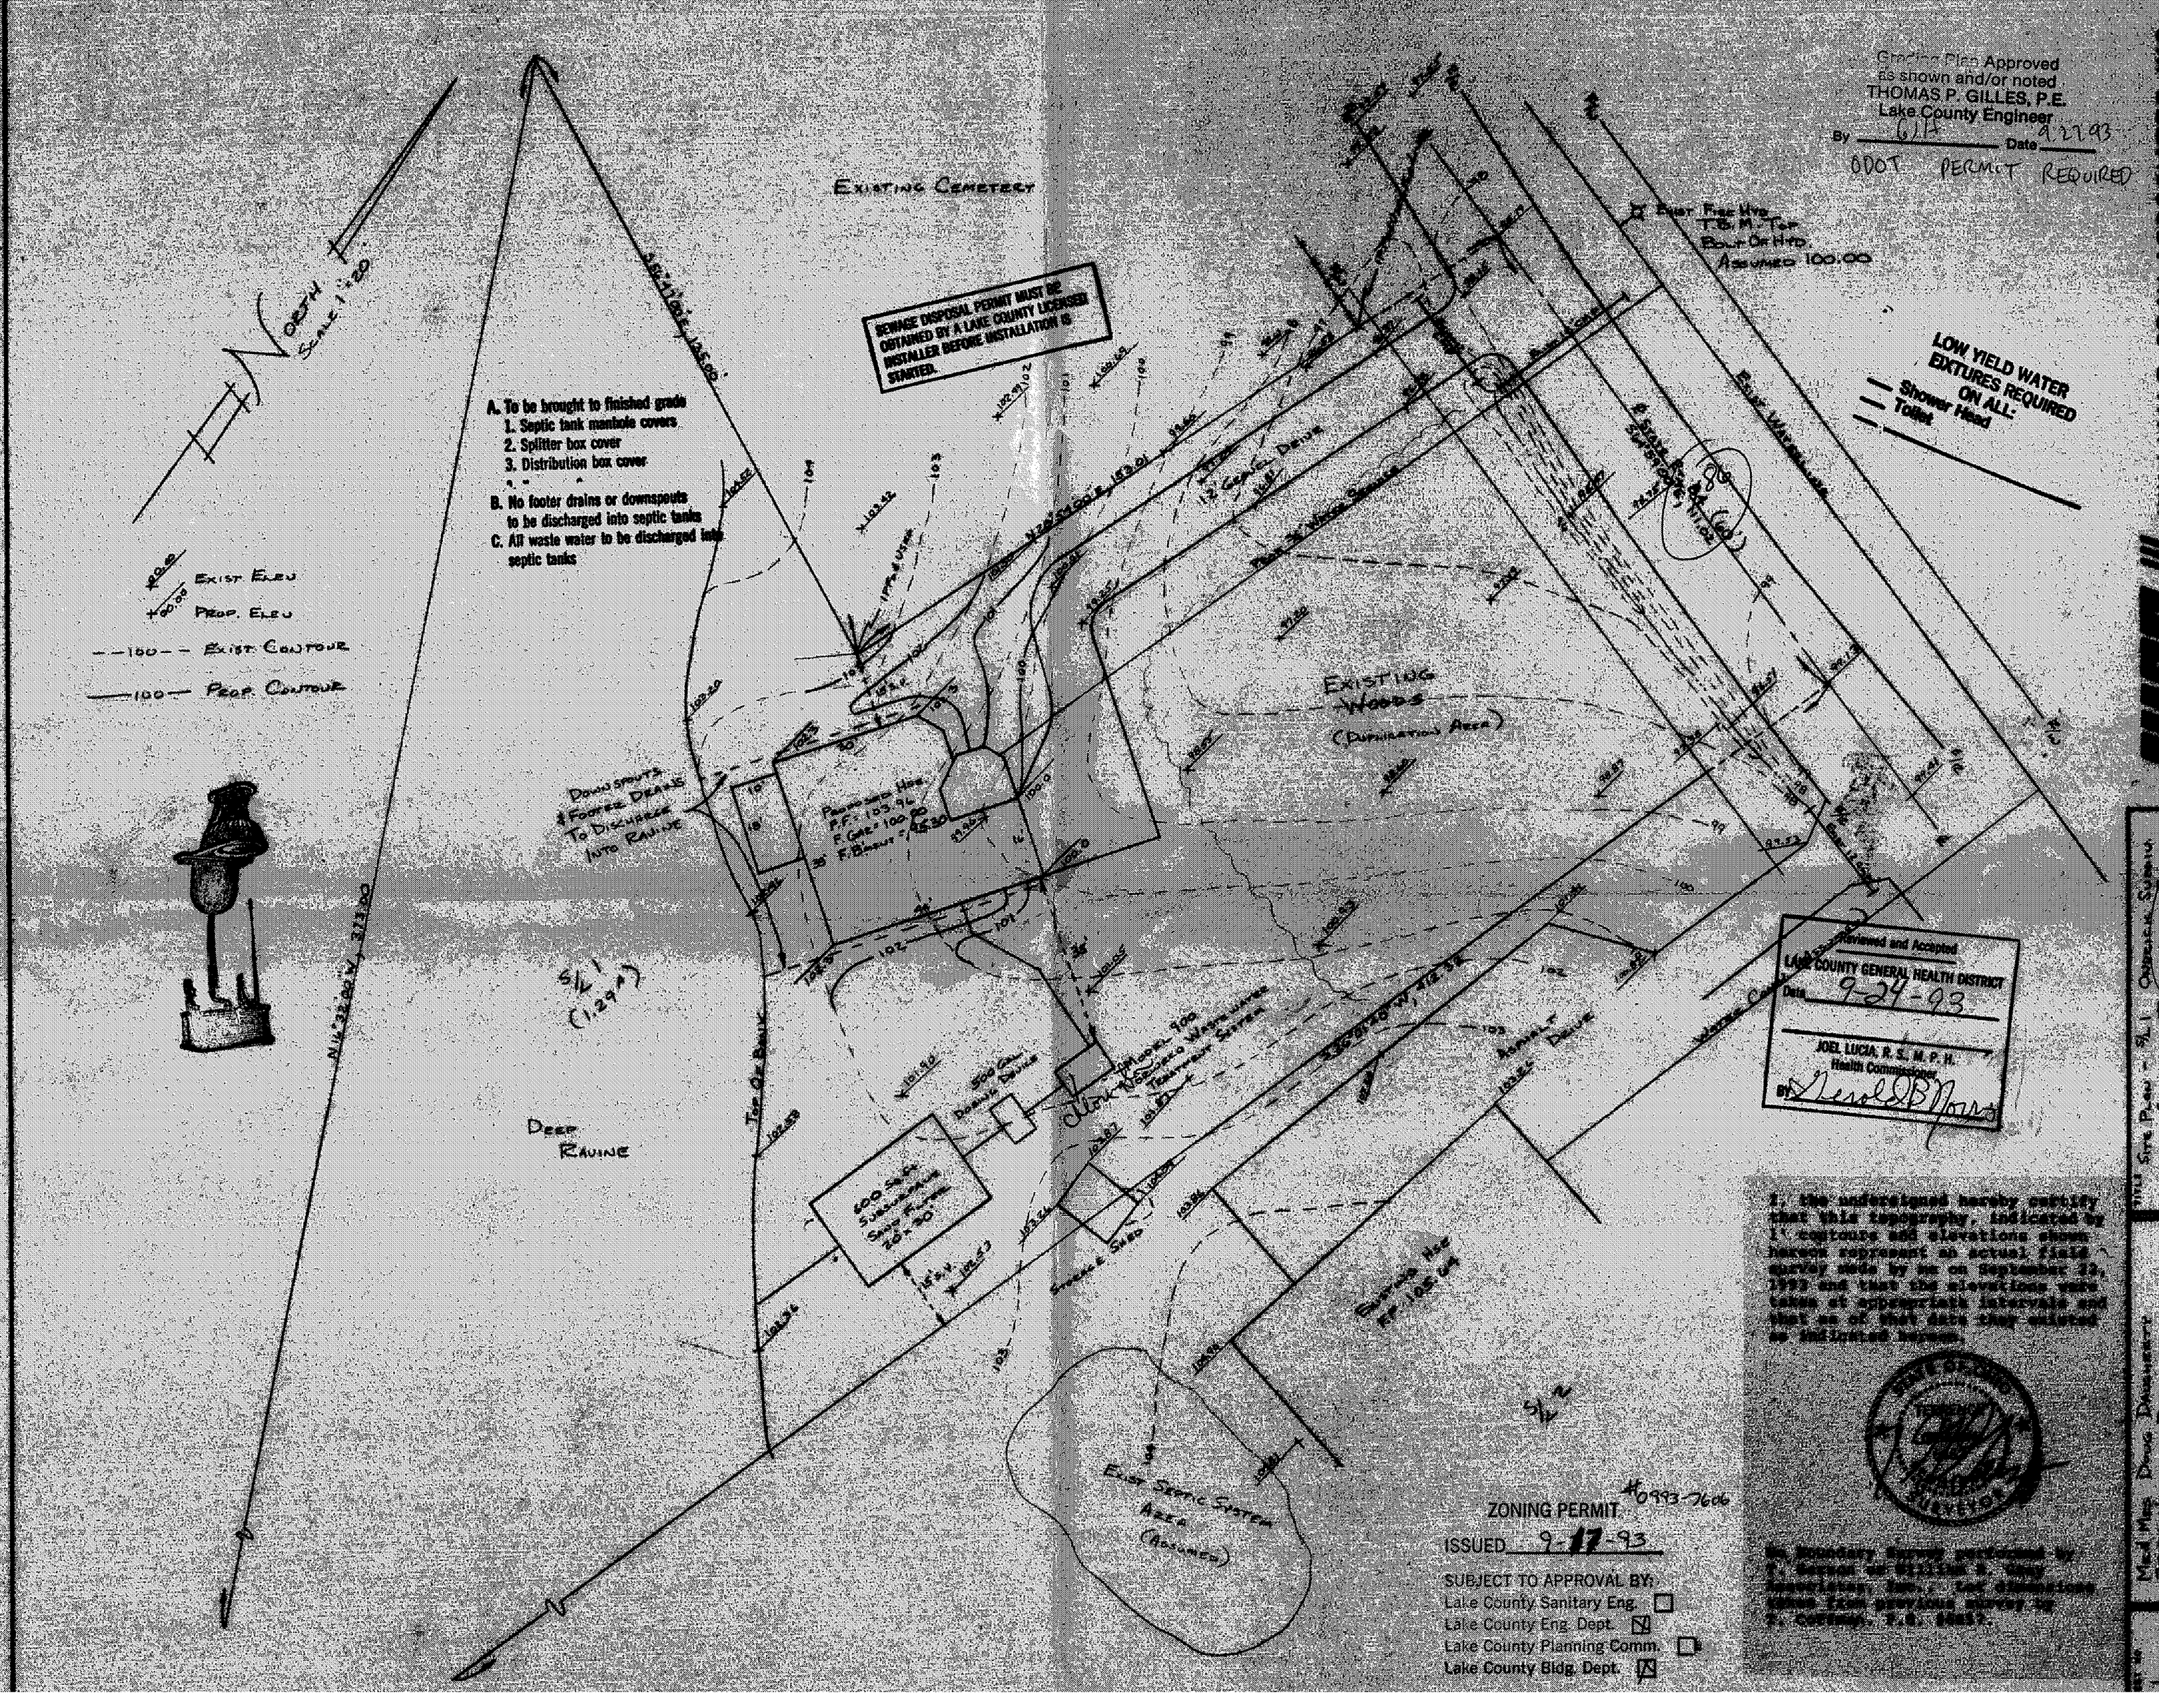

Grading Plan Approved as shown and/or noted
THOMAS P. GILLES, P.E.
Lake County Engineer
By GJH Date 9-27-93
ODOT PERMIT REQUIRED
EXISTING CEMETERY
NORTH
SCALE 1"=20'
SEWAGE DISPOSAL PERMIT MUST BE OBTAINED BY A LAKE COUNTY LICENSED INSTALLER BEFORE INSTALLATION IS STARTED.
A. To be brought to finished grade
1. Septic tank manhole covers
2. Splitter box cover
3. Distribution box cover
B. No footer drains or downspouts to be discharged into septic tanks
C. All waste water to be discharged into septic tanks
EXIST ELEV
PROP. ELEV
EXIST CONTOUR
PROP. CONTOUR
LOW YIELD WATER EXTURES REQUIRED ON ALL:
Shower Head
Toilet
EXISTING WOODS
(DUPLICATION AREA)
DOWNSPOUTS & FOOTER DRAINS TO DISCHARGE INTO RAVINE
DEEP RAVINE
TOP OF BANK
EXIST SEPTIC SYSTEM AREA (ASSUMED)
Reviewed and Accepted
LAKE COUNTY GENERAL HEALTH DISTRICT
Date 9-24-93
JOEL LUCIA, R.S., M.P.H.
Health Commissioner
BY Gerold B Norris
ZONING PERMIT #0993-7606
ISSUED 9-17-93
SUBJECT TO APPROVAL BY:
Lake County Sanitary Eng.
Lake County Eng. Dept.
Lake County Planning Comm.
Lake County Bldg. Dept.
WILLIAM R. GRAY ASSOCIATES, INC.
7519 MENTOR AVENUE MENTOR, OHIO 44060
Site Plan - S/L 1 Cardinal Subdivision
Concord Twp - Lake County
Vacant Parcel 6410 Rock Rd
23 Sep 93