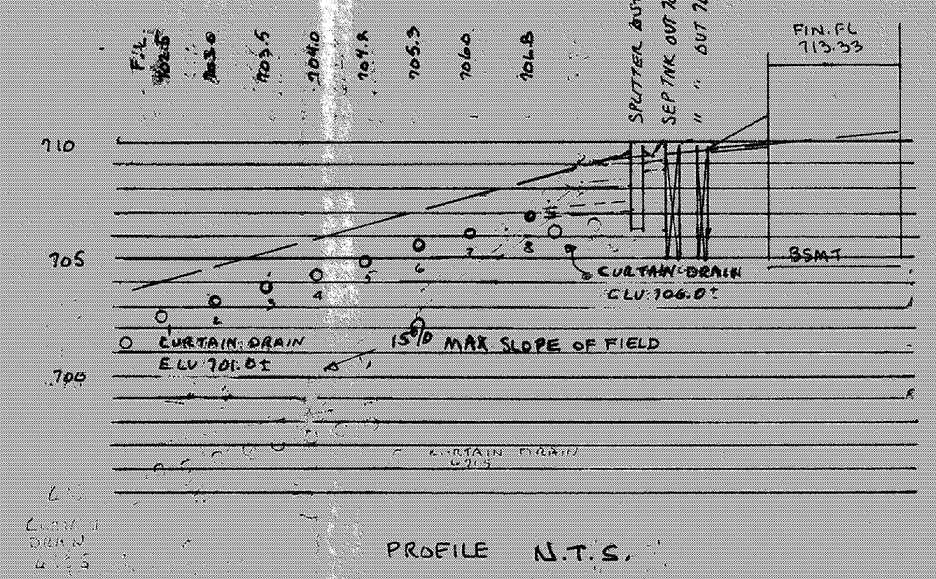

PROFILE N.T.S.

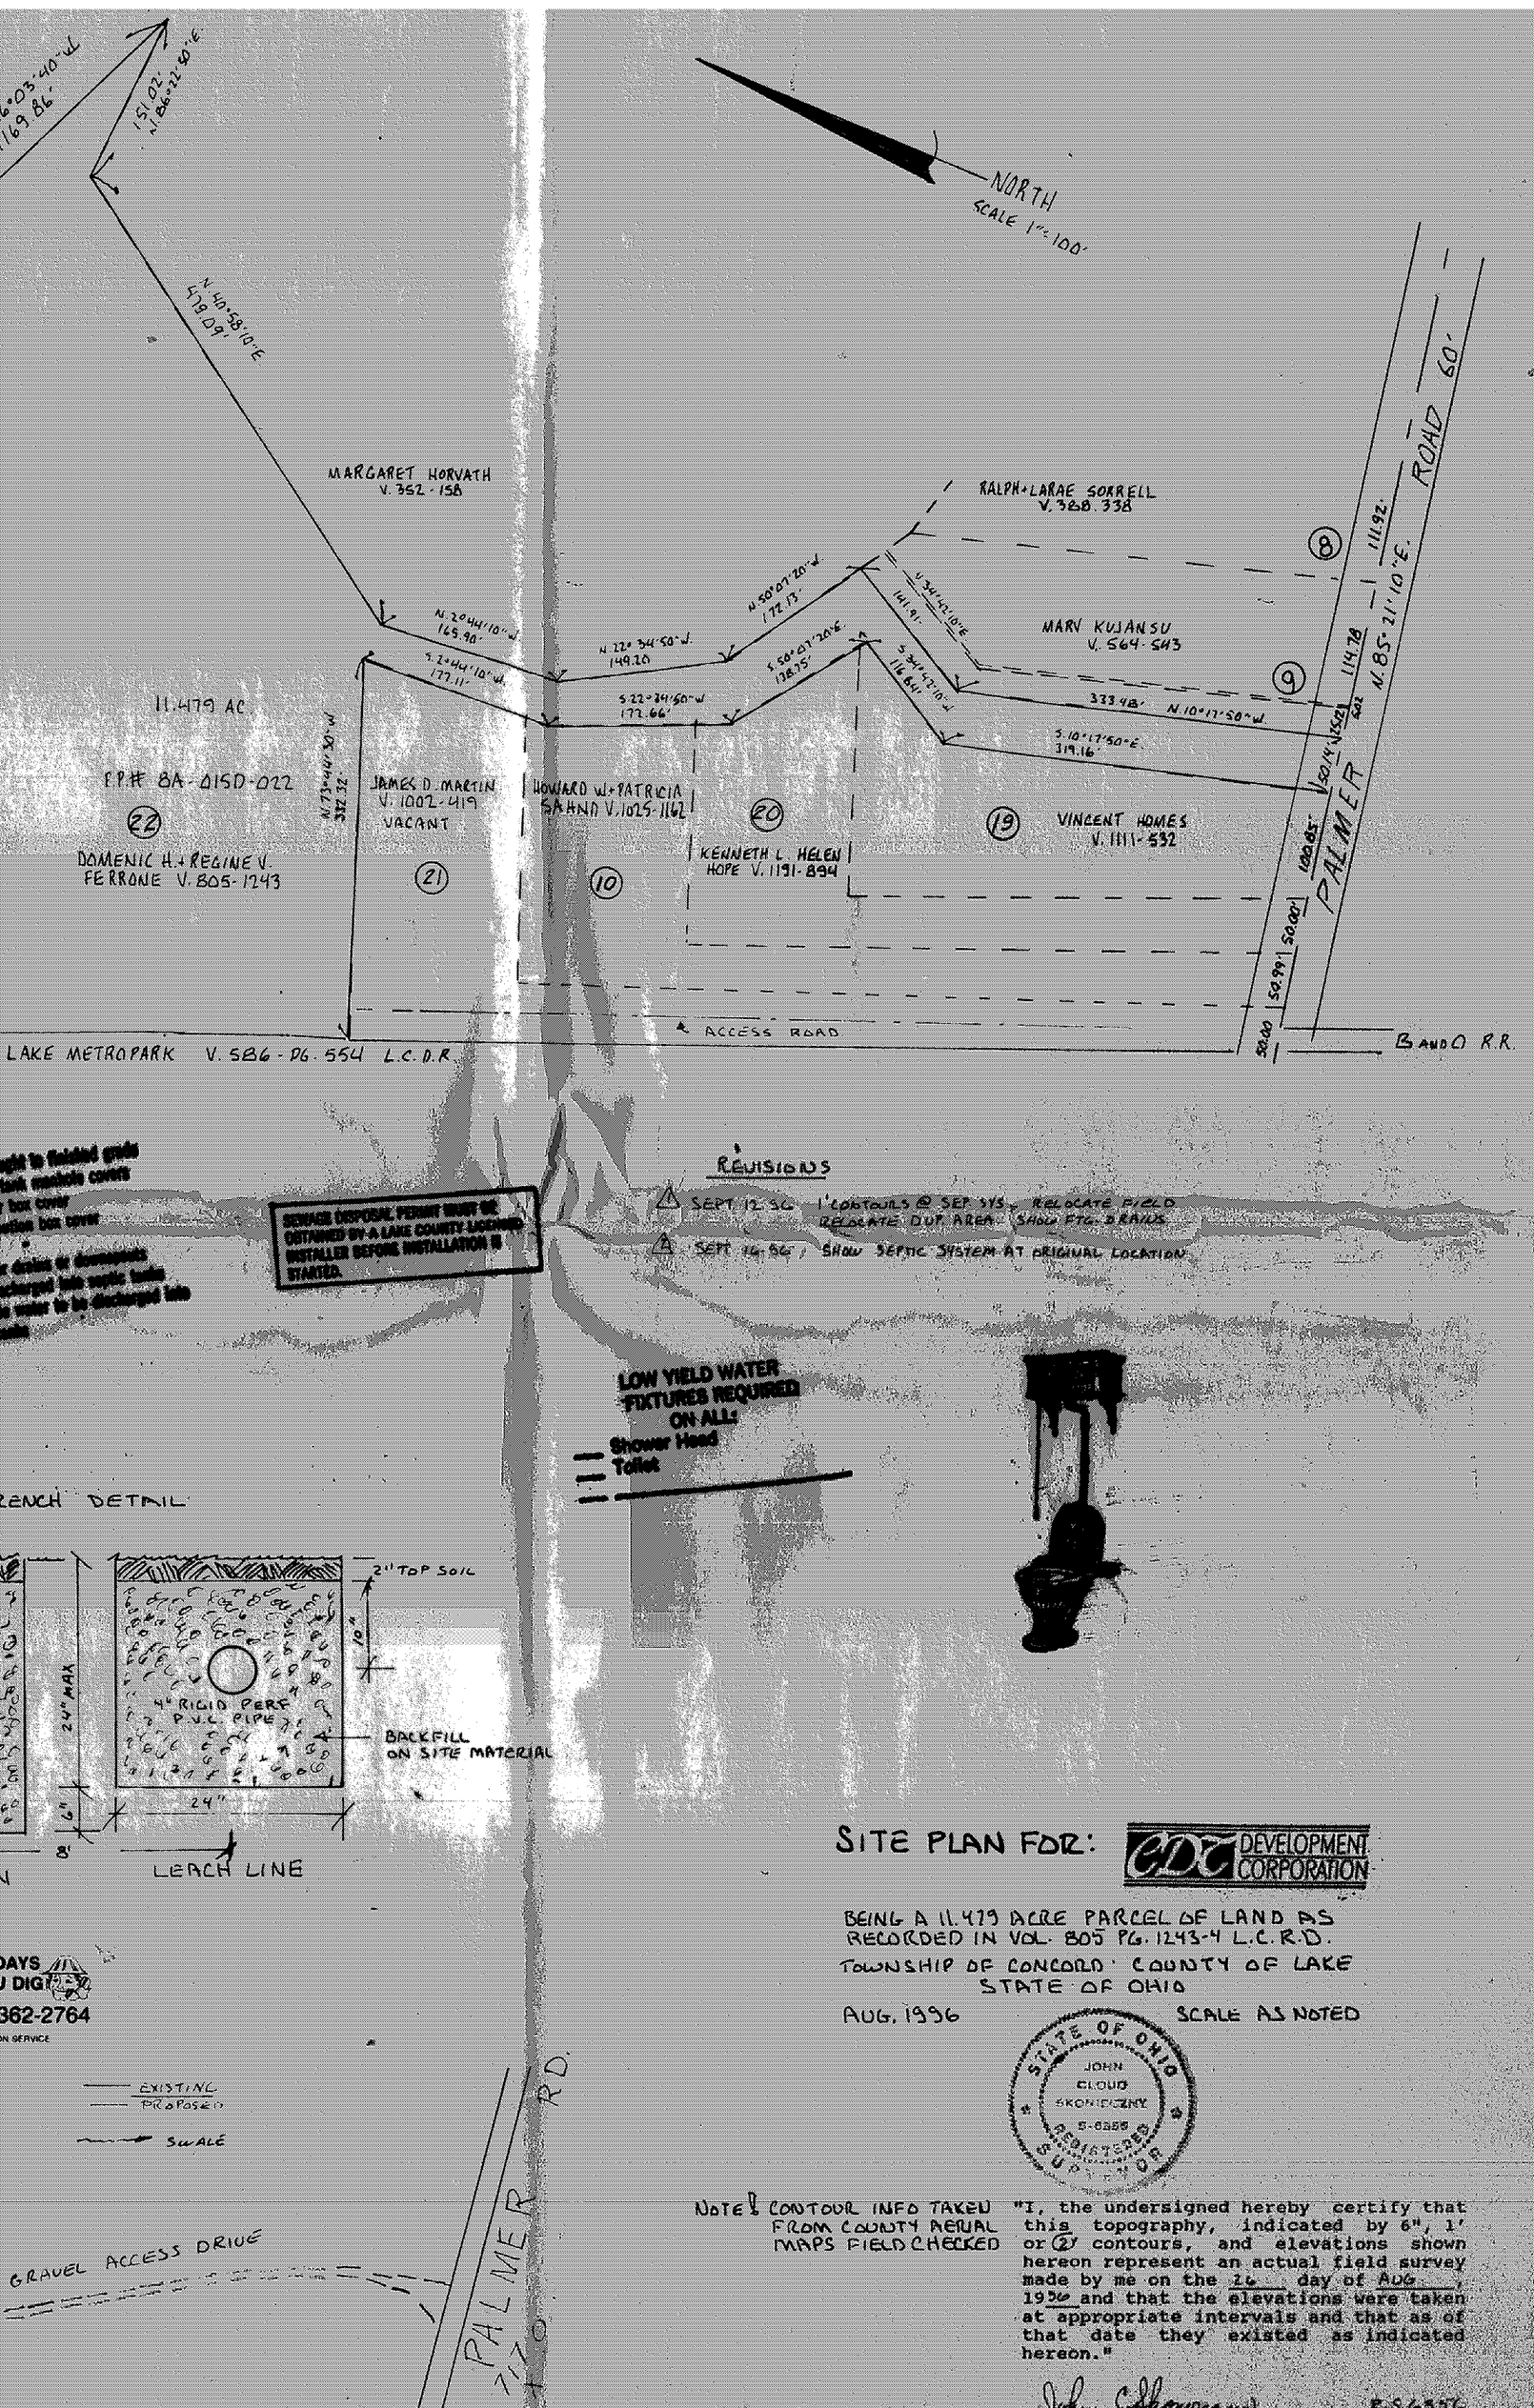

Reviewed and Accepted
LAKE COUNTY GENERAL HEALTH DISTRICT
Date 9-20-96
ADL USCGA R.S. M.P.C.O.
Health Commissioner or Authorized Representative
By Arnold B. Morris

A. To be brought to finished grade
1. Septic tank manhole covers
2. Splitter box cover
3. Distribution box cover
4. " "
B. The finish elevation of observation
to be checkered tank manhole tanks
C. All vents prior to the discharged into
septic tanks

SEWAGE DISPOSAL PERMIT MUST BE OBTAINED BY A LAKE COUNTY LICENSED INSTALLER BEFORE INSTALLATION IS STARTED.

REVISIONS
△ SEPT 12, 96 - 1' CONTOURS @ SEP 9'95, RELOCATE P.I.D. BECAUSE OUR AREA SHOWN PTS. 2 EALES
△ SEPT 16, 96 - SHOW SEPTIC SYSTEM AT ORIGINAL LOCATION

TRENCH DETAIL

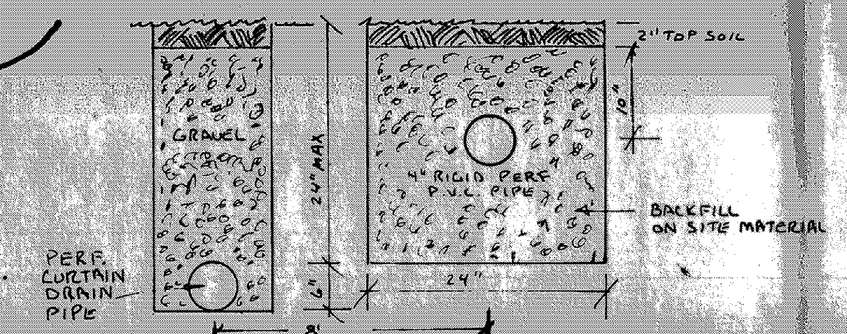

2 WORKING DAYS BEFORE YOU DIG
CALL TOLL FREE 800-362-2764
OHIO UTILITIES PROTECTION SERVICE

EXISTING
PROPOSED
SCALE

LOW YIELD WATER FIXTURES REQUIRED ON ALL:
— Shower Head
— Toilet

SITE PLAN FOR: CDC DEVELOPMENT CORPORATION

BEING A 11.479 ACRE PARCEL OF LAND AS RECORDED IN VOL. 805 PG. 1243-4 L.C.R.D.
TOWNSHIP OF CONCORD · COUNTY OF LAKE
STATE OF OHIO

AUG. 1996 SCALE AS NOTED

STATE OF OHIO · JOHN CLOUD · GRONINGEN · REGISTERED SURVEYOR · 6336

NOTE: CONTOUR INFO TAKEN FROM COUNTY AERIAL MAPS FIELD CHECKED

"I, the undersigned hereby certify that this topography, indicated by 6", 1' or (2') contours, and elevations shown hereon represent an actual field survey made by me on the 26 day of AUG, 1996 and that the elevations were taken at appropriate intervals and that as of that date they existed as indicated hereon."

John C Thomczyn — Name
E-6336 — Reg. No