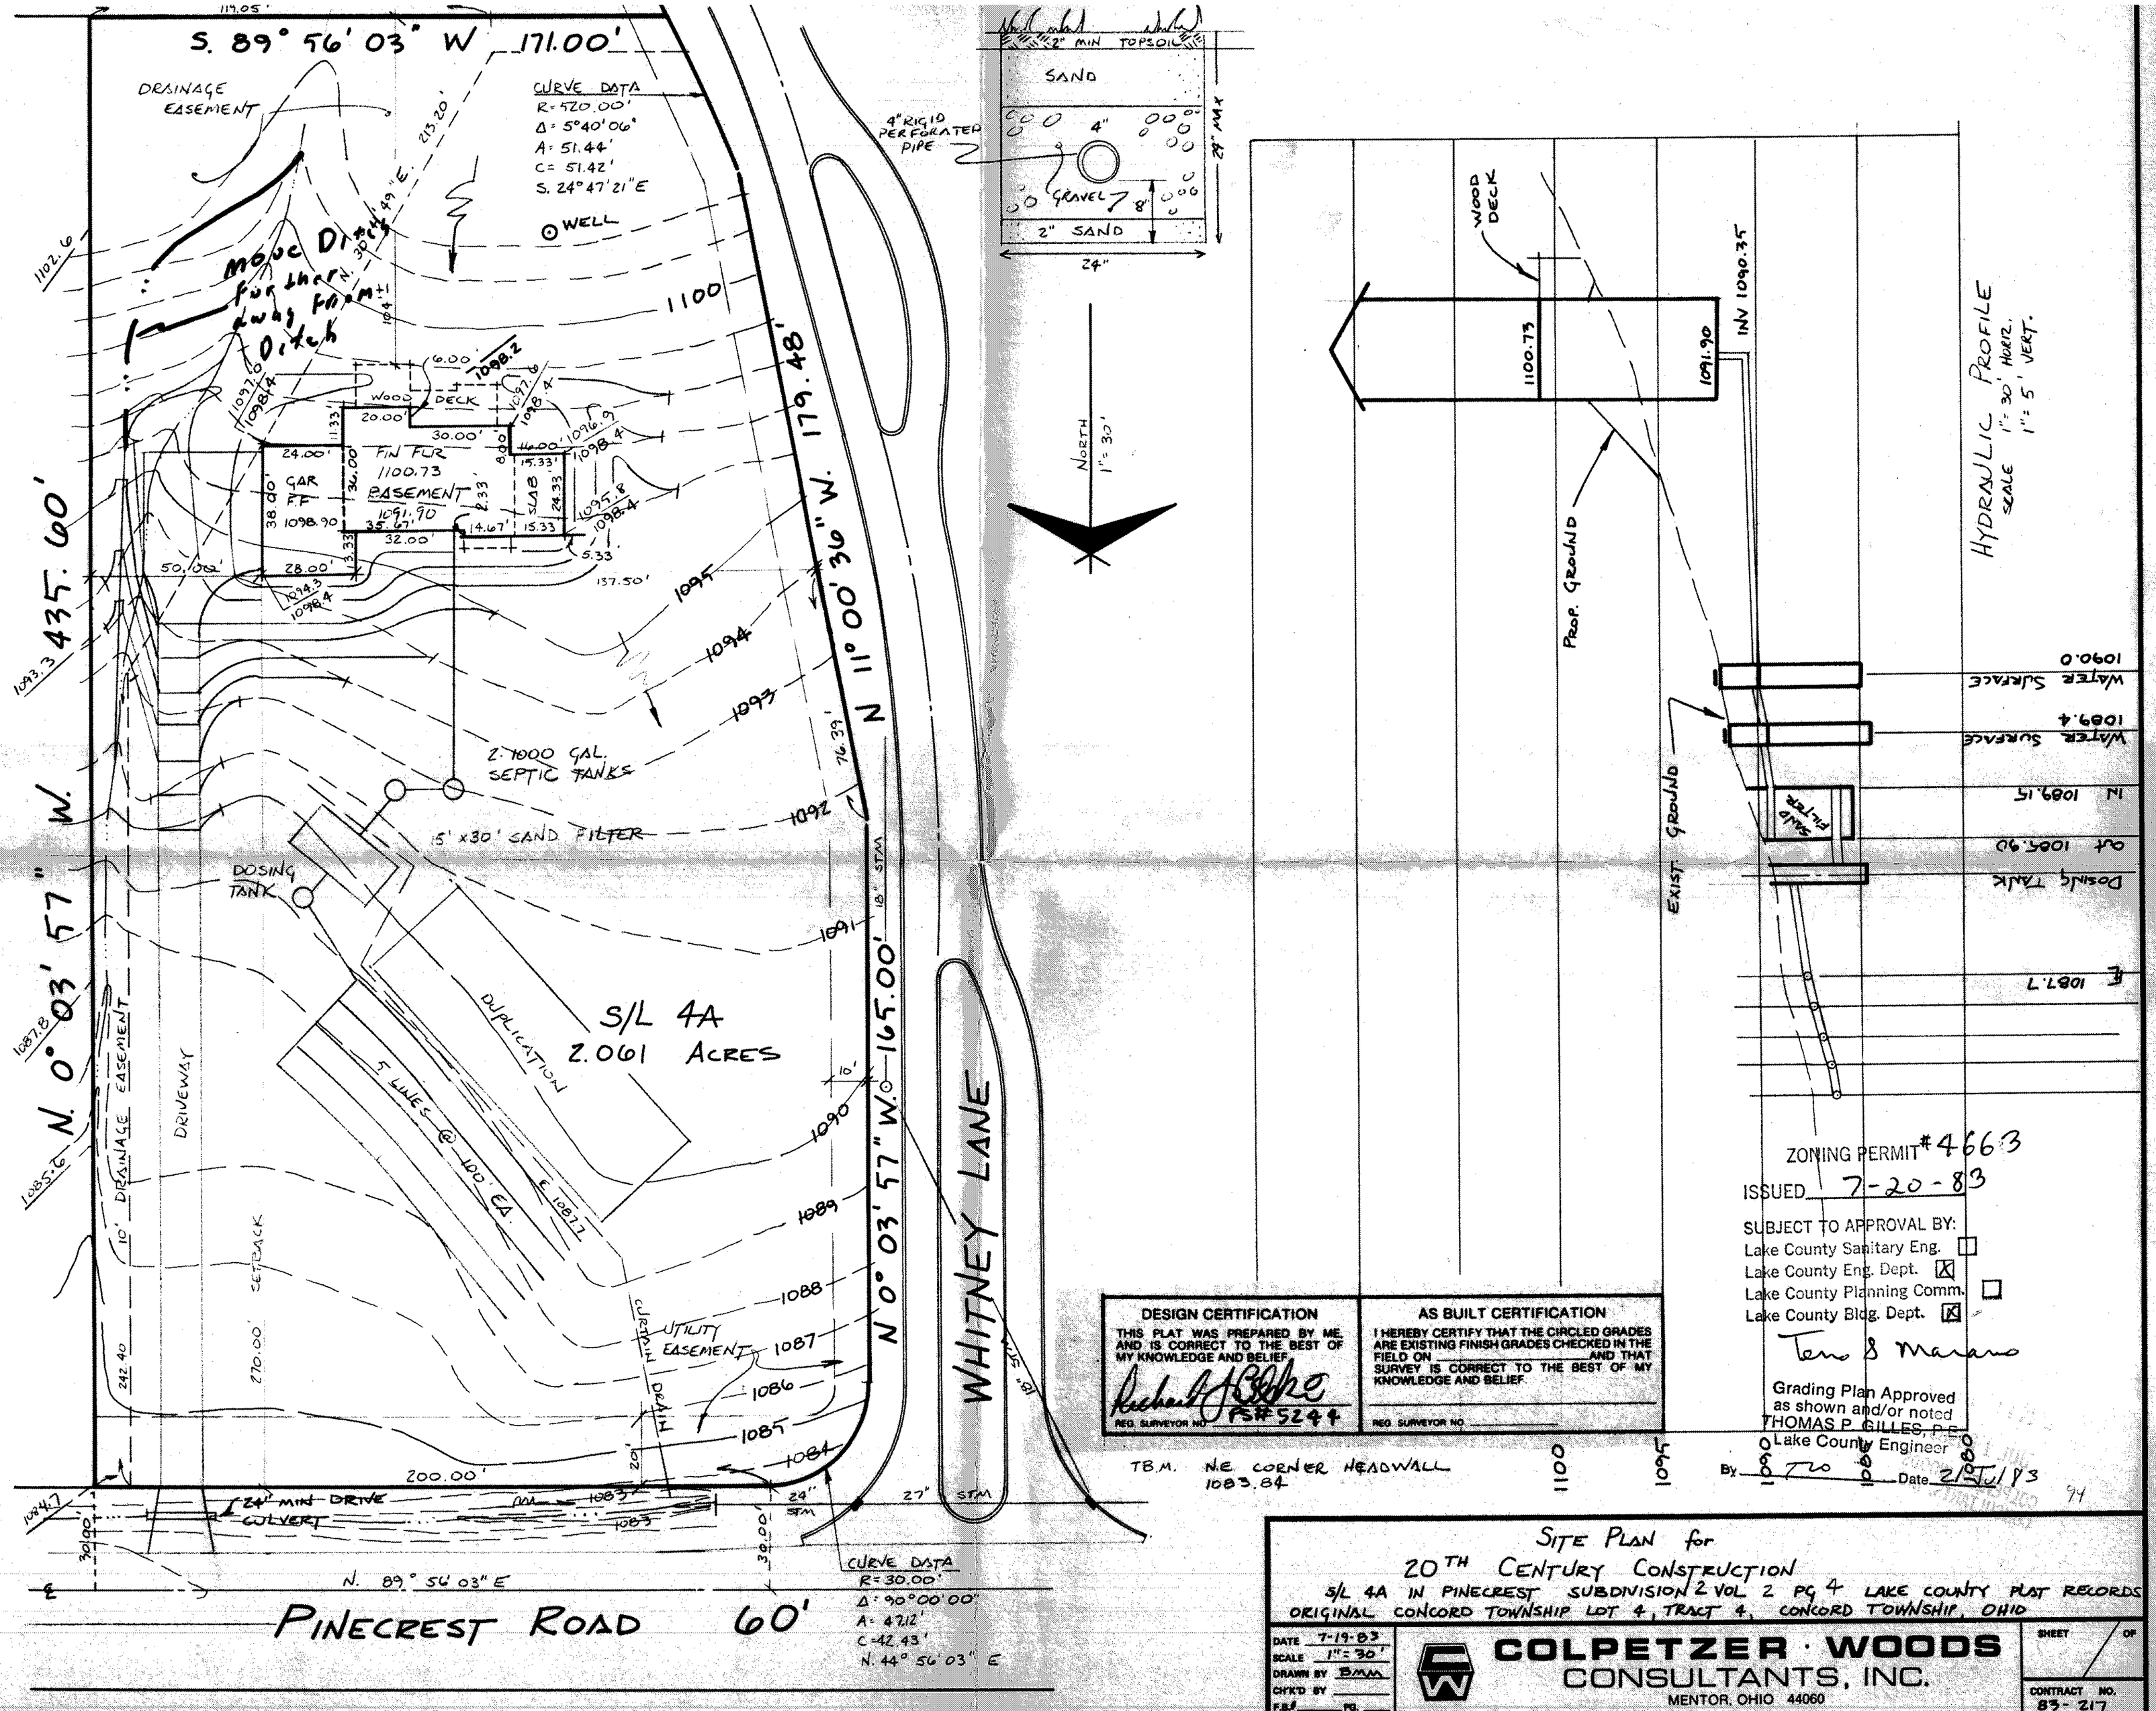

ZONING PERMIT #4663
ISSUED 7-20-83
SUBJECT TO APPROVAL BY:
Lake County Sanitary Eng. ☐
Lake County Eng. Dept. ☒
Lake County Planning Comm. ☐
Lake County Bldg. Dept. ☒
Teno S Marano
Grading Plan Approved as shown and/or noted
THOMAS P. GILLES, P.E.
Lake County Engineer
By TPG Date 21 Jul 83

DESIGN CERTIFICATION
THIS PLAT WAS PREPARED BY ME, AND IS CORRECT TO THE BEST OF MY KNOWLEDGE AND BELIEF.
Richard J. Blake
REG. SURVEYOR NO. PS#5244

AS BUILT CERTIFICATION
I HEREBY CERTIFY THAT THE CIRCLED GRADES ARE EXISTING FINISH GRADES CHECKED IN THE FIELD ON _____ AND THAT SURVEY IS CORRECT TO THE BEST OF MY KNOWLEDGE AND BELIEF.
REG. SURVEYOR NO. _____

TB.M. N.E. CORNER HEADWALL 1083.84

SITE PLAN for
20TH CENTURY CONSTRUCTION
S/L 4A IN PINECREST SUBDIVISION 2 VOL 2 PG 4 LAKE COUNTY PLAT RECORDS
ORIGINAL CONCORD TOWNSHIP LOT 4, TRACT 4, CONCORD TOWNSHIP, OHIO

DATE 7-19-83
SCALE 1"=30'
DRAWN BY BMM
CH'K'D BY _____
F.B.# _____ PG. _____

COLPETZER · WOODS CONSULTANTS, INC.
MENTOR, OHIO 44060

SHEET _____ OF _____
CONTRACT NO. 83-217