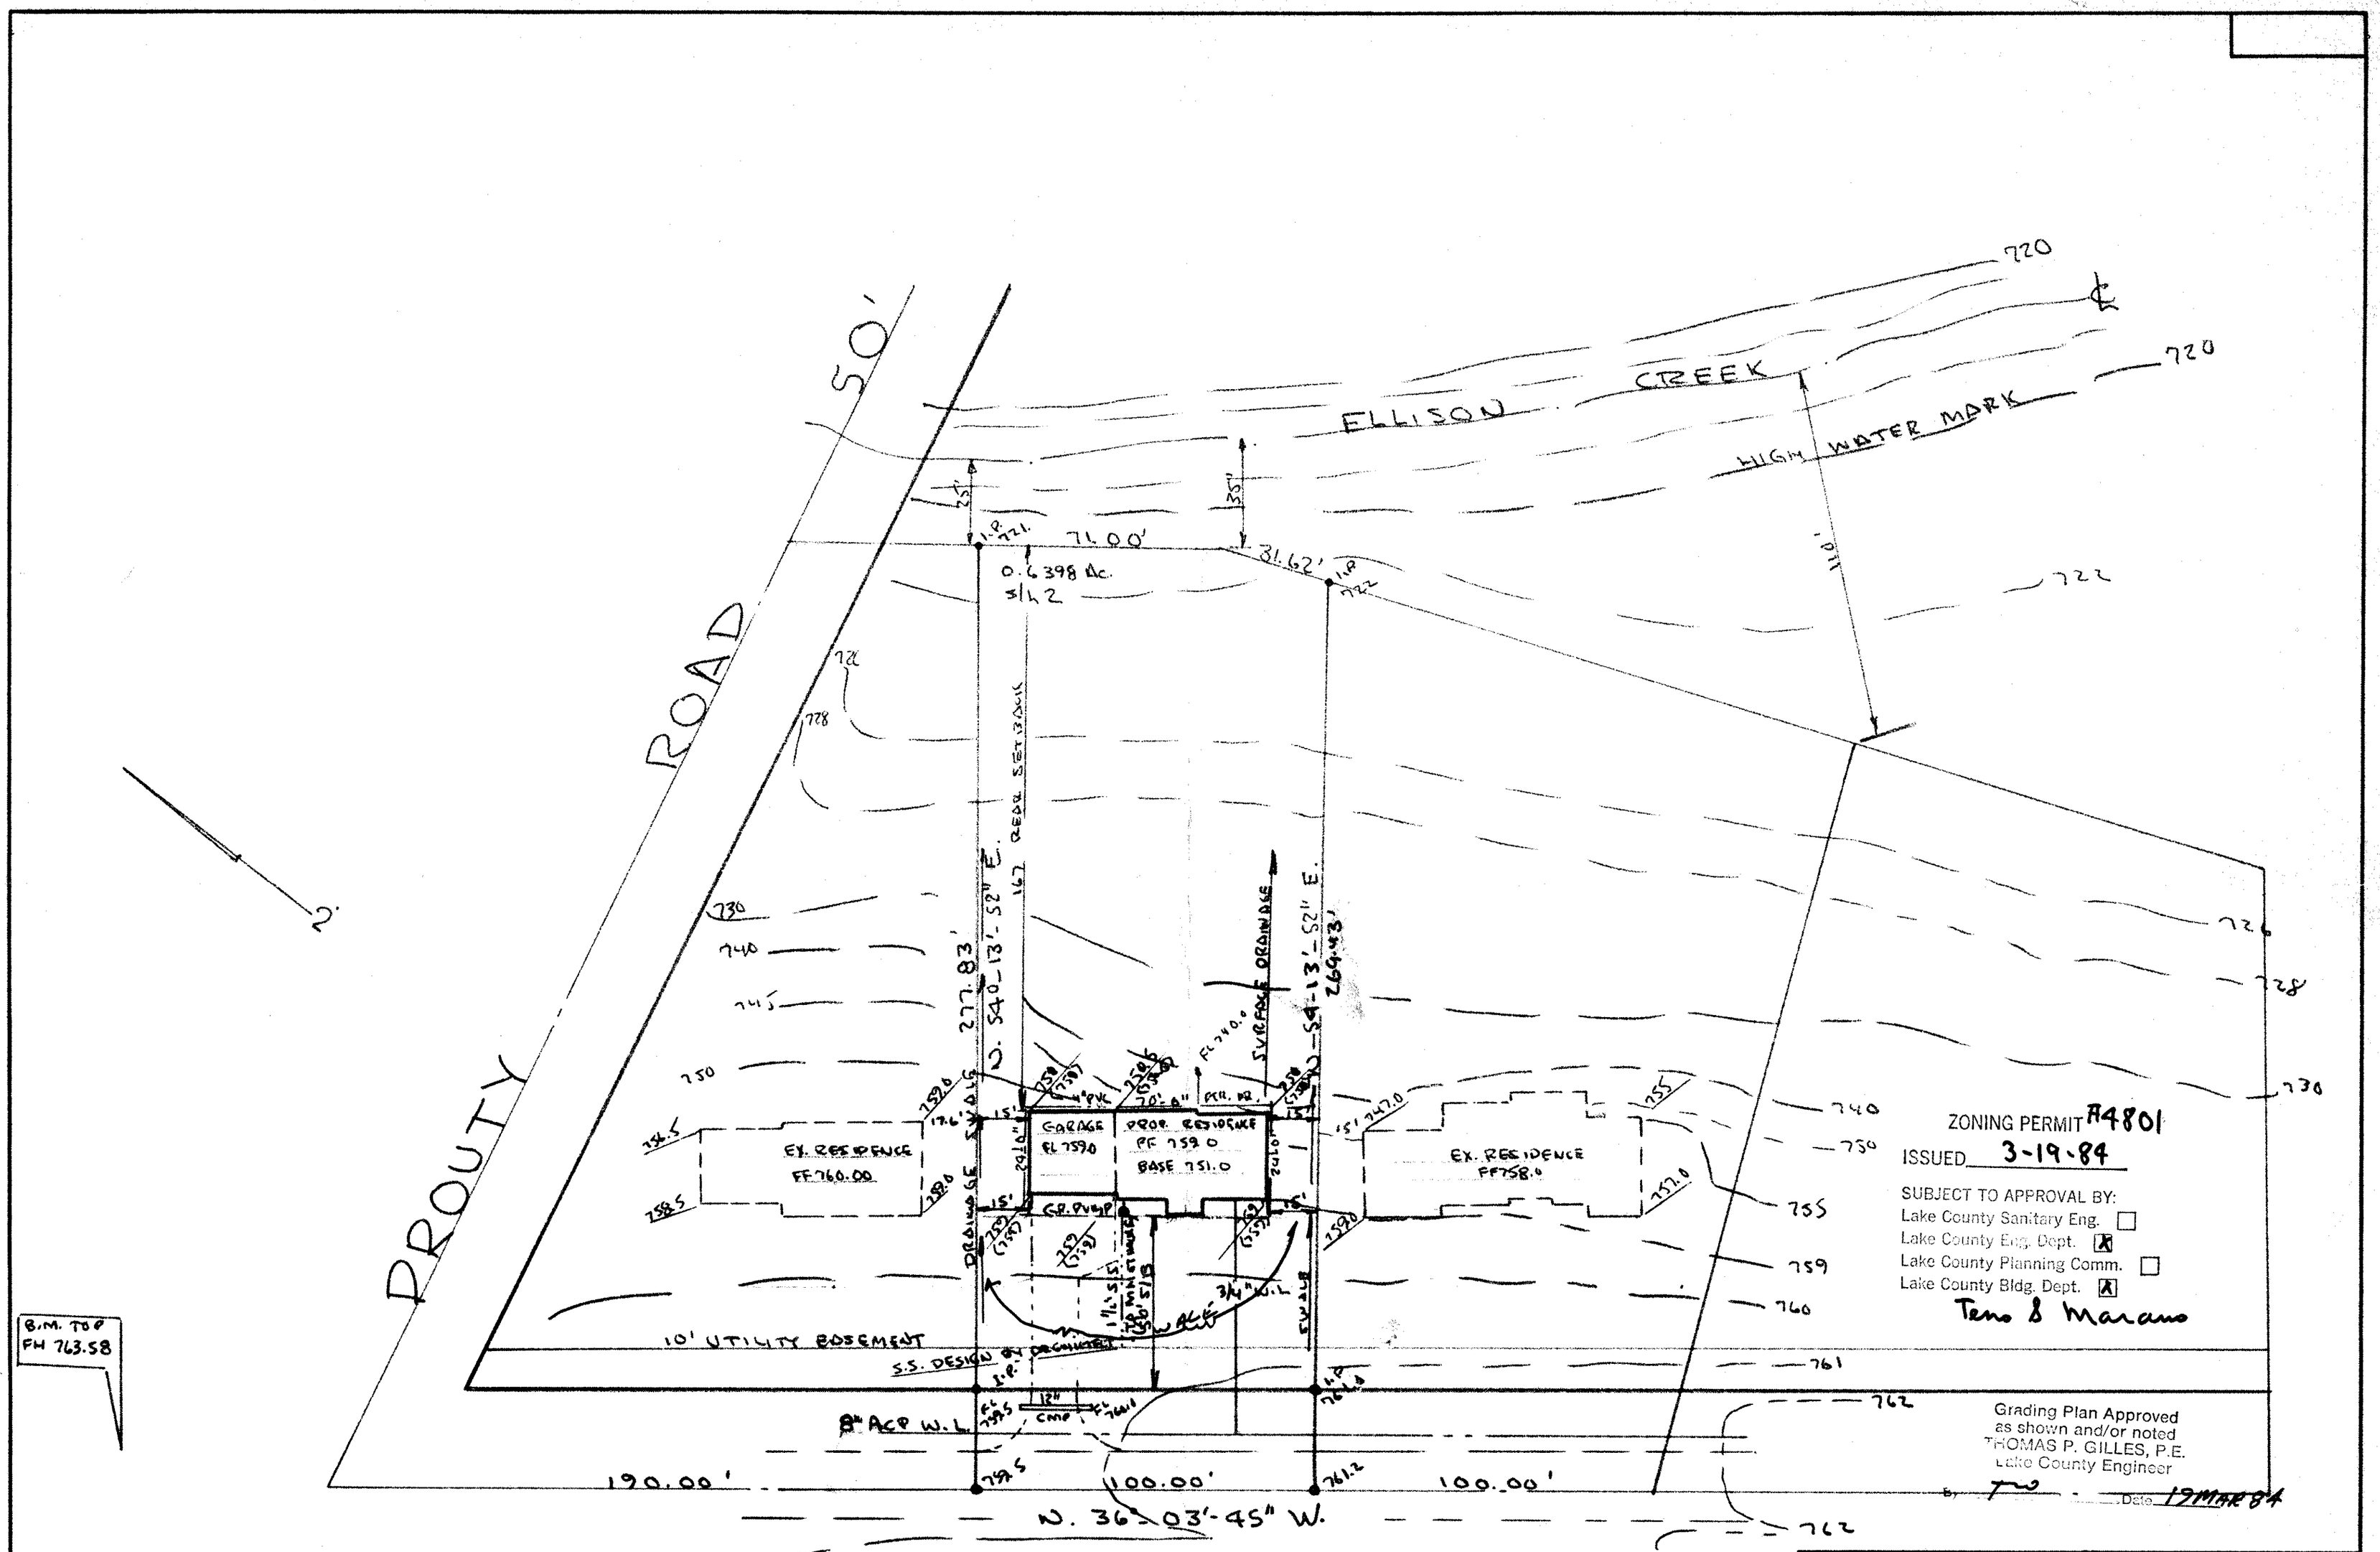

DIETZGEN MASTER FORM 198MF