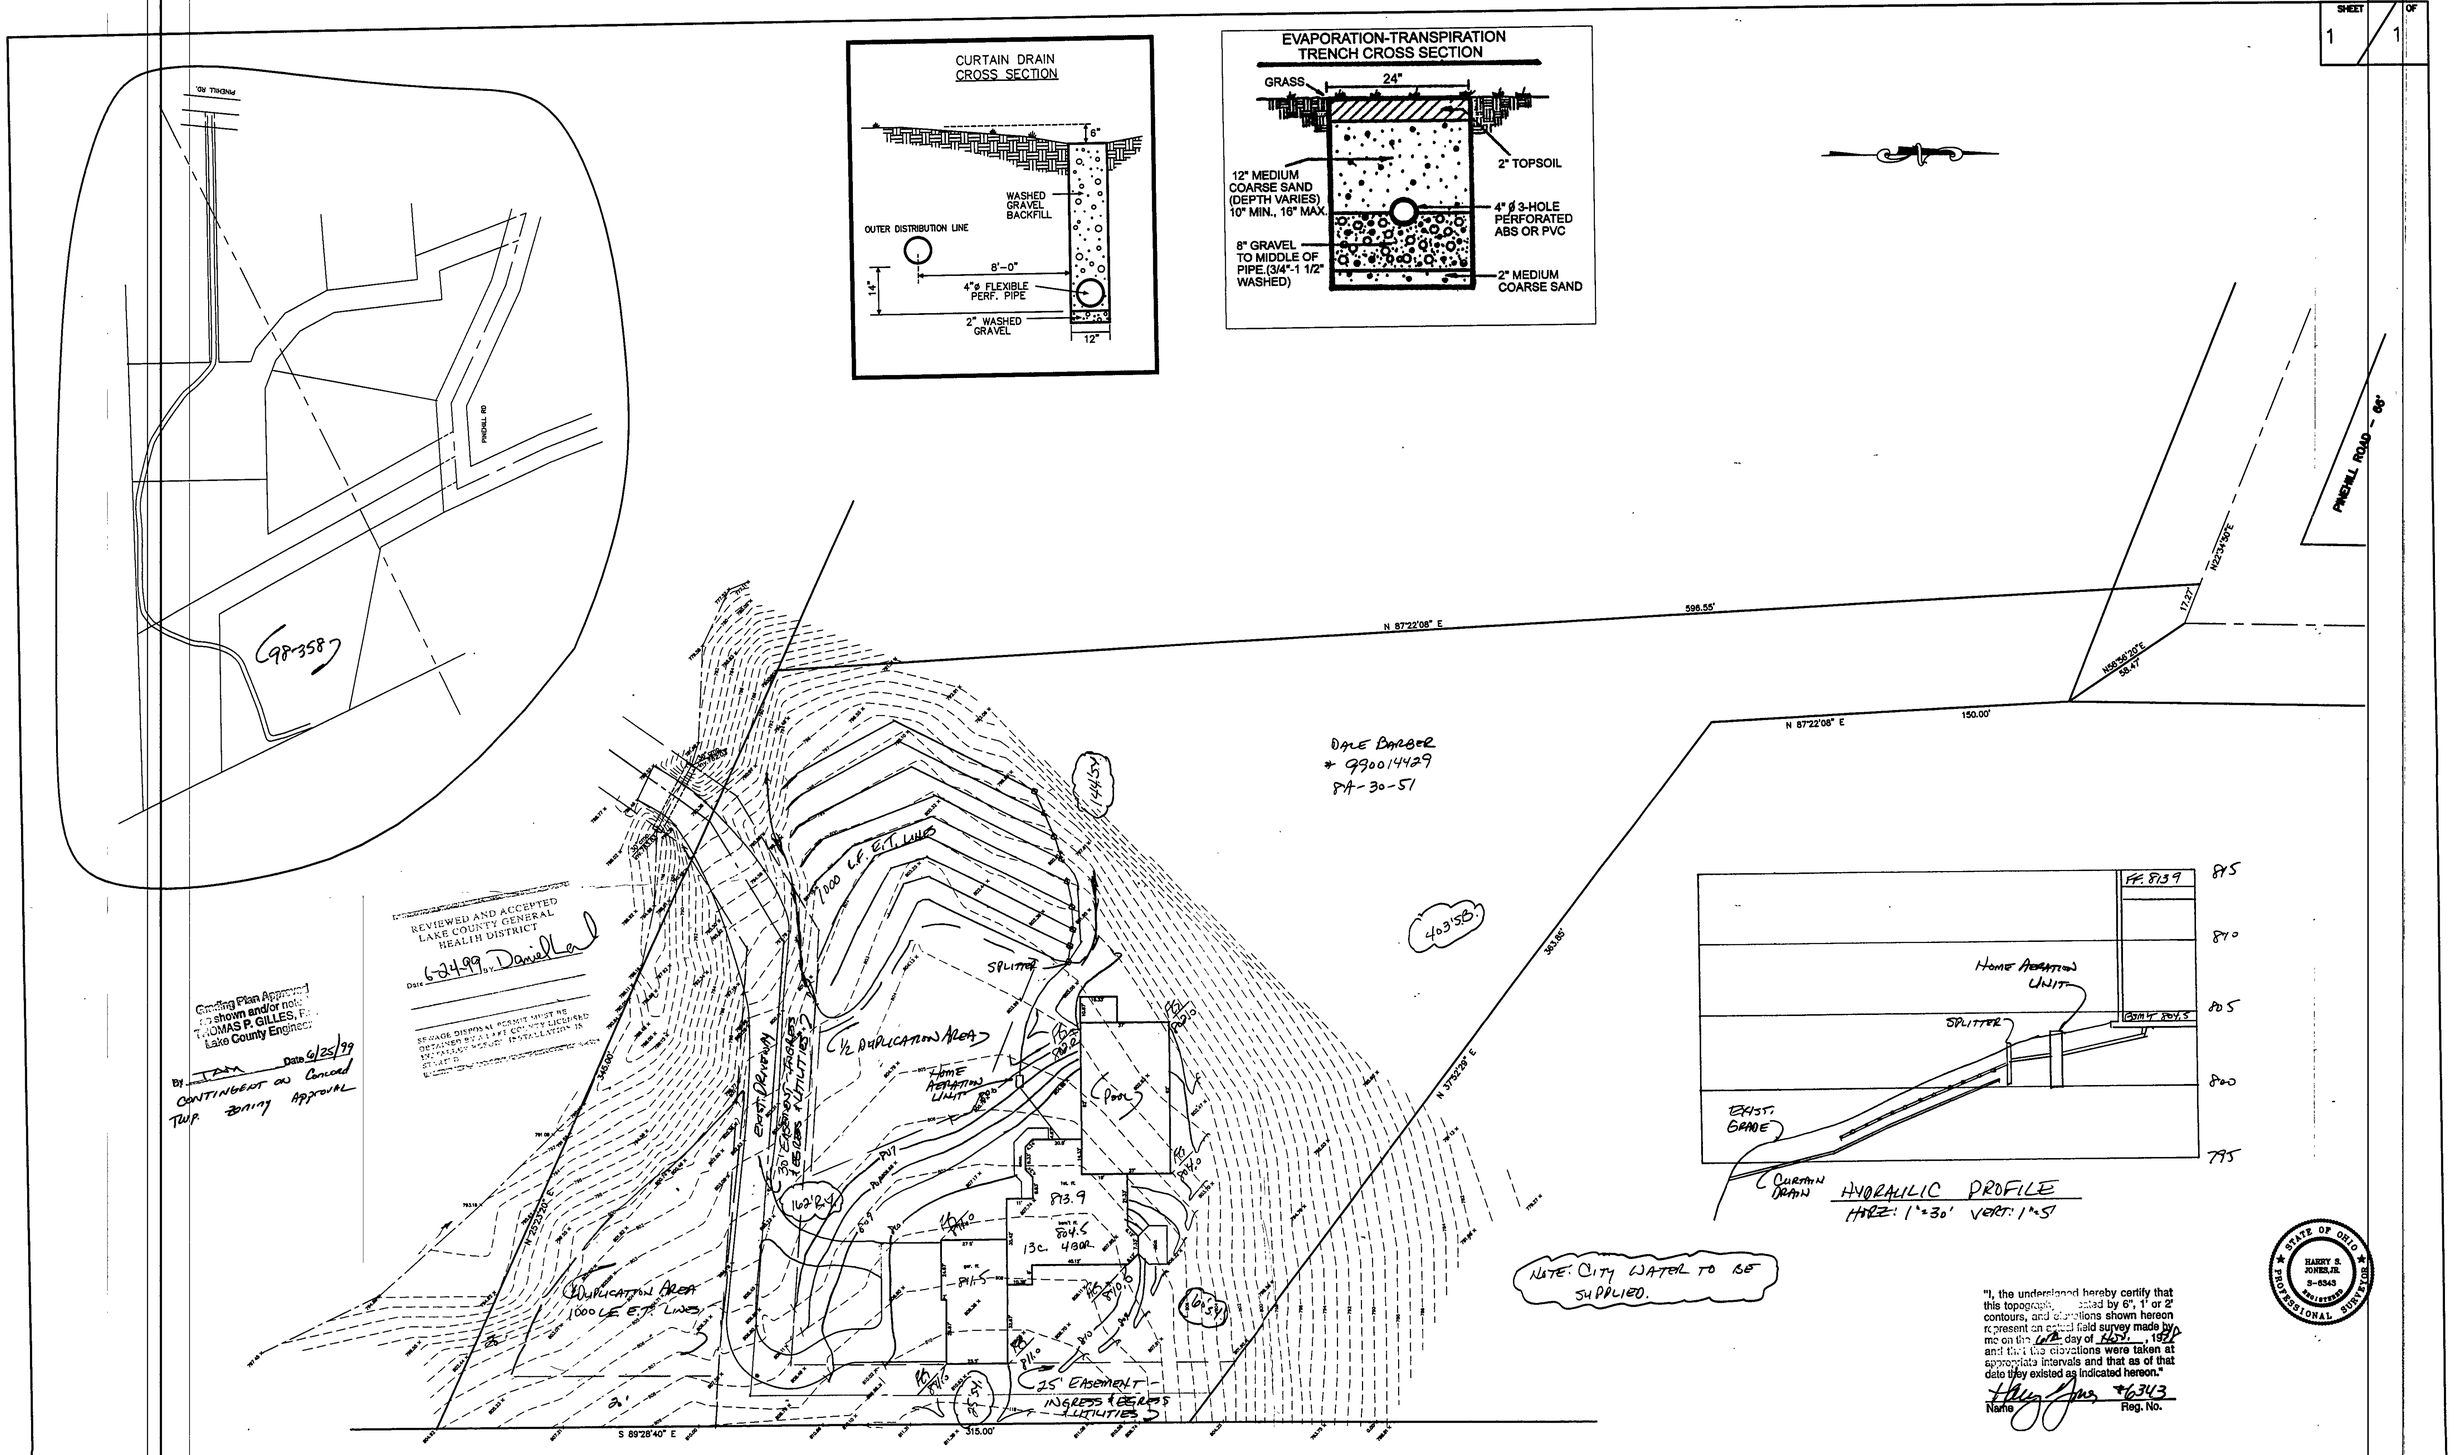

REV NO.	DESCRIPTION	DATE	BY	CHK'D
1	REVISED SEPTIC	6-21-99	AT	HJ

BABCOCK, JONES AND ASSOCIATES, INC
CIVIL ENGINEERS – SURVEYORS – LAND PLANNERS
PAINESVILLE OHIO 44077

DATE	11/7/98
DESIGN BY	H.J.
DRAWN BY	T.R.
APPROVED BY	H.J.

SITE PLAN
FOR
DALE & CINDY BARBER

CONCORD TOWNSHIP LAKE COUNTY

SCALE:	1"=30'
JOB NO	98-358B
SHEET	1 OF 1