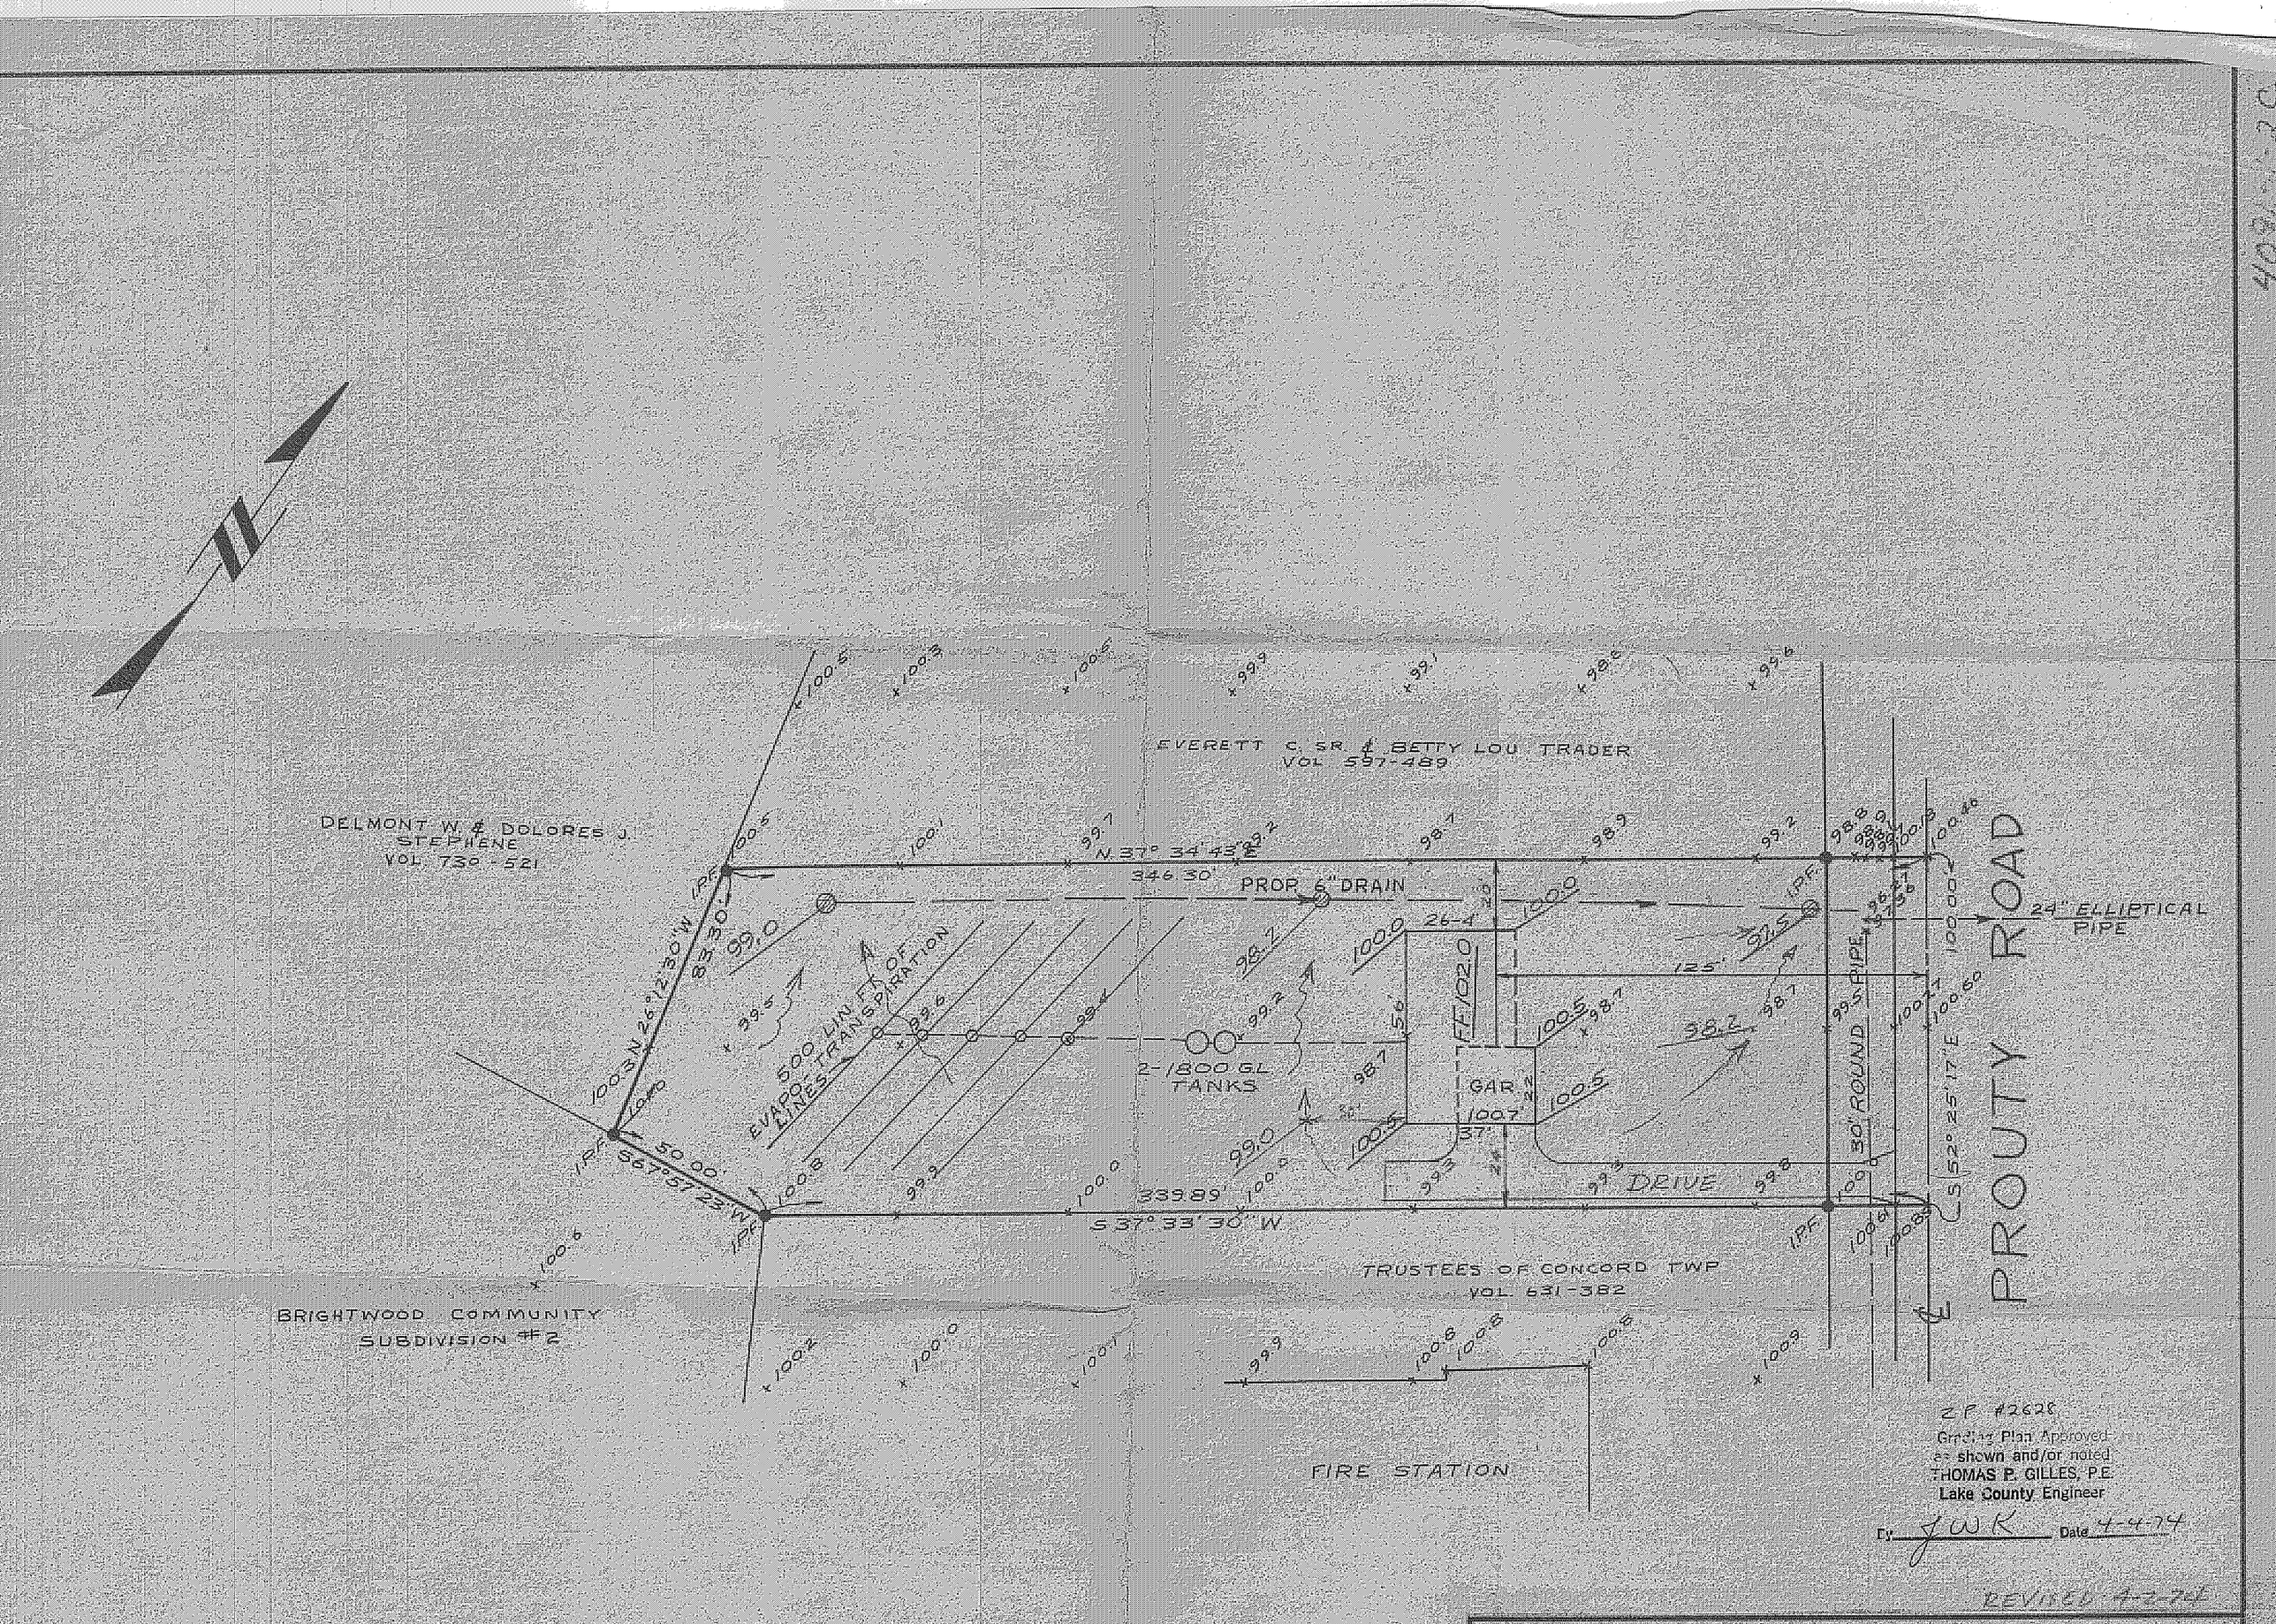

Z.P. #2628
Grading Plan Approved as shown and/or noted
THOMAS P. GILLES, P.E.
Lake County Engineer
By JWK Date 4-4-74

REVISED 4-2-74

SITE PLAN FOR
PAUL HETH
PART OF LOT 33 TRACT 4
CONCORD TWP, LAKE COUNTY, OHIO

Colpetzer · Woods Consultants, Inc.
CONSULTING ENGINEERS AND SURVEYORS
PAINESVILLE, OHIO 44077

DATE 3/19/74
SCALE 1"=30'
DRAWN BY VW
CHK'D BY
PAGE 255 PG 31

4091-1-2C