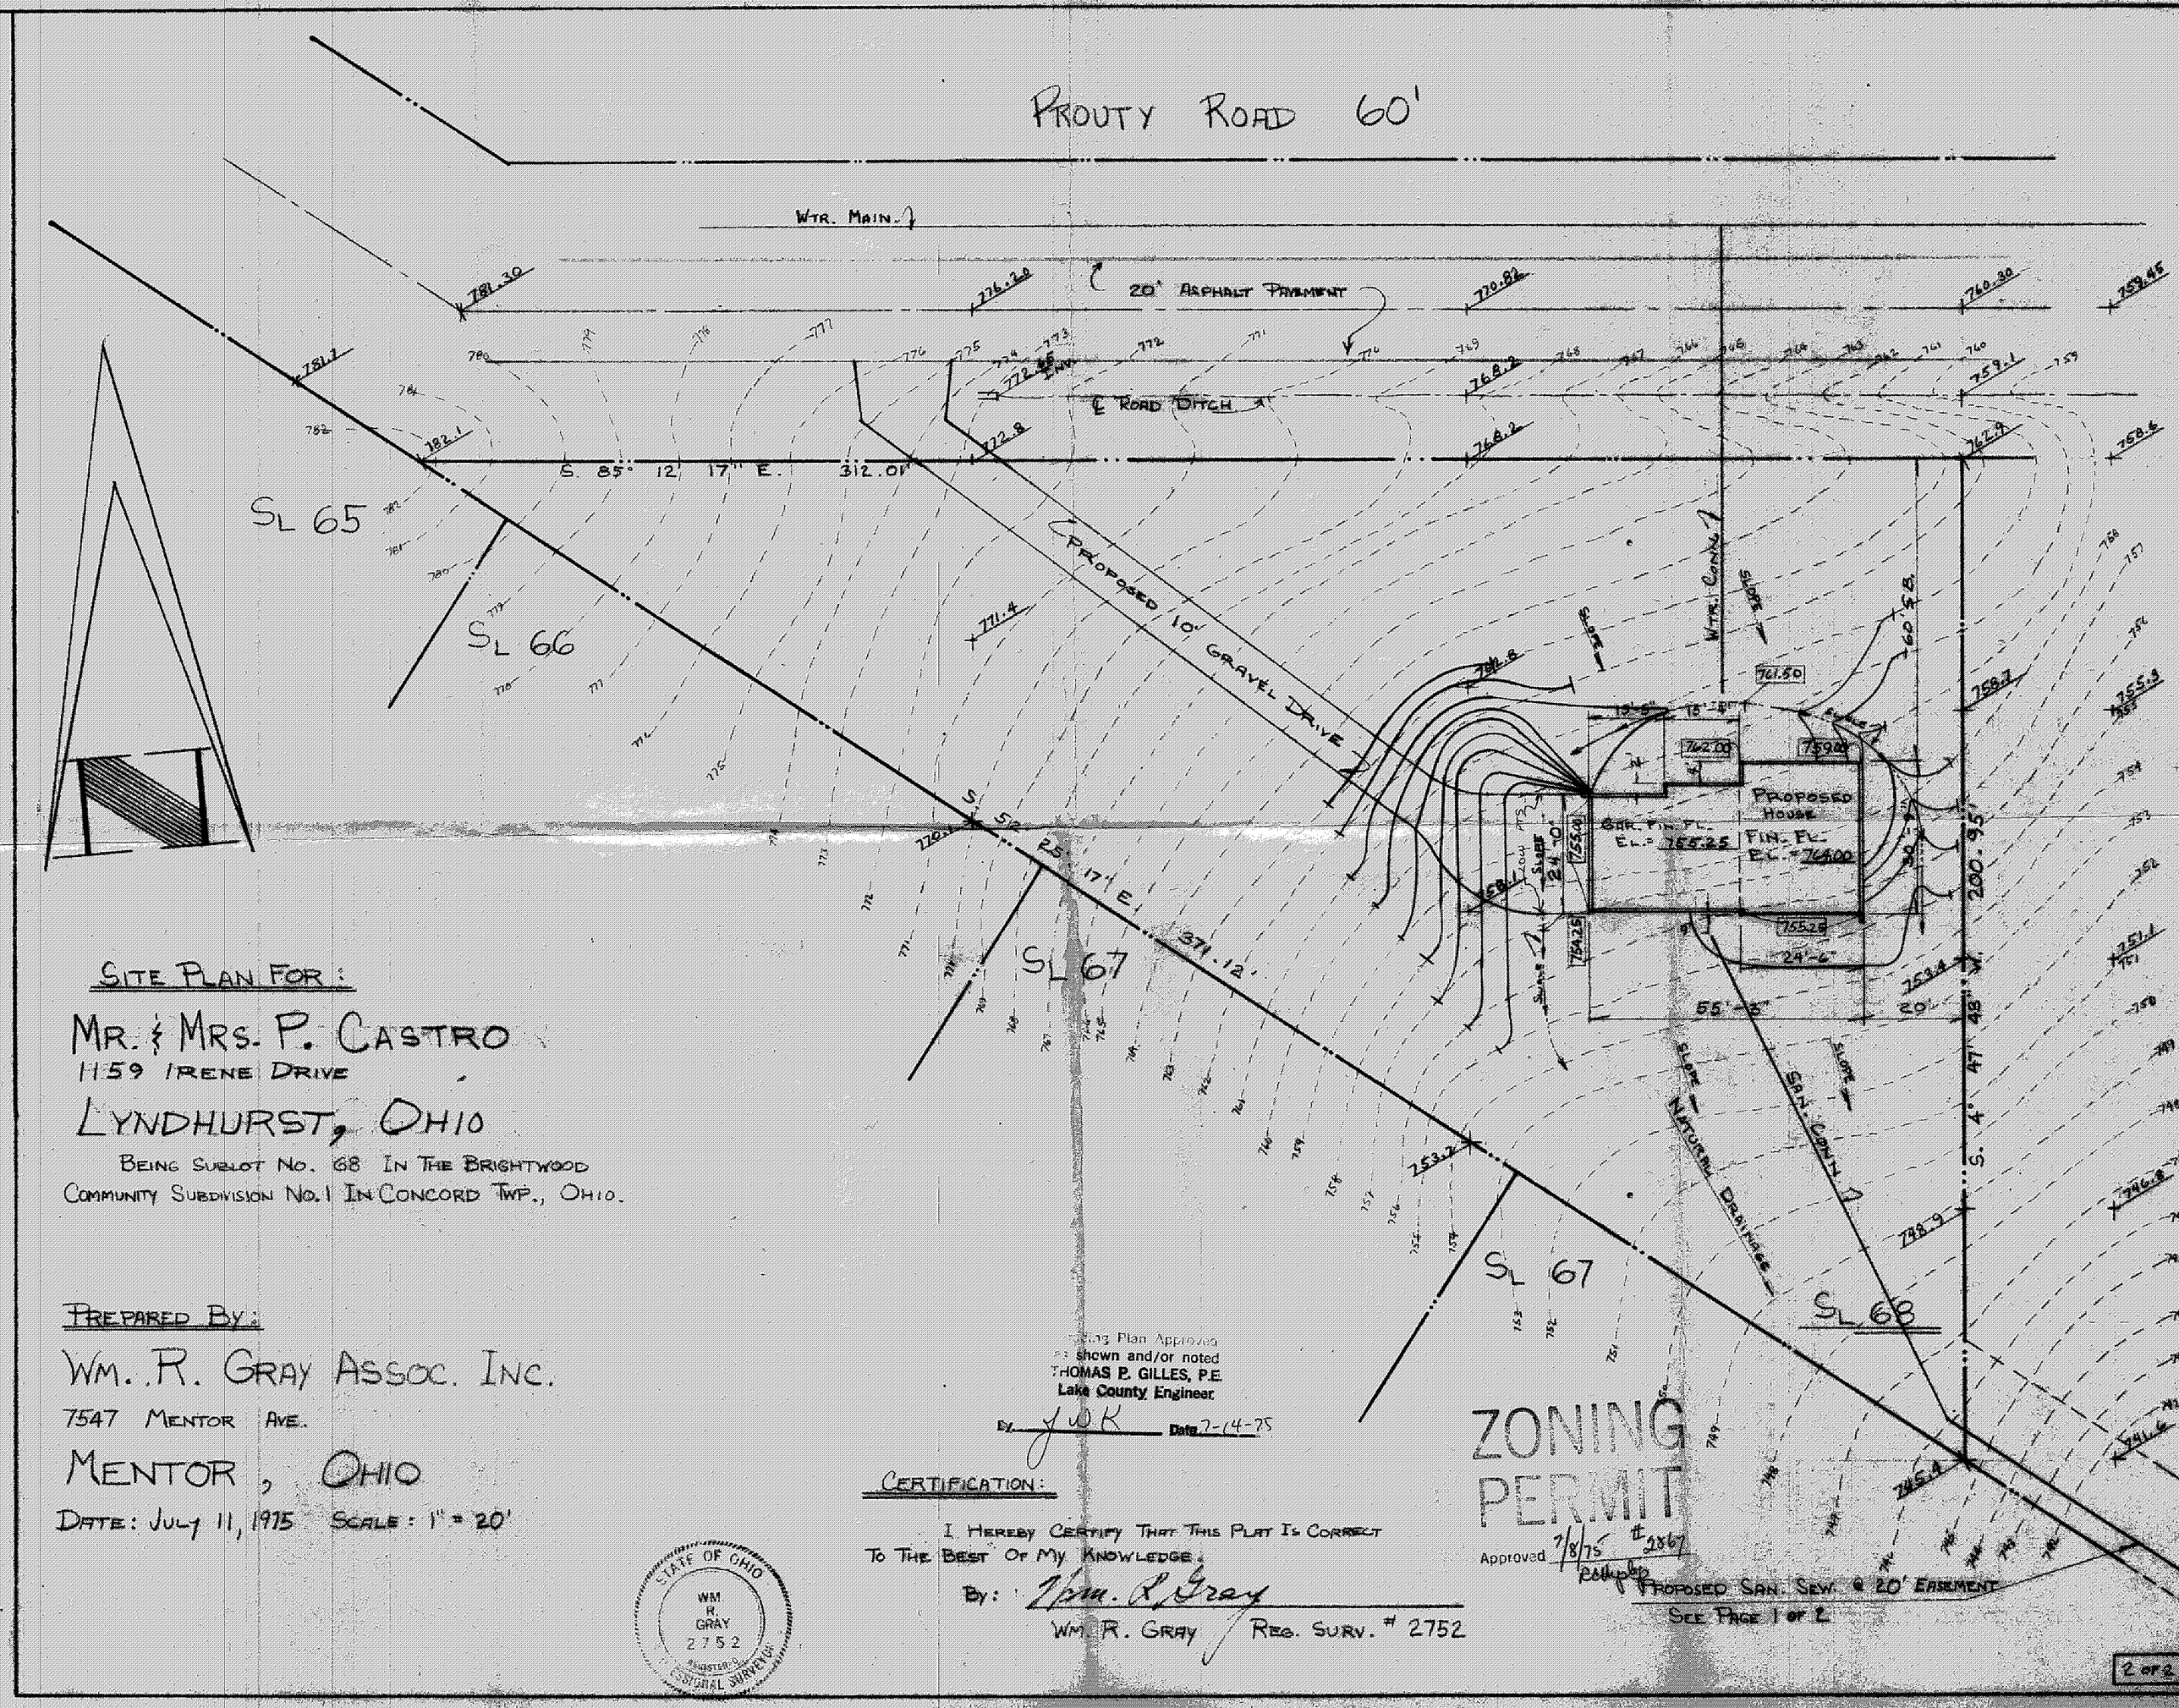

SITE PLAN FOR:

MR. & MRS. P. CASTRO
1159 IRENE DRIVE
LYNDHURST, OHIO
BEING SUBLOT NO. 68 IN THE BRIGHTWOOD COMMUNITY SUBDIVISION NO. 1 IN CONCORD TWP., OHIO.

PREPARED BY:

WM. R. GRAY ASSOC. INC.
7547 MENTOR AVE.
MENTOR, OHIO
DATE: JULY 11, 1975 SCALE: 1" = 20'

Grading Plan Approved as shown and/or noted
THOMAS P. GILLES, P.E.
Lake County Engineer
By JWK Date 7-14-75

CERTIFICATION:

I HEREBY CERTIFY THAT THIS PLAT IS CORRECT TO THE BEST OF MY KNOWLEDGE.

By: Wm. R. Gray
WM. R. GRAY REG. SURV. # 2752

STATE OF OHIO WM. R. GRAY 2752 REGISTERED PROFESSIONAL SURVEYOR