SITE PLAN : PARCEL 8-18A-66

CONCORD TWP. - LAKE COUNTY OHIO

1" = 20"

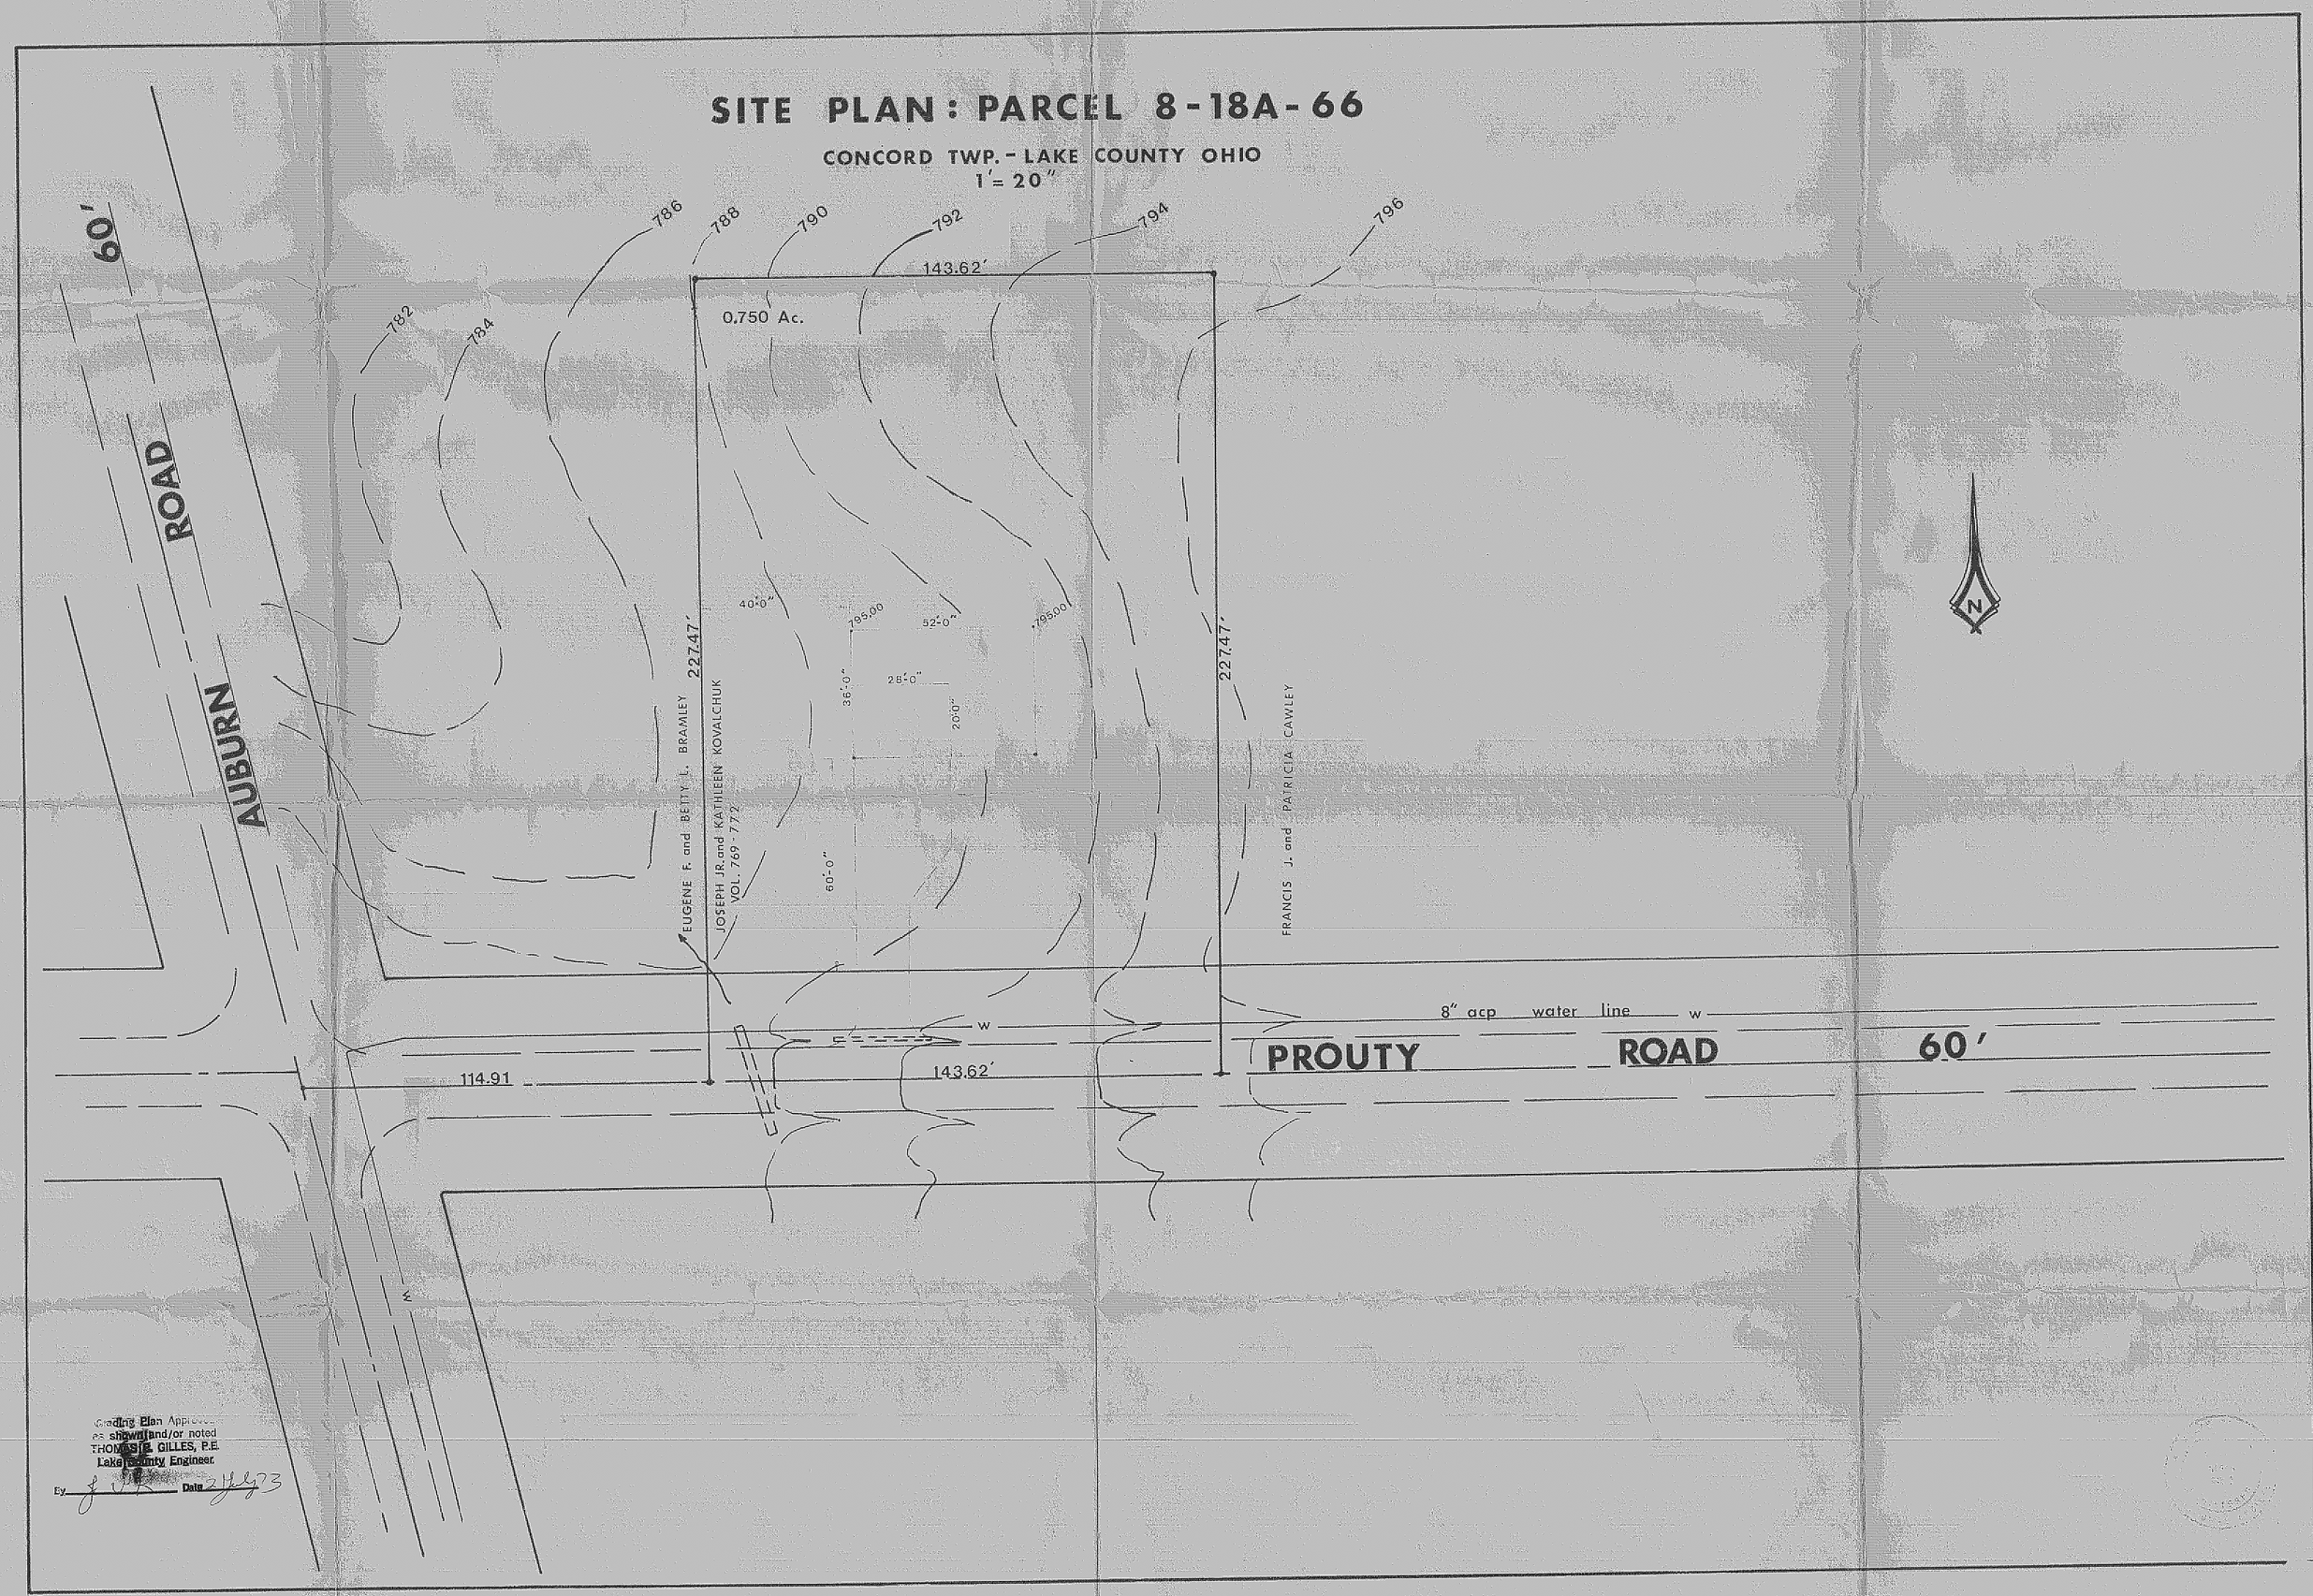

Grading Plan Approved as shown and/or noted
THOMAS E. GILLES, P.E.
Lake County Engineer
By _____ Date 2/4/93