JERRY SLAY, Ohio Surveyor 5298

1-993-7205

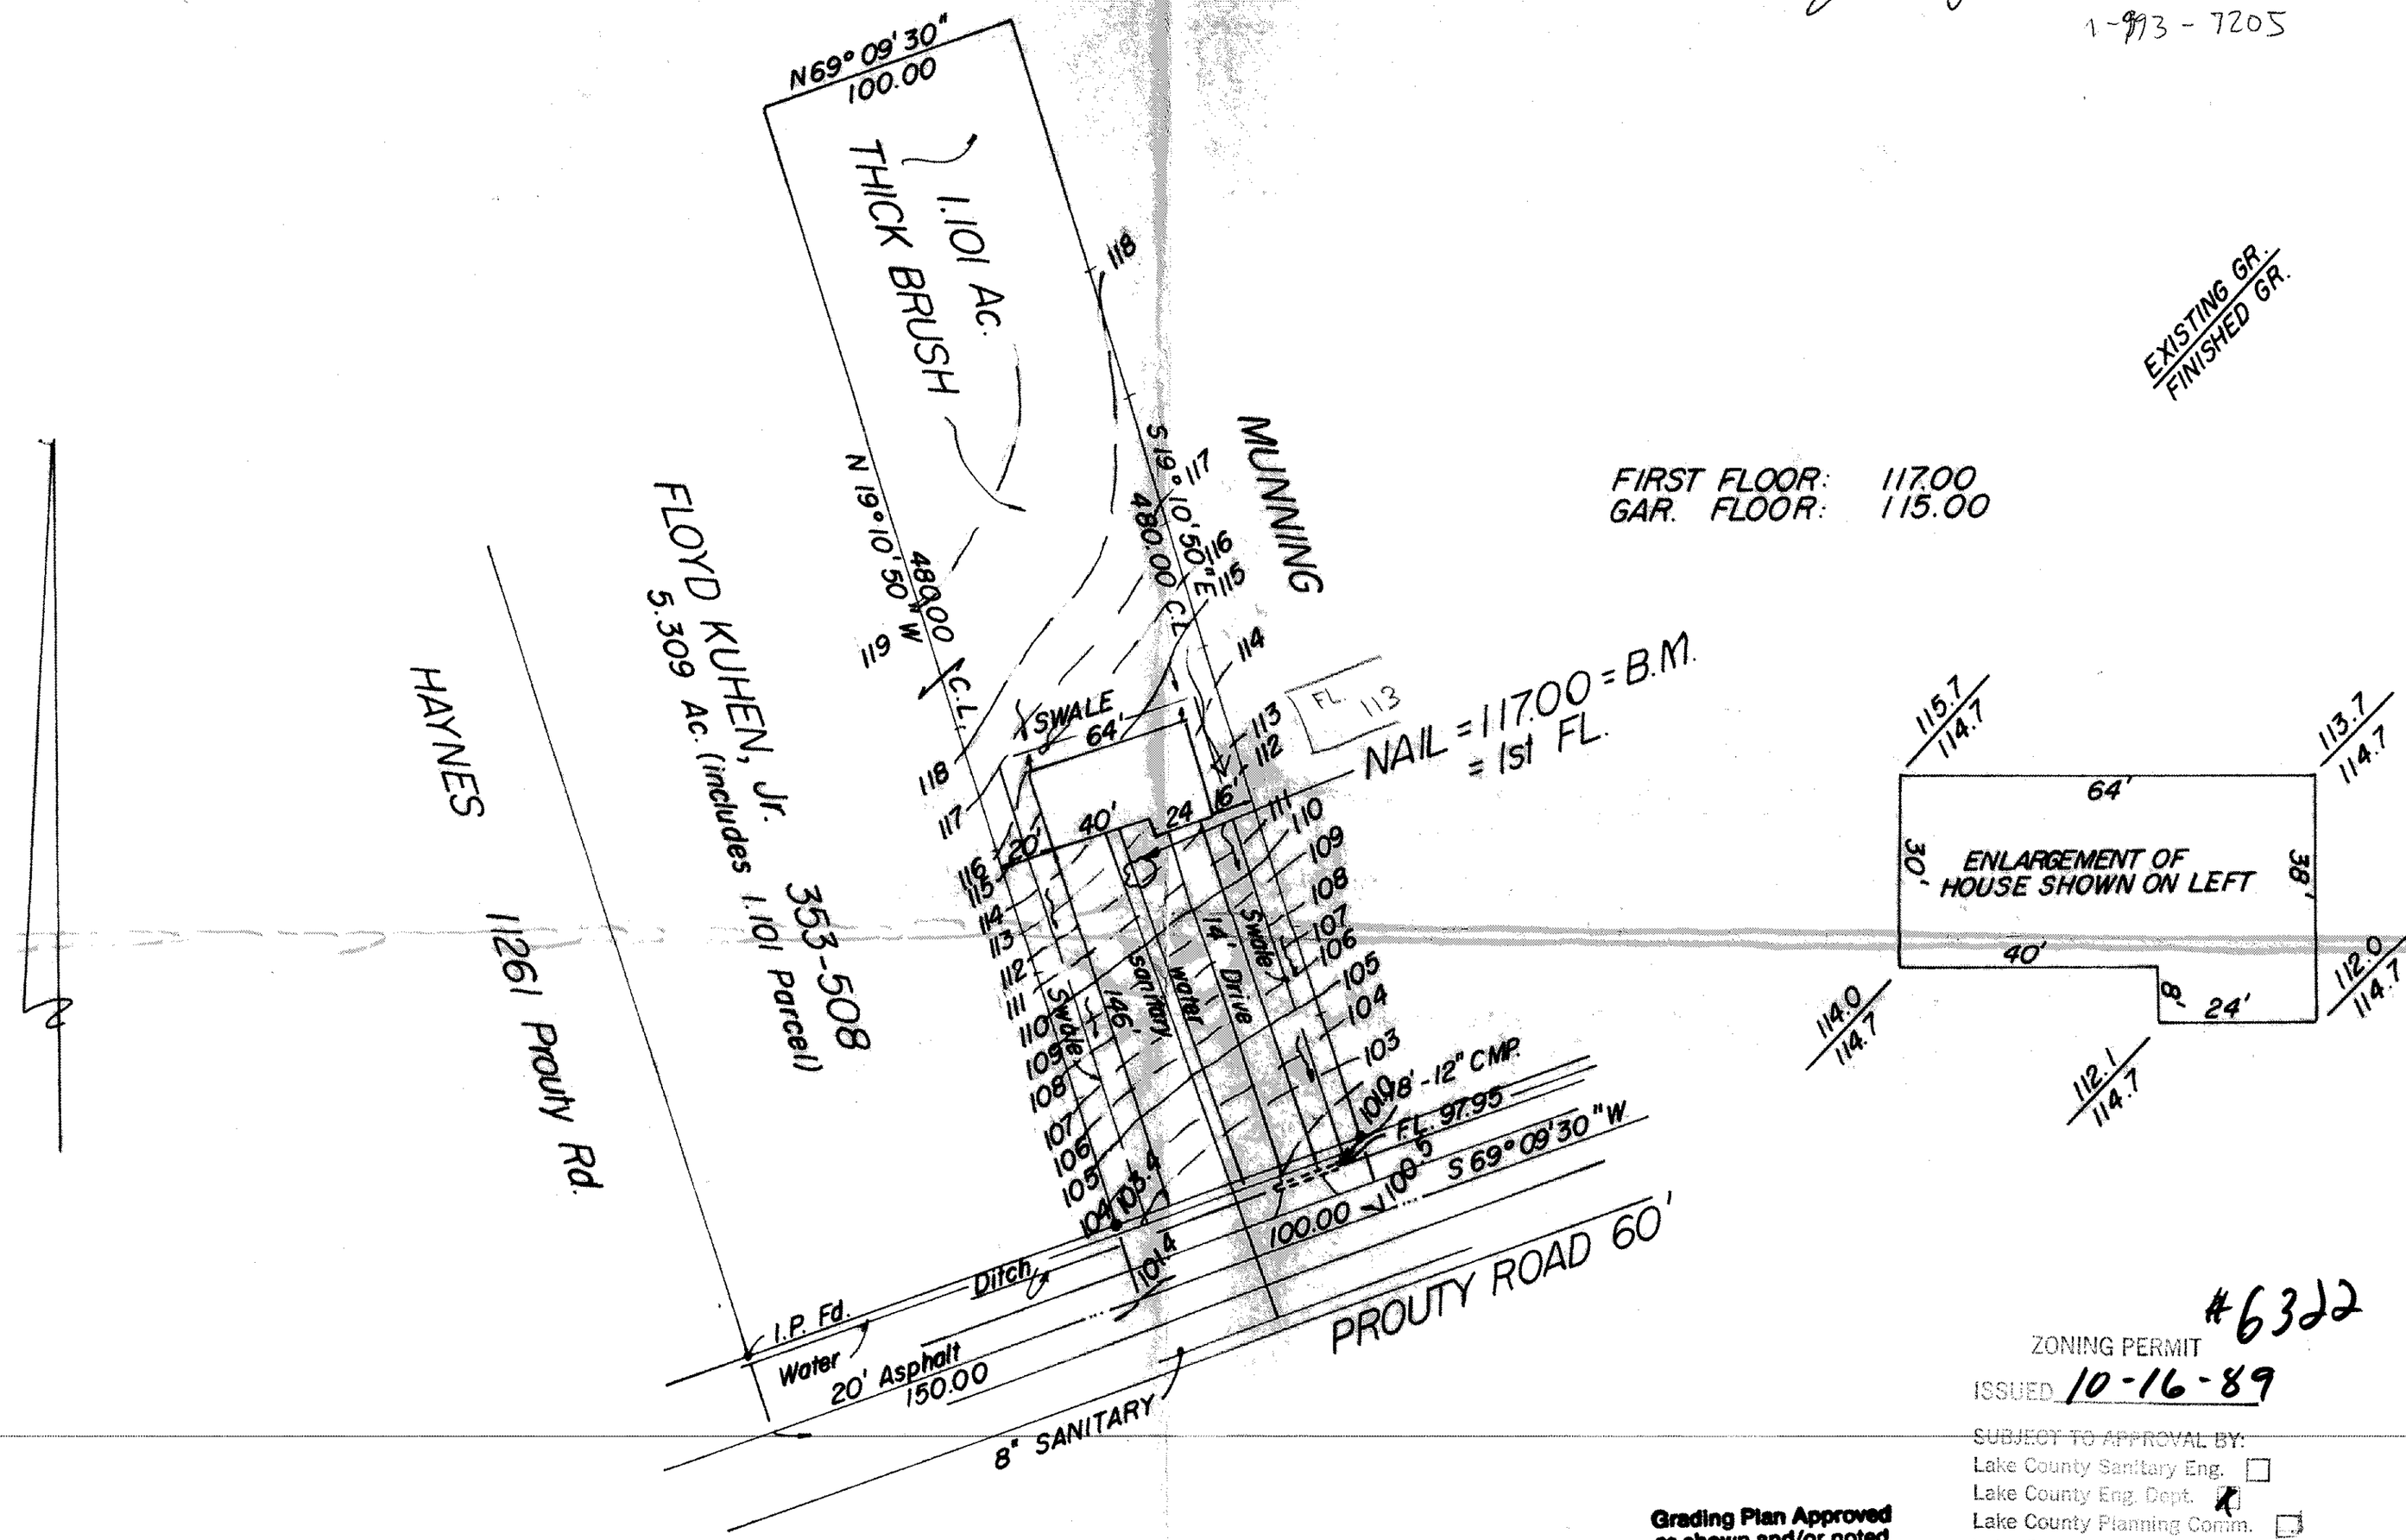

ZONING PERMIT #6322

ISSUED 10-16-89

SUBJECT TO APPROVAL BY:

- Lake County Sanitary Eng. ☐
- Lake County Eng. Dept. ☒
- Lake County Planning Comm. ☐
- Lake County Bldg. Dept. ☒

Grading Plan Approved
as shown and/or noted
THOMAS P. GILLES, P.E.
Lake County Engineer
By GJH Date 10/17/89

1. SWALE ON EAST PROPERTY LINE.

STATE OF OHIO
JERRY SLAY
5298

KUHEN CONSTRUCTION
1119 CASTLETON ROAD
CLEVELAND HTS., OHIO 44121

SCALE: 1" = 50'	APPROVED BY:	DRAWN BY
DATE: 10-16-89		REVISED

LOT 4 TRACT 2 CONCORD TWP.

DRAWING NUMBER