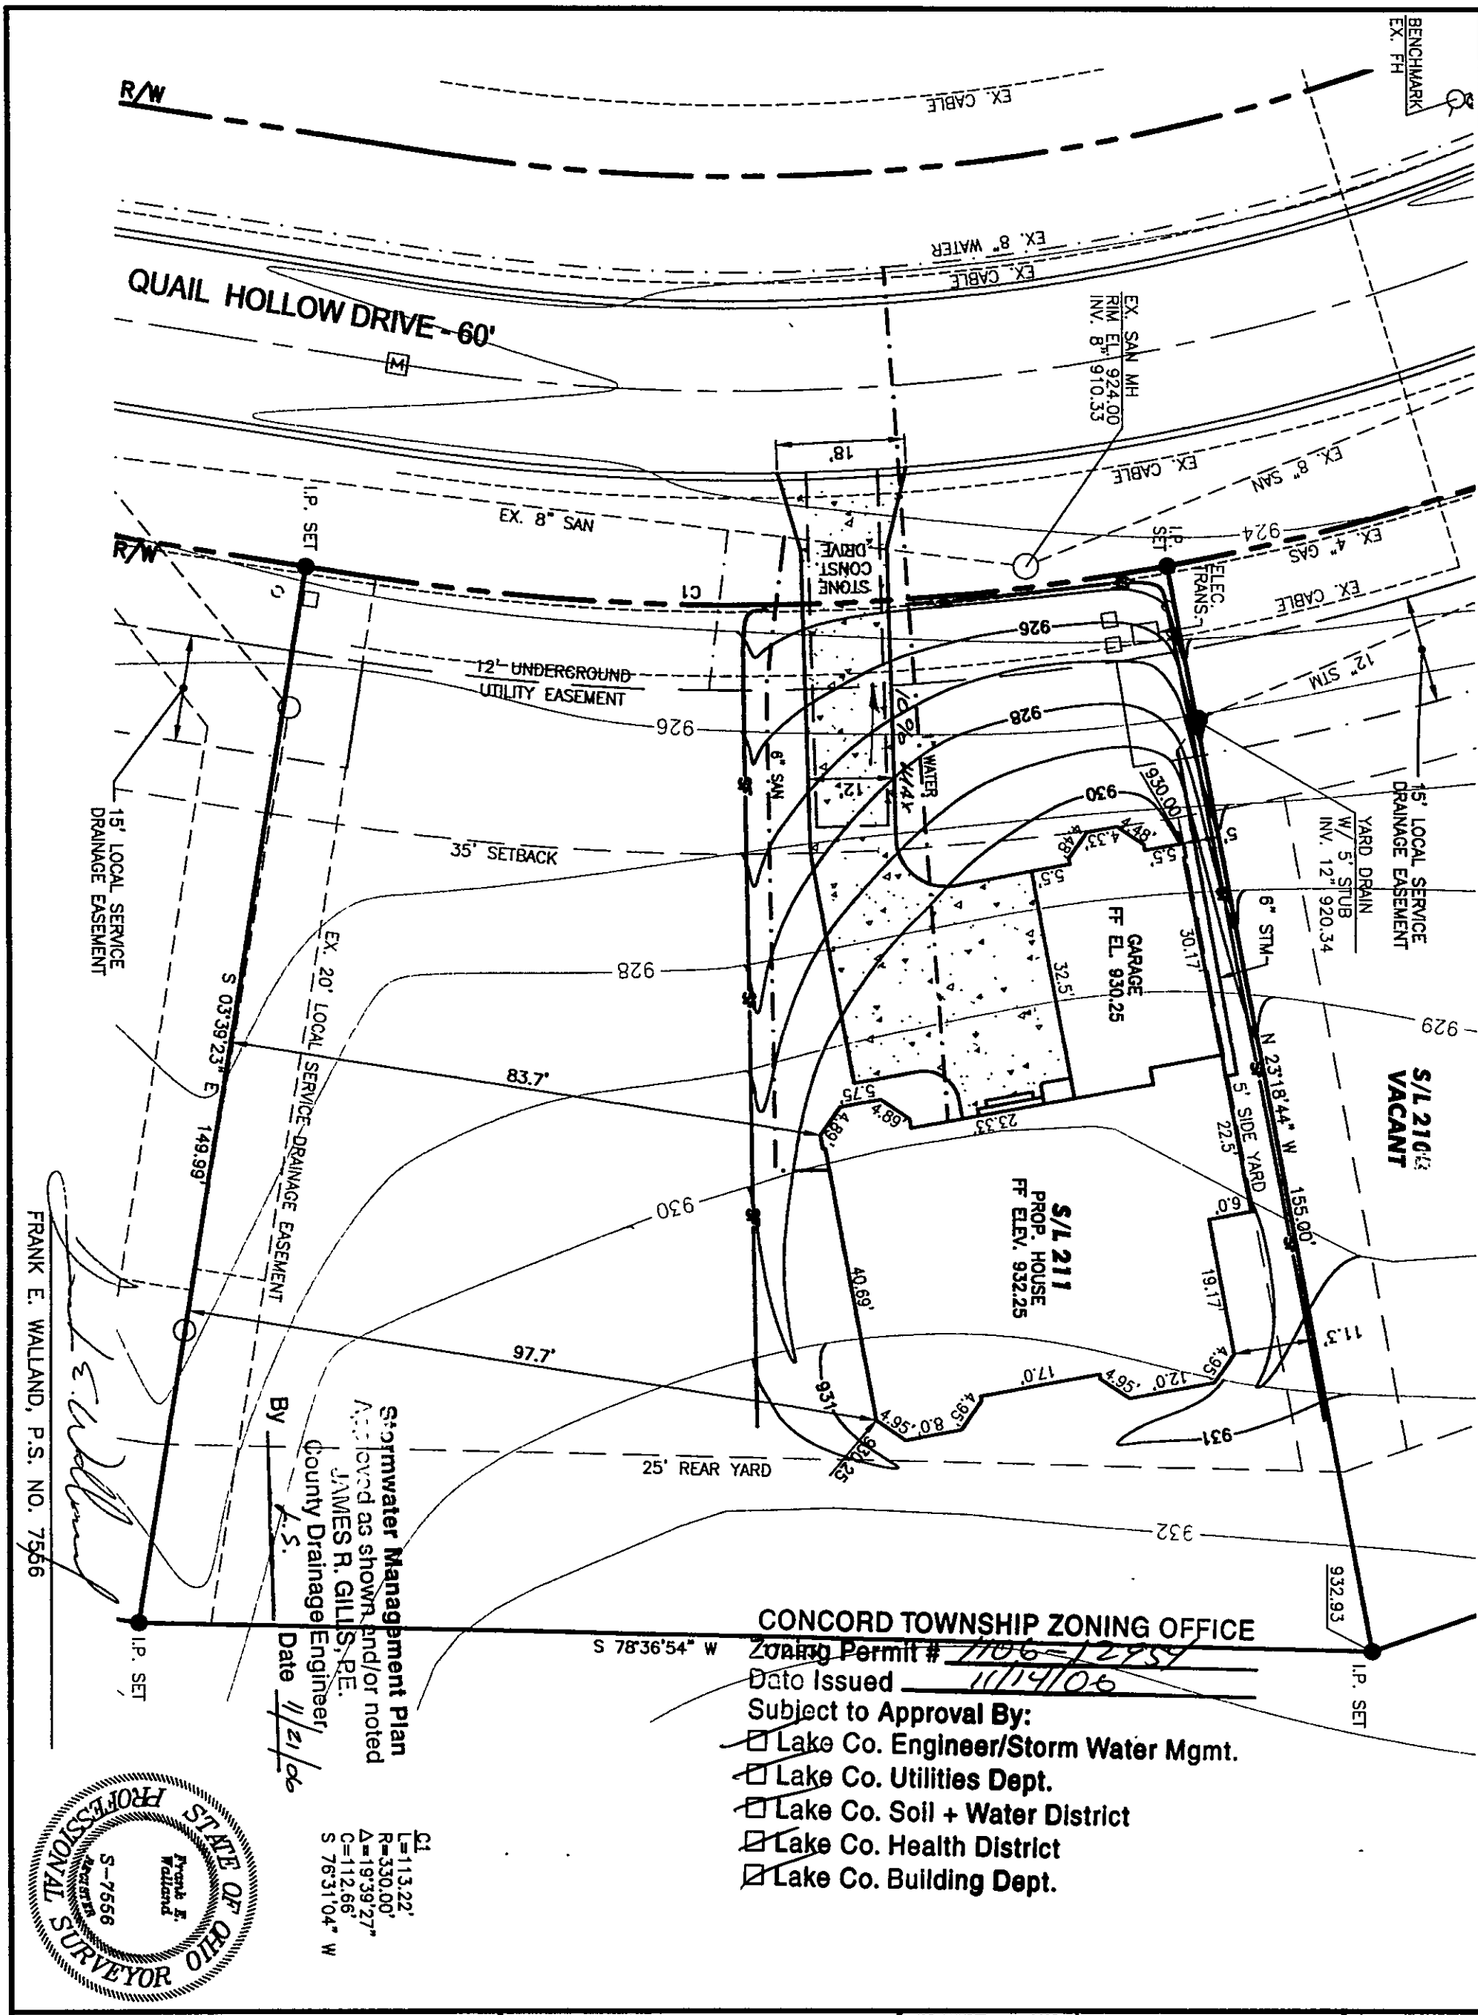

CONCORD TOWNSHIP ZONING OFFICE
Zoning Permit # 1106-12954
Date Issued 11/14/06
Subject to Approval By:
- ☐ Lake Co. Engineer/Storm Water Mgmt.
- ☐ Lake Co. Utilities Dept.
- ☐ Lake Co. Soil + Water District
- ☐ Lake Co. Health District
- ☐ Lake Co. Building Dept.

SITE PLAN
QUAIL HOLLOW NO. 5
SUBLOT 211
CONCORD TOWNSHIP - LAKE COUNTY - OHIO

oxbow Engineering, Inc.
10 West Erie Street, Suite 201 Painesville, Ohio 44077
Phone (440) 352-9556\942-0941 Fax (440) 352-9196
oxbowengineering@sbcglobal.net

JOB NUMBER:	08031
DATE:	11-14-06
DRAWN BY:	S L S
CHECKED BY:	F E W

0 10 20 30 40
SCALE: 1"=20'

NO.	REVISION	BY	DATE