SITE & DRAINAGE PLAN FOR:

RYAN HOMES, INC.
7660 CHIPPEWA ROAD
BRECKSVILLE, OH.

BEING SUBLOT No. 15 IN REVERE WOODS SUBDIVISION NO. 2 IN CONCORD TWP. OHIO.

PREPARED BY:

WM. R. GRAY ASSOC., INC.
7547 MENTOR AVENUE
MENTOR, OHIO.

CIVIL ENGINEERS
SURVEYORS

Grading Plan Approved as shown and/or noted
THOMAS P. GILLES, P.E.
Lake County Engineer
By JWK Date 9-17-73

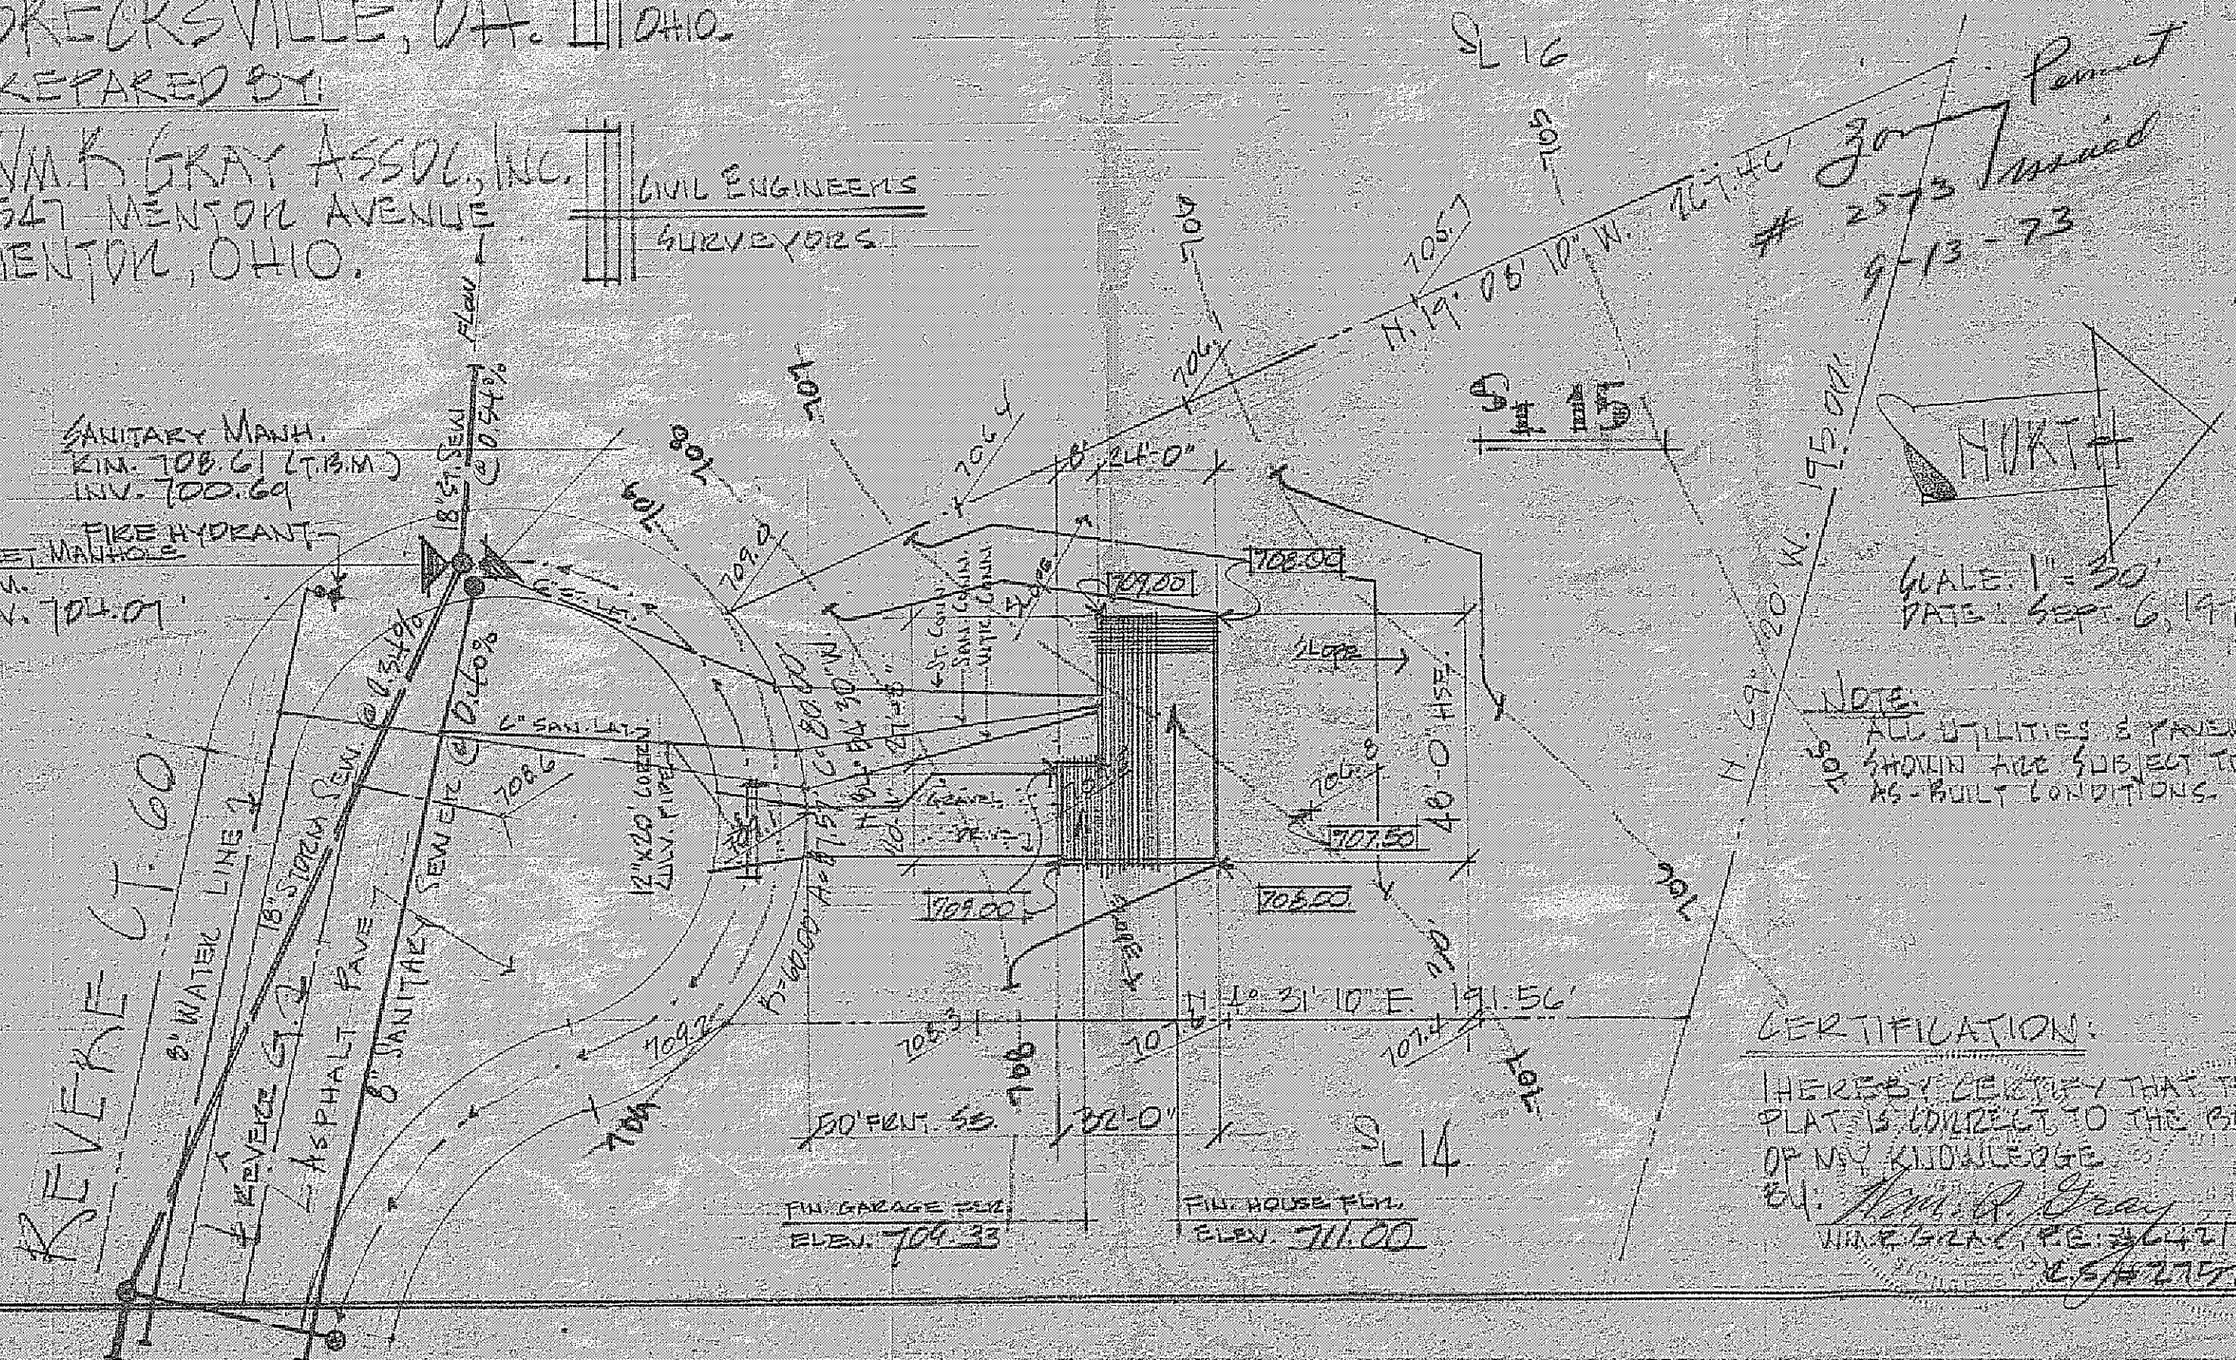

NOTE:
ALL UTILITIES & PAVEMENT SHOWN ARE SUBJECT TO AS-BUILT CONDITIONS.

CERTIFICATION:
I HEREBY CERTIFY THAT THIS PLAT IS CORRECT TO THE BEST OF MY KNOWLEDGE.
BY: Wm. R. Gray
WM. R. GRAY, P.E. #6421
R.S. #2752