BUILDING SITE PLAN FOR
ROY SLAYTON & SON BUILDERS
SUBLOT No. 17 - JOHNNYCAKE LAKES ESTATES
CONCORD TOWNSHIP - LAKE COUNTY - OHIO
Scale 1" = 40'   Feb 7, 1974
Joseph D. Hadden - Reg. Surveyor

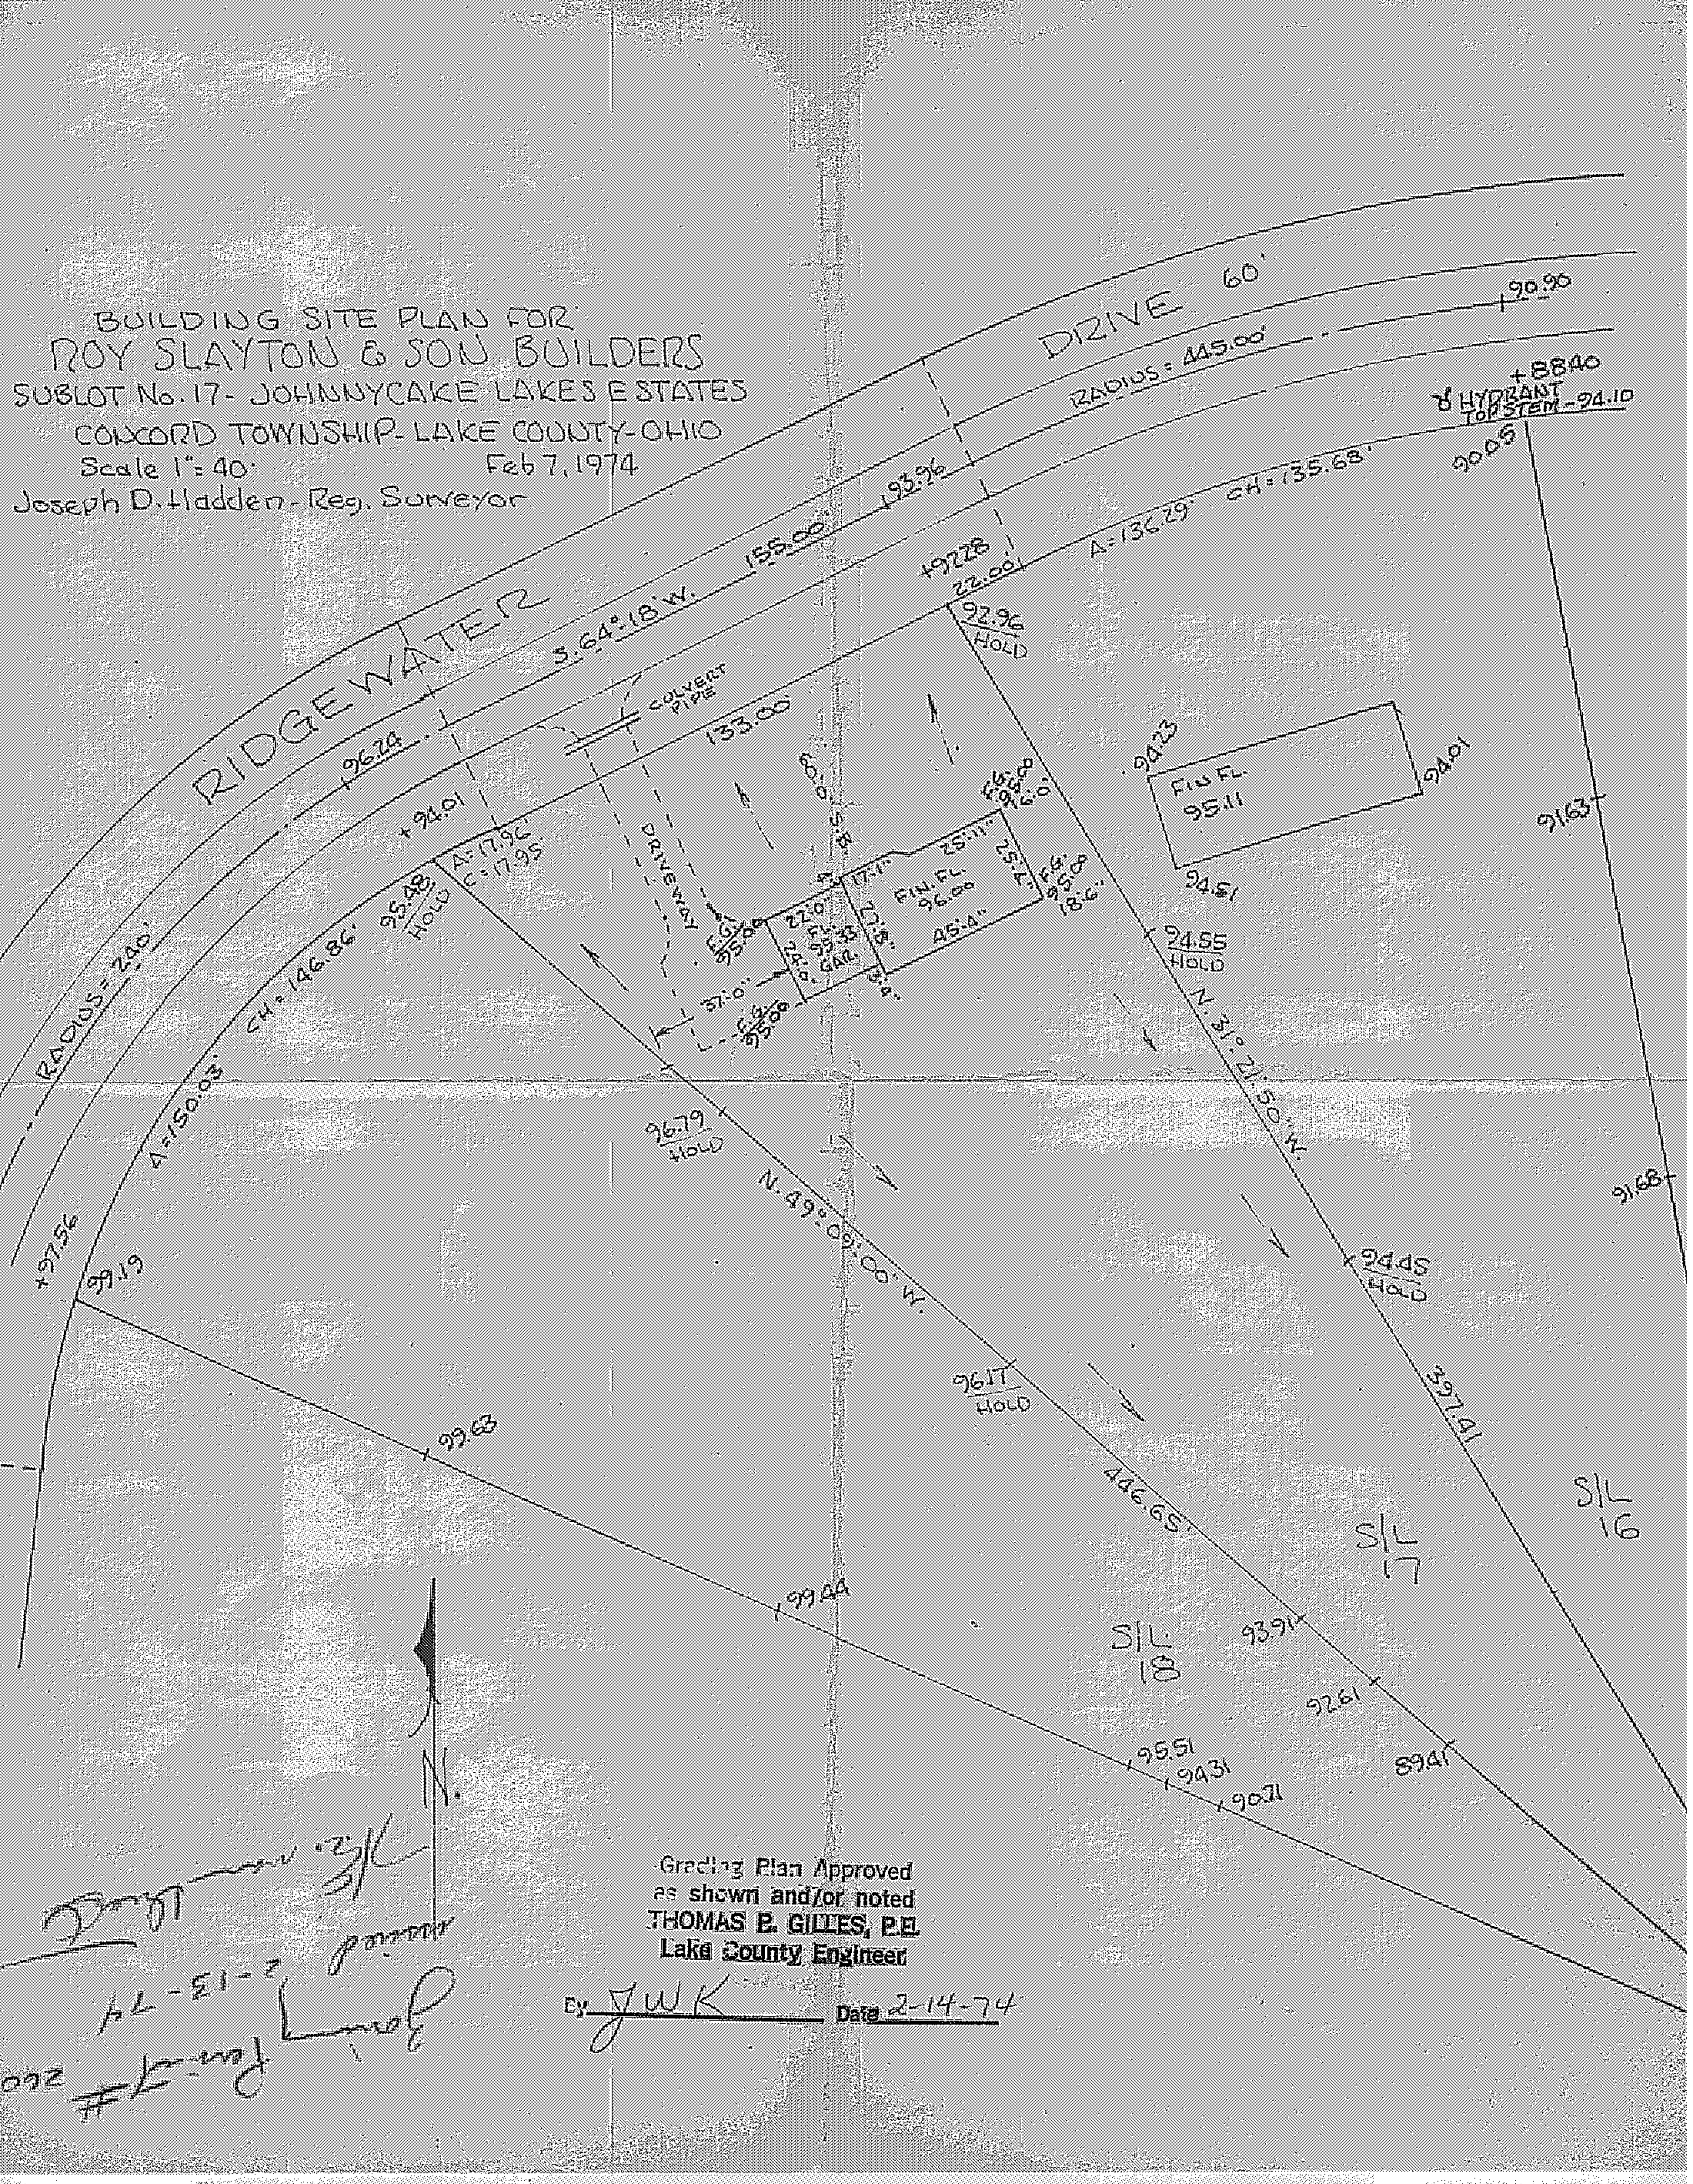

Grading Plan Approved
as shown and/or noted
THOMAS P. GILLES, P.E.
Lake County Engineer

By JWK Date 2-14-74