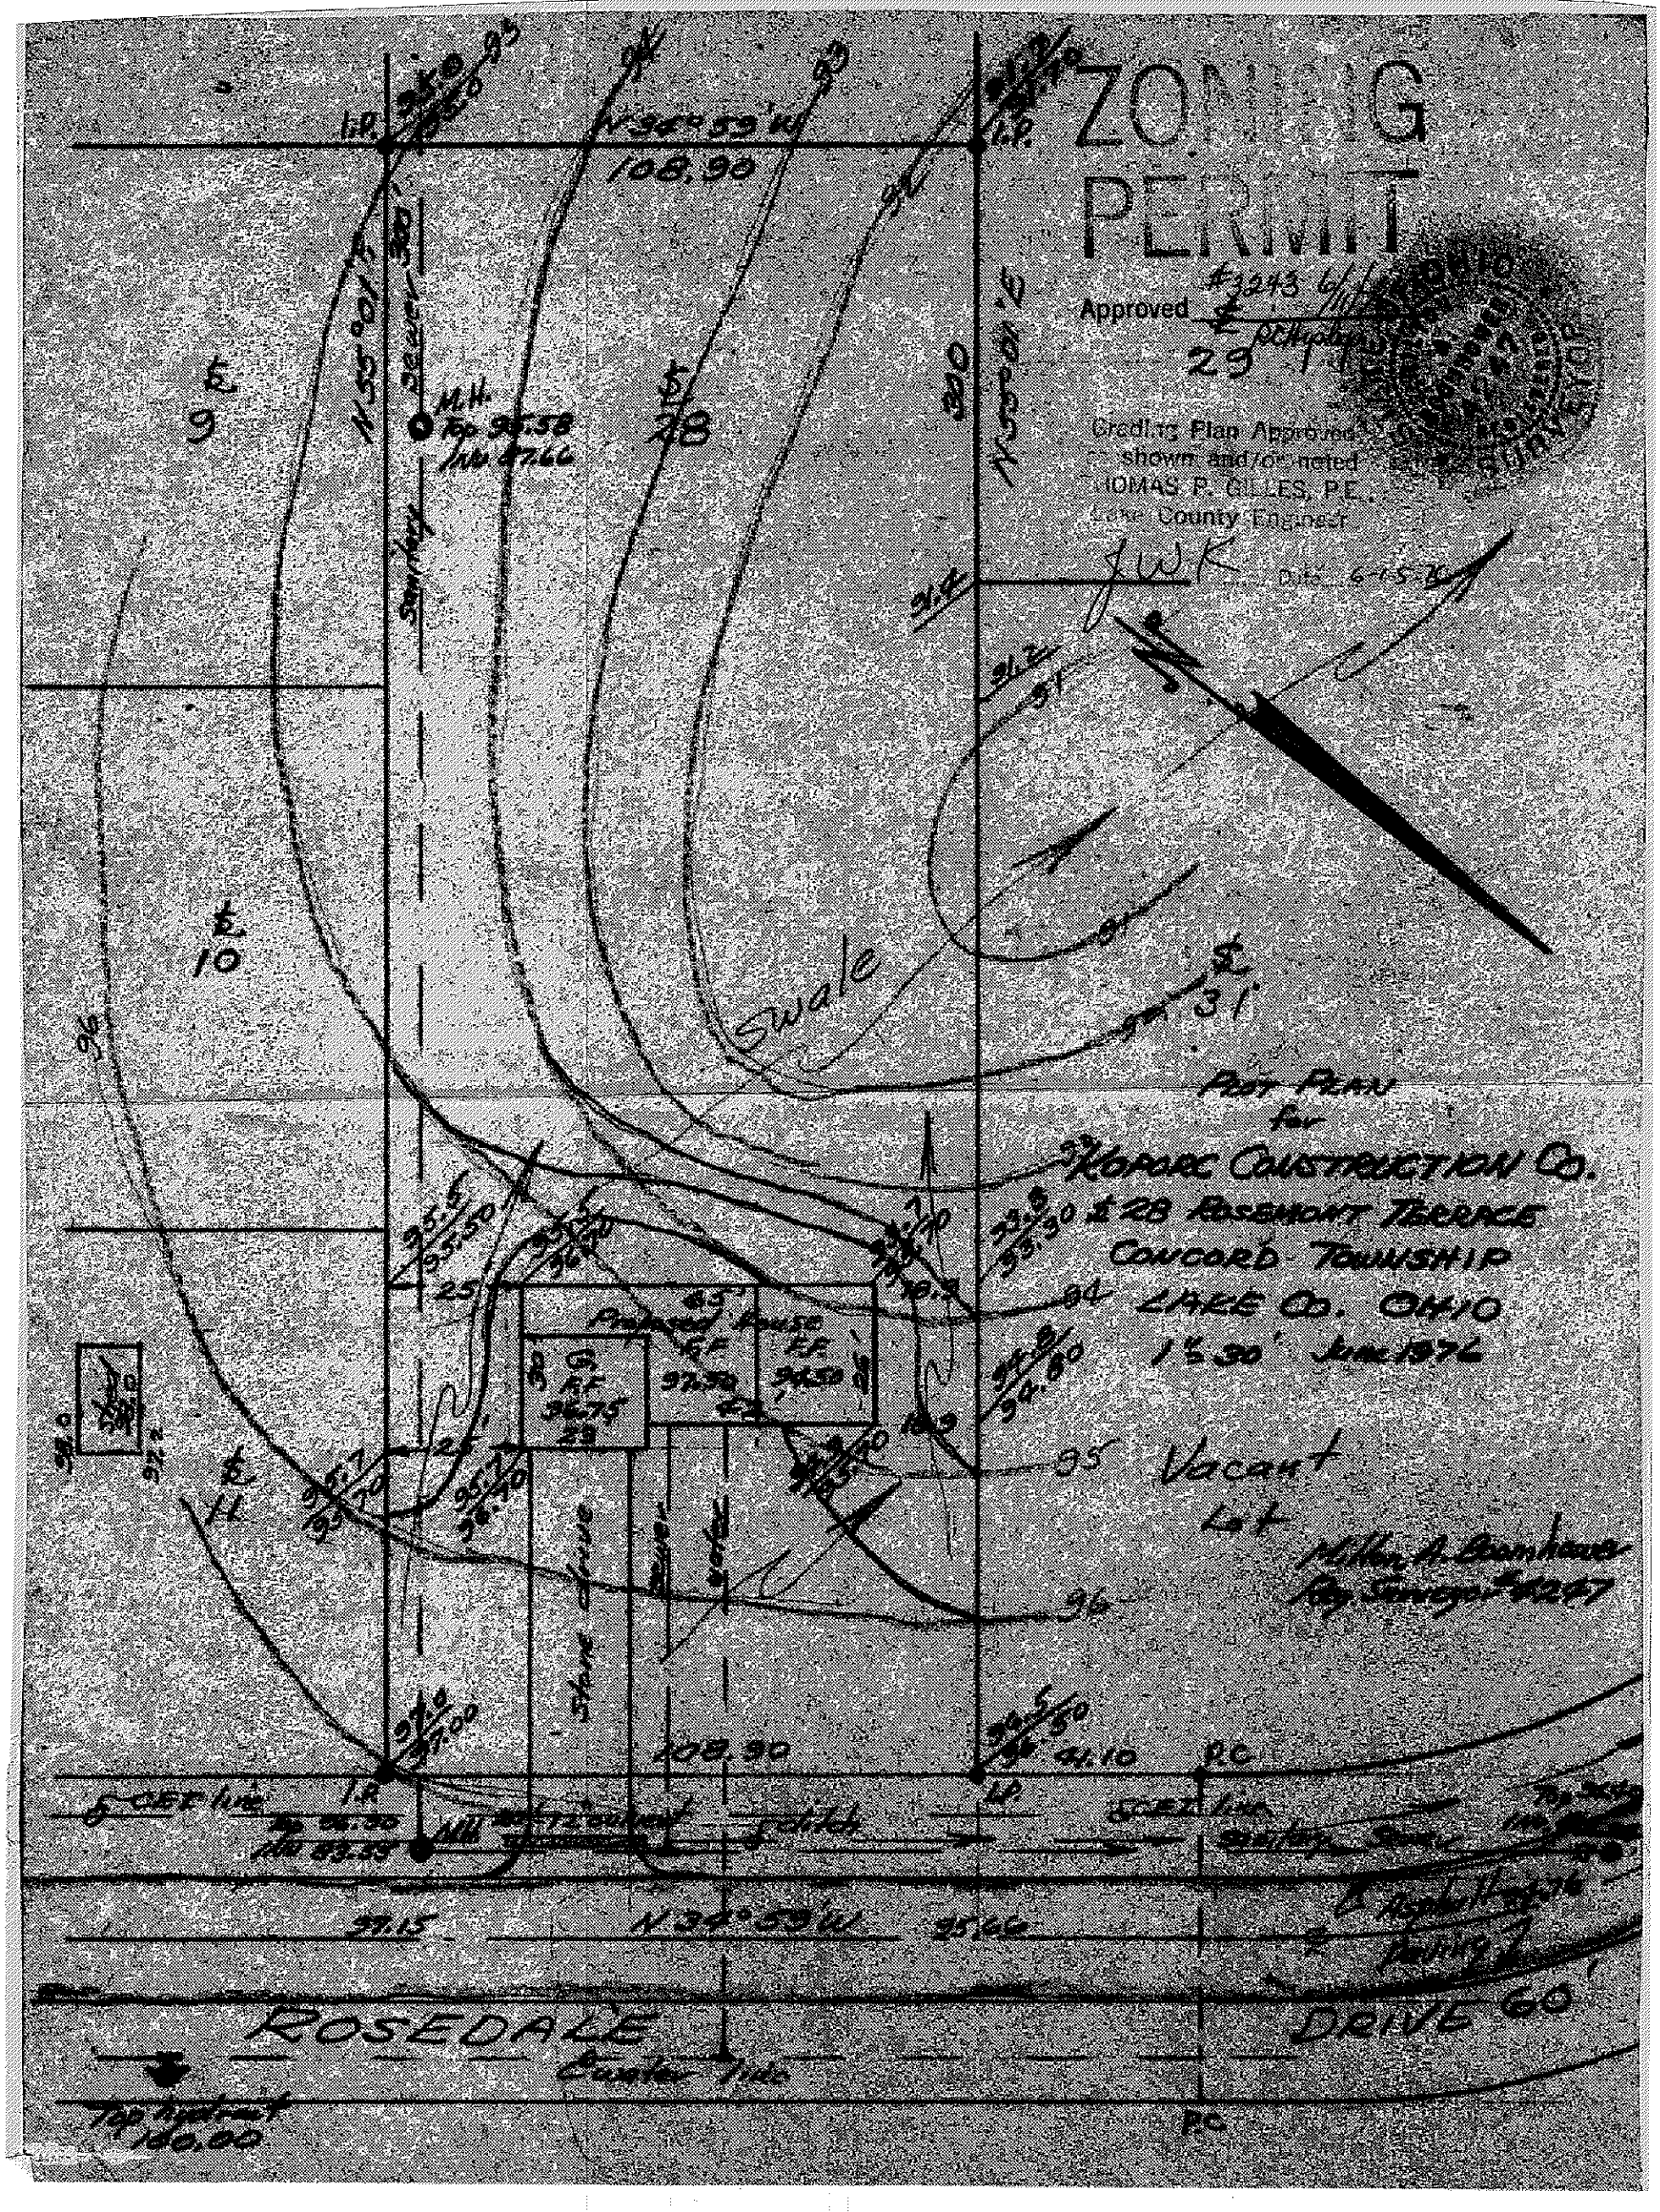
ZONING PERMIT
Approved #3243 6/11/76
29
Grading Plan Approved as shown and/or noted
THOMAS P. GILLES, P.E.
Lake County Engineer
JWK
Date 6-15-76
Plot Plan for
Koporc Construction Co.
#28 Rosemont Terrace
Concord Township
Lake Co. Ohio
1" = 30' June 1976
Vacant Lot
Milton A. Boomhower
Reg. Surveyor #4247
Proposed House
Swale
Stone drive
Sewer
Water
Ditch
Sanitary Sewer
Asphalt Paving
ROSEDALE
DRIVE 60'
Top hydrant 100.00
N 34° 59' W
108.90
97.15
95.66
41.10
P.C.
I.P.
℄ 9
℄ 10
℄ 11
℄ 28
℄ 31
℄ 30
℄ 29
℄ 31