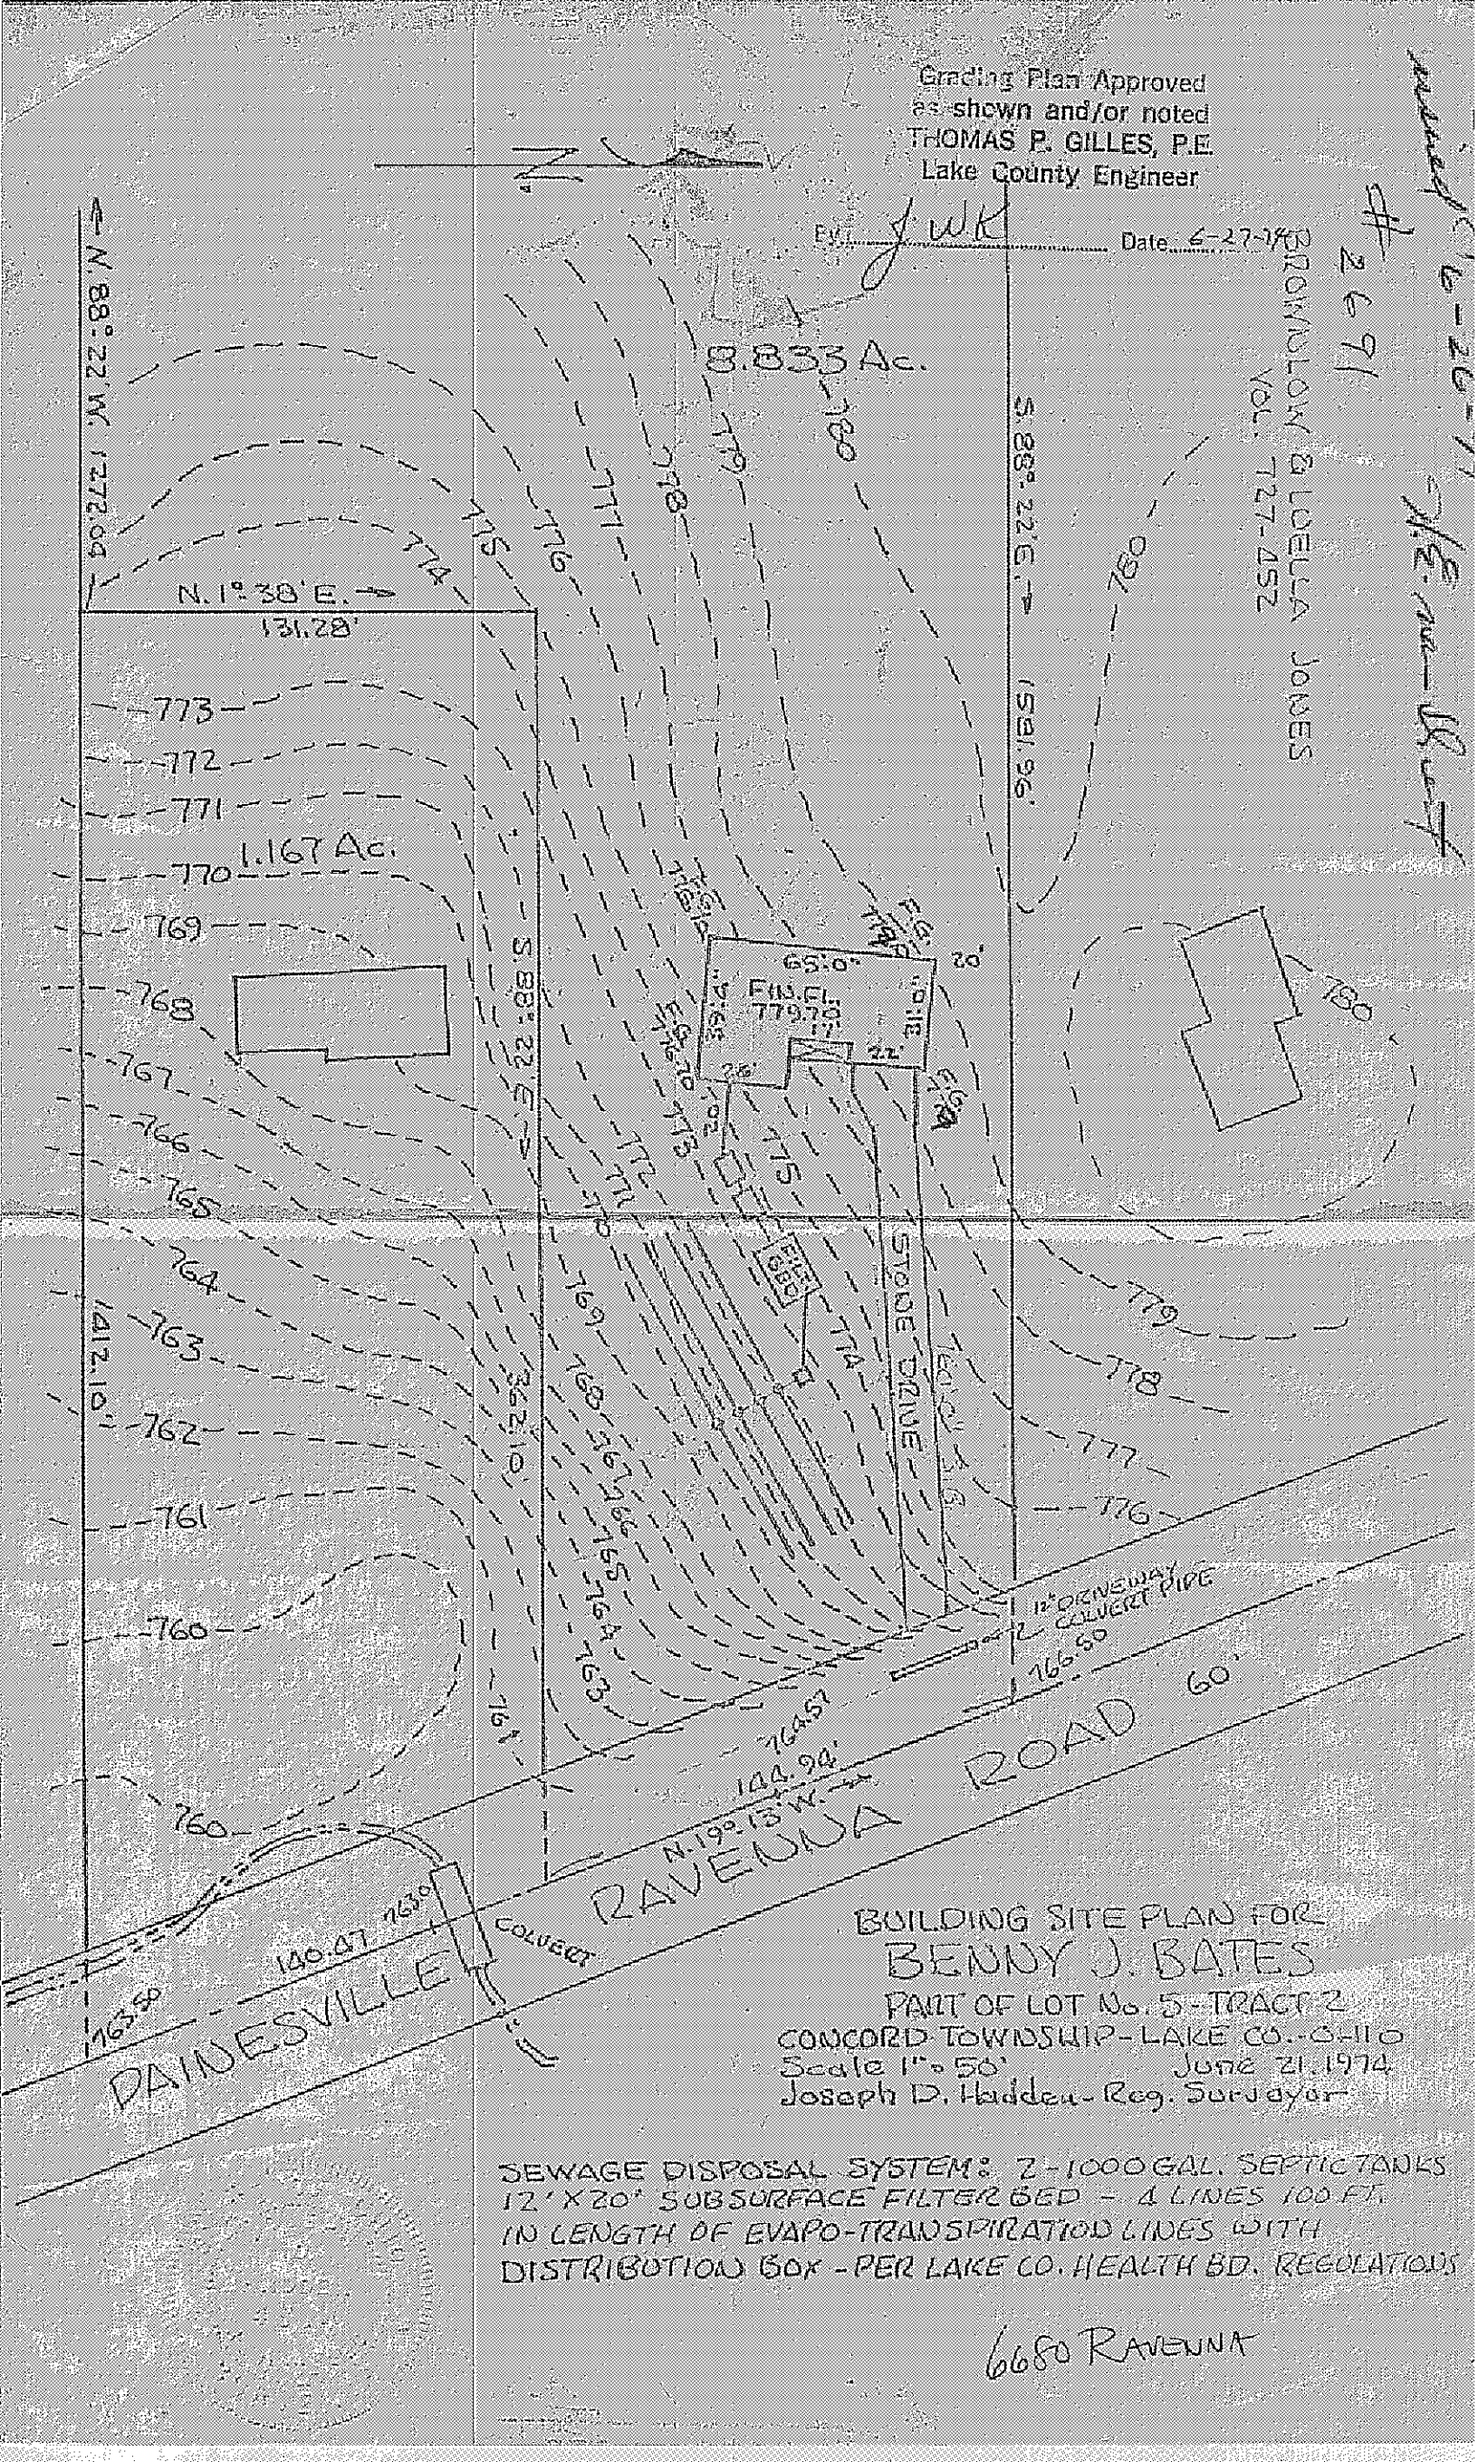
Grading Plan Approved
as shown and/or noted
THOMAS P. GILLES, P.E.
Lake County Engineer
By: JWK
Date 6-27-74
8.835 Ac.
1.167 Ac.
BROWNLOW & LOELLA JONES
VOL. 727-452
S. 88° 22' E. 1381.96'
N. 88° 22' W. 1272.09'
N. 1° 38' E. 131.28'
FIN. F.G. 779.70
STONE DRIVE
12" DRIVEWAY CULVERT PIPE
766.50
60'
RAVENNA ROAD
N. 19° 15' W. 144.24'
COLVERT
140.47
763.0
763.8
DAINESVILLE
BUILDING SITE PLAN FOR
BENNY J. BATES
PART OF LOT No. 5 - TRACT 2
CONCORD TOWNSHIP - LAKE CO. - OHIO
Scale 1" = 50' June 21, 1974
Joseph D. Hadden - Reg. Surveyor
SEWAGE DISPOSAL SYSTEM: 2-1000 GAL. SEPTIC TANKS
12' X 20' SUBSURFACE FILTER BED - 4 LINES 100 FT.
IN LENGTH OF EVAPO-TRANSPIRATION LINES WITH
DISTRIBUTION BOX - PER LAKE CO. HEALTH BD. REGULATIONS
6680 RAVENNA