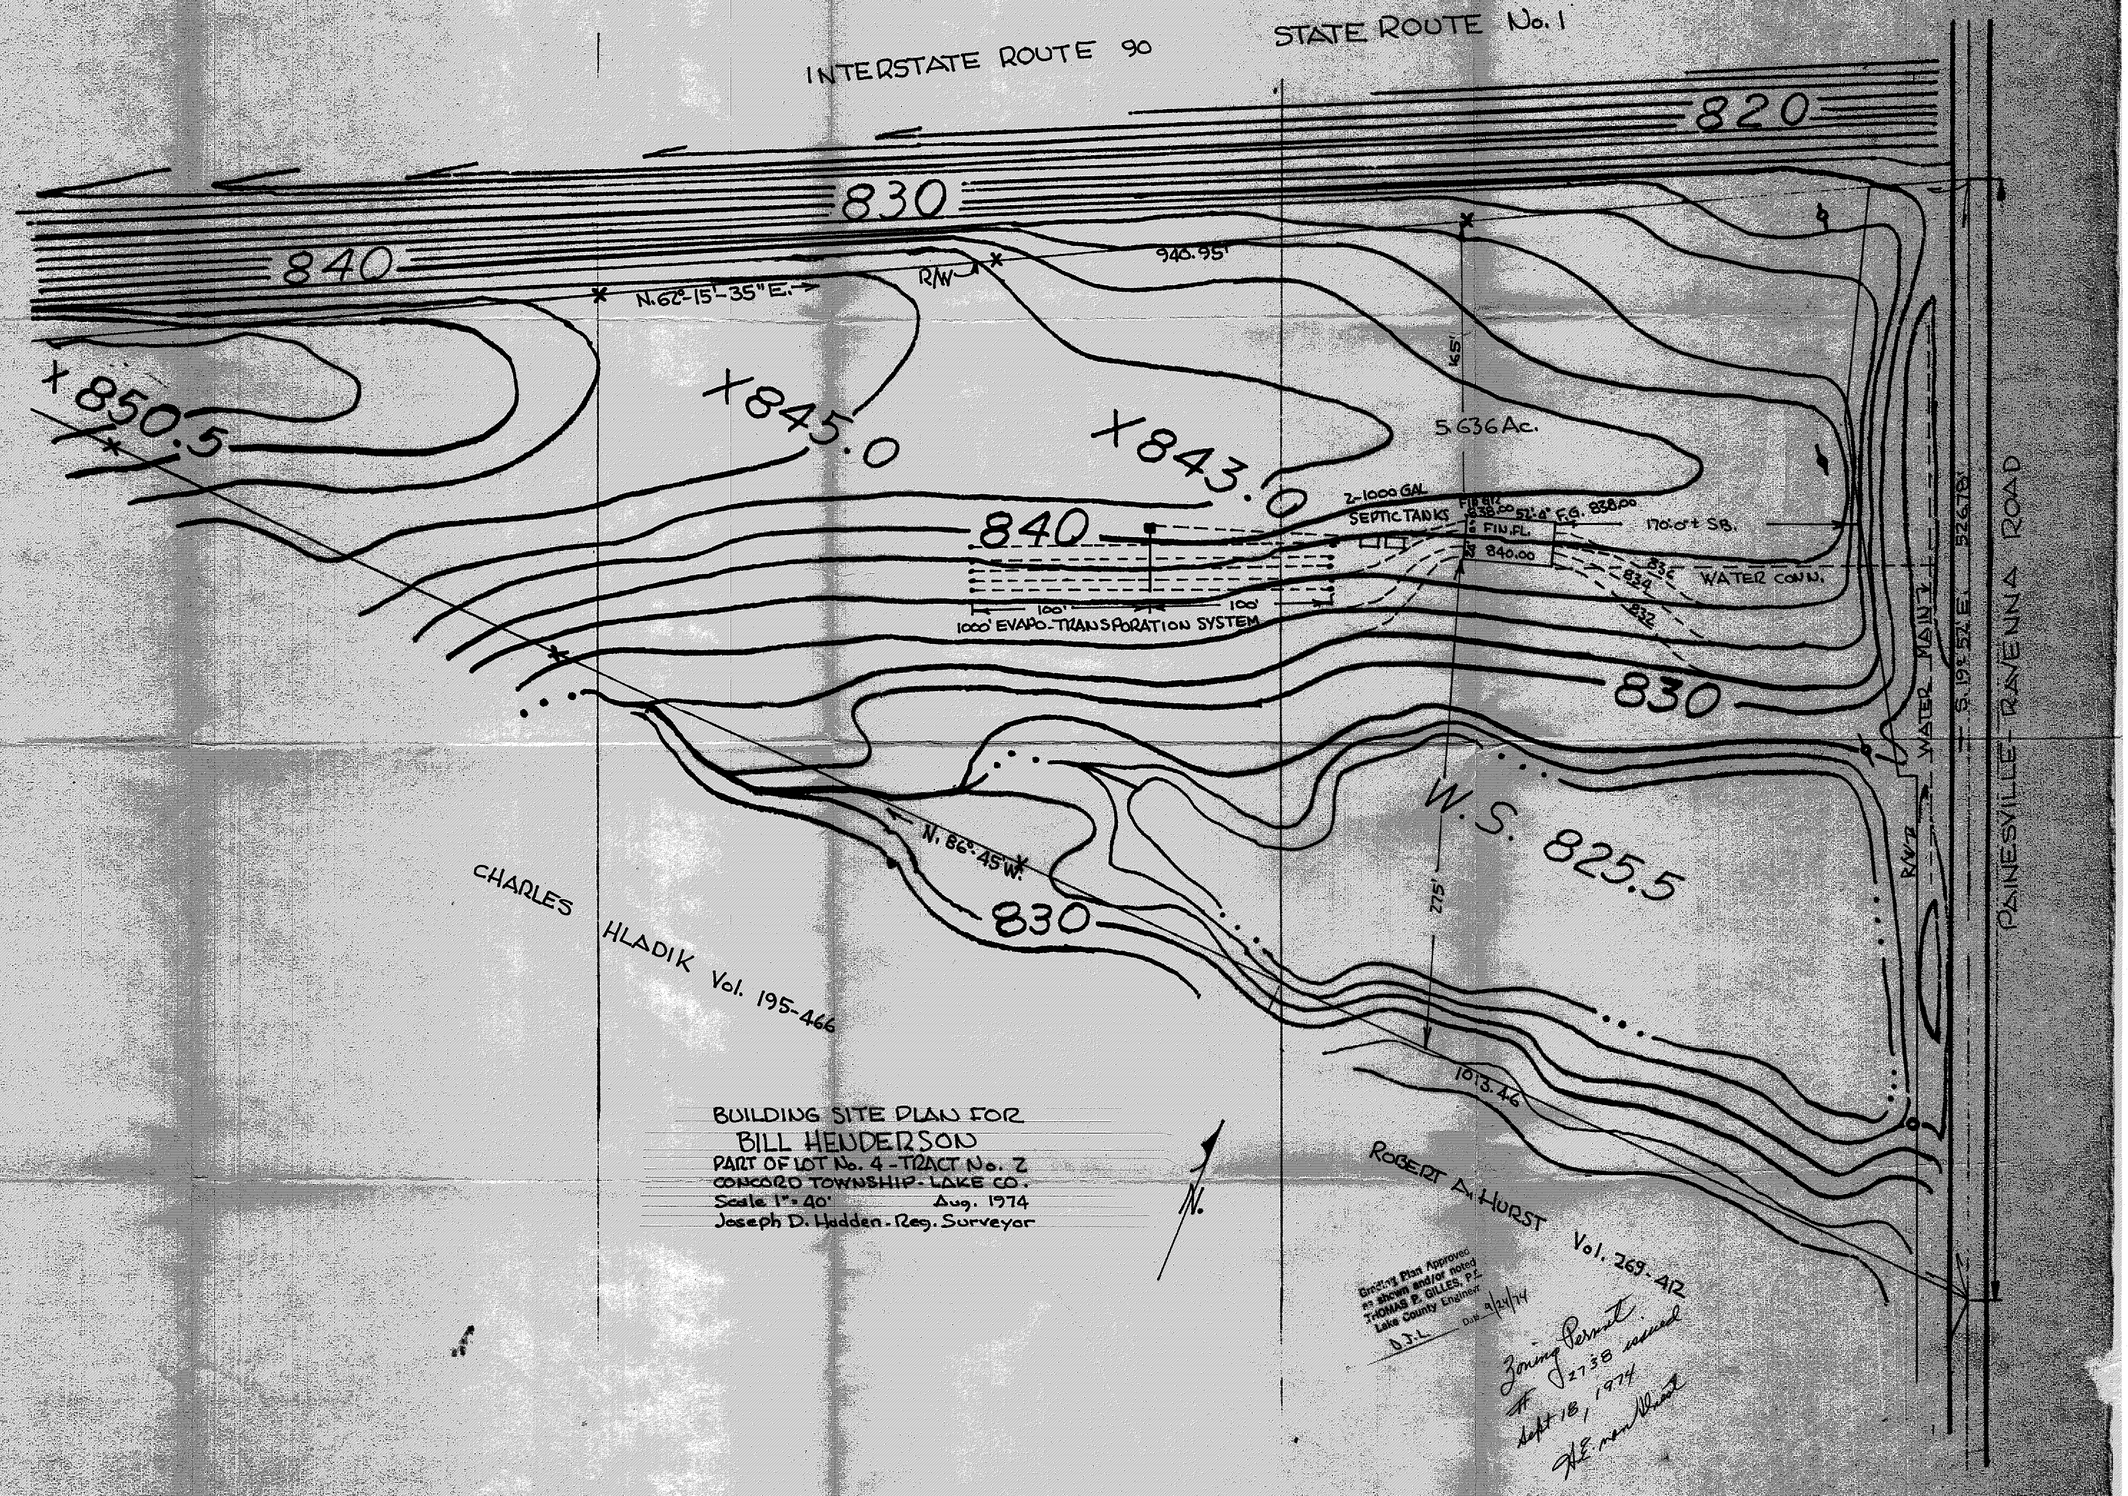
INTERSTATE ROUTE 90
STATE ROUTE No. 1
820
830
840
N. 62°-15'-35" E.
R/W
940.95'
850.5
845.0
843.0
5.636 Ac.
2-1000 GAL
SEPTIC TANKS
FIN. FL.
840.00
170'-0" ± S.B.
WATER CONN.
1000' EVAPO-TRANSPORATION SYSTEM
100'
100'
W.S. 825.5
N. 86°-45' W.
CHARLES HLADIK Vol. 195-466
1013.46
ROBERT A. HURST Vol. 269-412
WATER MAIN
PAINESVILLE-RAVENNA ROAD
N.
BUILDING SITE PLAN FOR
BILL HENDERSON
PART OF LOT No. 4 - TRACT No. 2
CONCORD TOWNSHIP - LAKE CO.
Scale 1" = 40'
Aug. 1974
Joseph D. Hadden - Reg. Surveyor
Grading Plan Approved as shown and/or noted
THOMAS P. GILLES, P.E.
Lake County Engineer
D.J.L.
Date 9/24/74
Zoning Permit
2738 issued
Sept 18, 1974