CONCORD
TOWNSHIP

LAKE COUNTY
OHIO

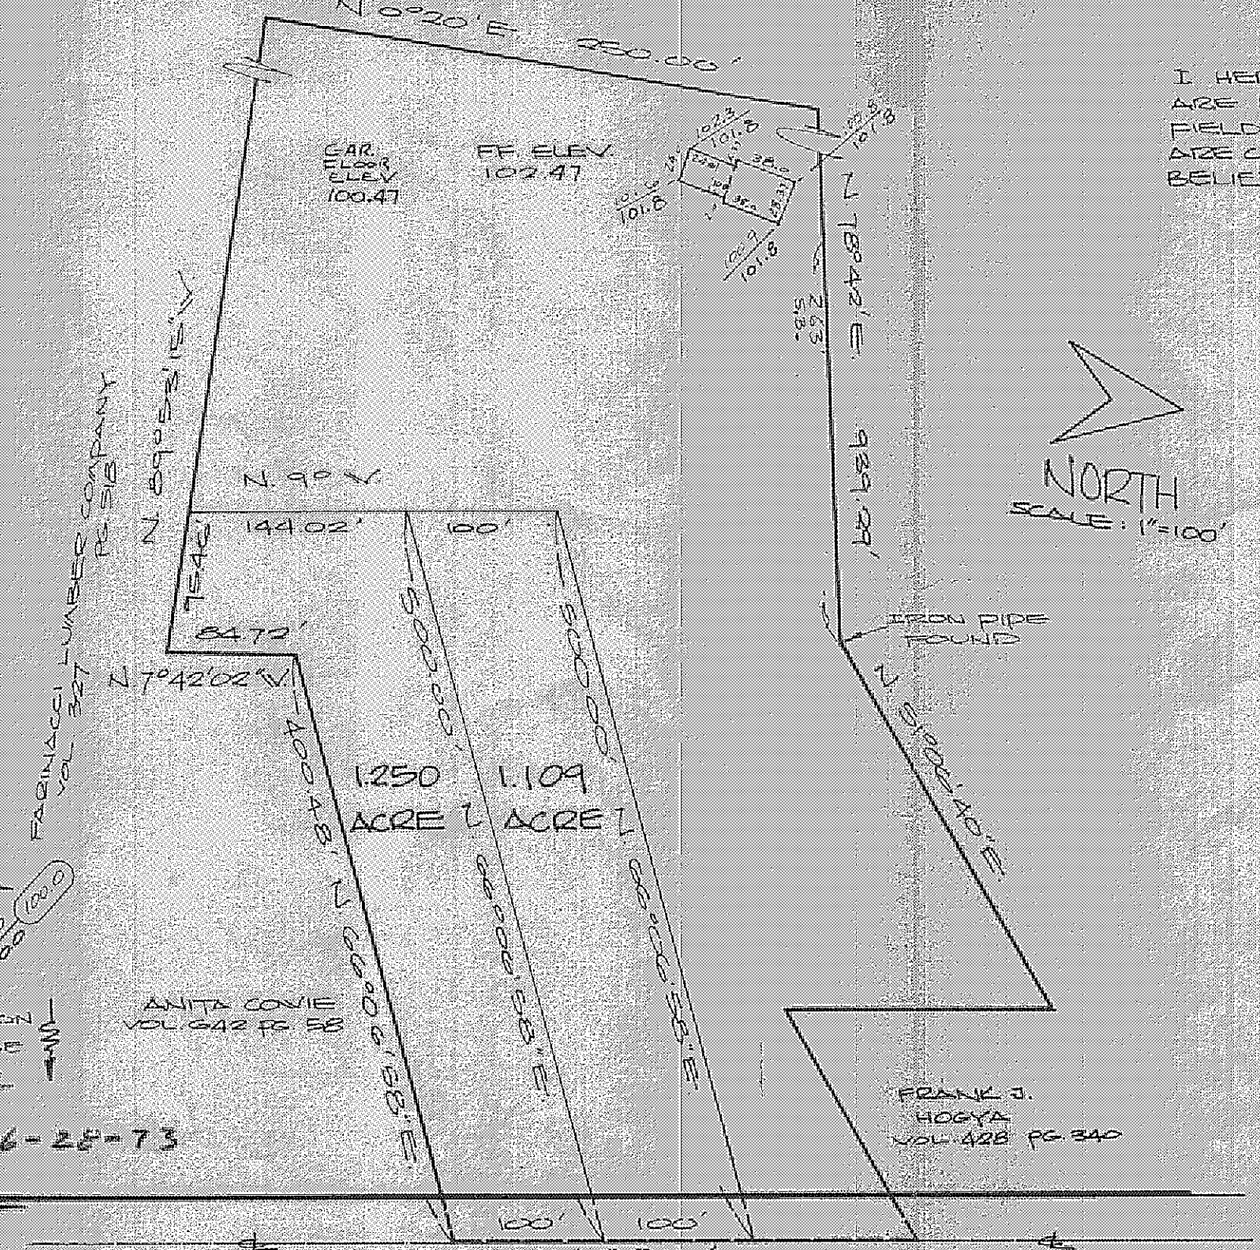

AS BUILT ELEV. 100.0

EXISTING ELEV. 100.0

PROPOSED ELEV. 100.0

INDICATES DIRECTION OF SURFACE DRAINAGE

10" Pipe @ 2.5% slope

SE. 18" C.M.P.

Grading Plan Approved as shown and/or noted
THOMAS P. GILLES, P.E.
Lake County Engineer
By JWK Date July 13

PAINESVILLE-RAVENNA ROAD 60'

"DESIGN" CERTIFICATION
I HEREBY CERTIFY THAT THIS PLAT WAS PREPARED BY ME AND IS CORRECT TO THE BEST OF MY KNOWLEDGE AND BELIEF.

"AS BUILT" CERTIFICATION
I HEREBY CERTIFY THAT THE CIRCLED GRADES ARE EXISTING FINISH GRADES CHECKED IN THE FIELD ON _____ 1973 BY SURVEYING AND ARE CORRECT TO THE BEST OF MY KNOWLEDGE AND BELIEF.

RICHARD J. BILSKI PS Nº 5244

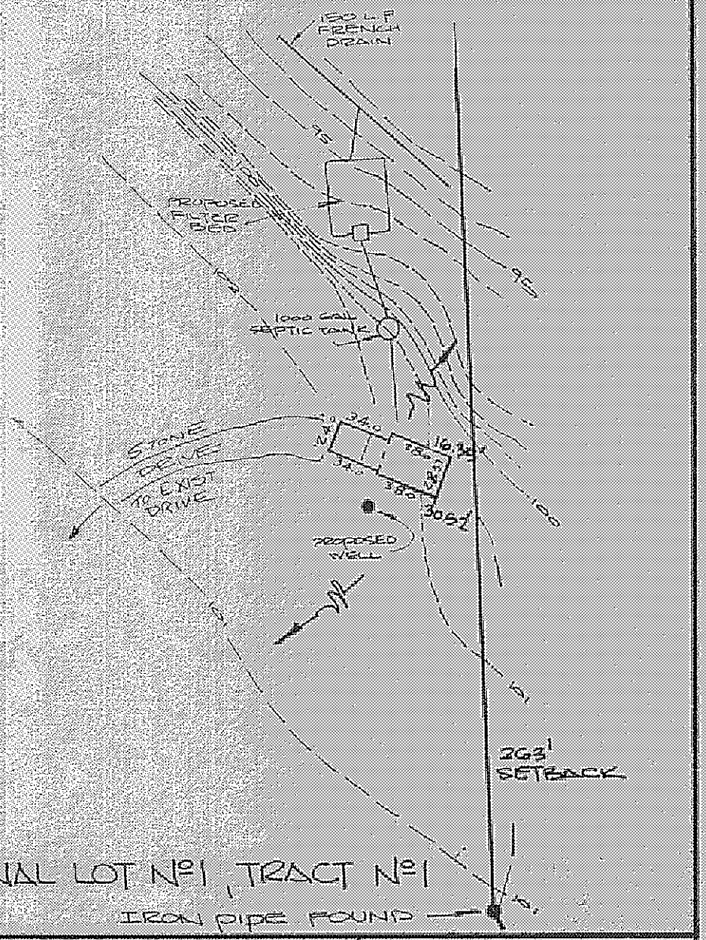

DEBEVEC · SALO & ASSOC., INC.
CIVIL ENGINEERS SURVEYORS
130 E. JACKSON STREET · PAINESVILLE, OHIO

SCALE: 1"=100'	APPROVED BY:	DRAWN BY A.S.
DATE: 6/13/73		REVISED

SITE PLAN FOR JOSEPH SEVERINO

Richard J. Bilski
RICHARD J. BILSKI P.S. Nº 5244

DRAWING NUMBER 3928

11X17 PRINTED ON NO. 1000H CLEARPRINT