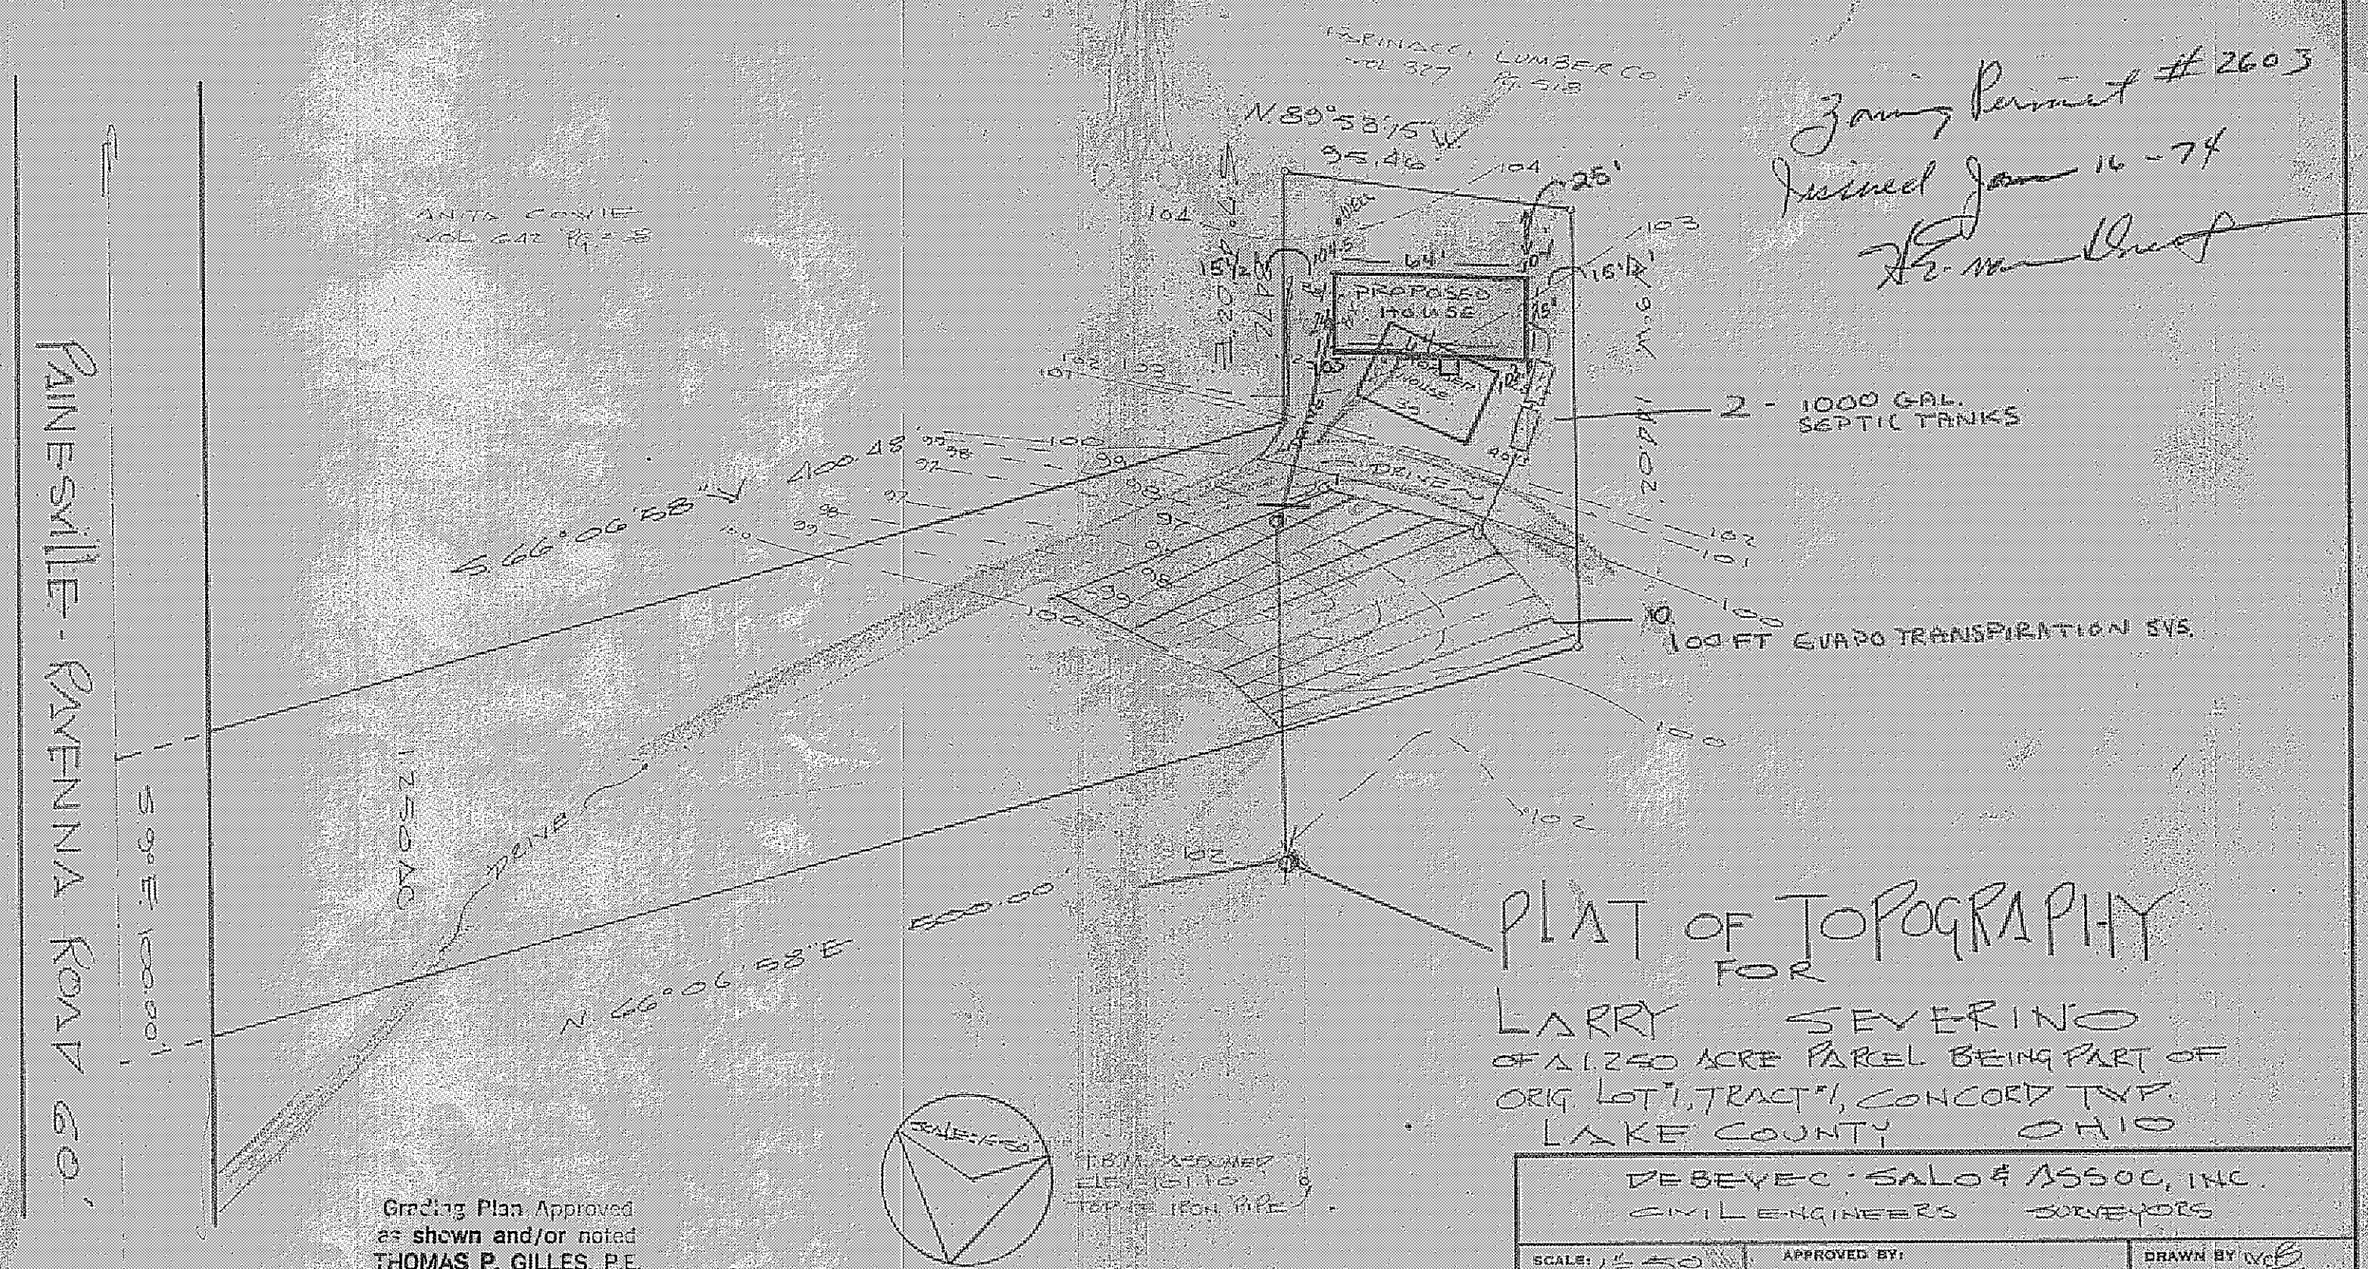

Zoning Permit #2603
Issued Jan 16-74
[signature]

PLAT OF TOPOGRAPHY FOR LARRY SEVERINO

OF A 1.250 ACRE PARCEL BEING PART OF ORIG. LOT #1, TRACT #1, CONCORD TWP. LAKE COUNTY OHIO

Grading Plan Approved as shown and/or noted
THOMAS P. GILLES, P.E.
Lake County Engineer
By JWK Date 5-8-74 revised

DEBEVEC, SALO & ASSOC, INC. CIVIL ENGINEERS SURVEYORS		
SCALE: 1" = 50'	APPROVED BY:	DRAWN BY WCB
DATE: 24 Oct 73		REVISED
130 EAST JACKSON ST. PAINESVILLE, OHIO		
		DRAWING NUMBER 3928

PRINTED ON NO. 1000H CLEARPRINT

8/70