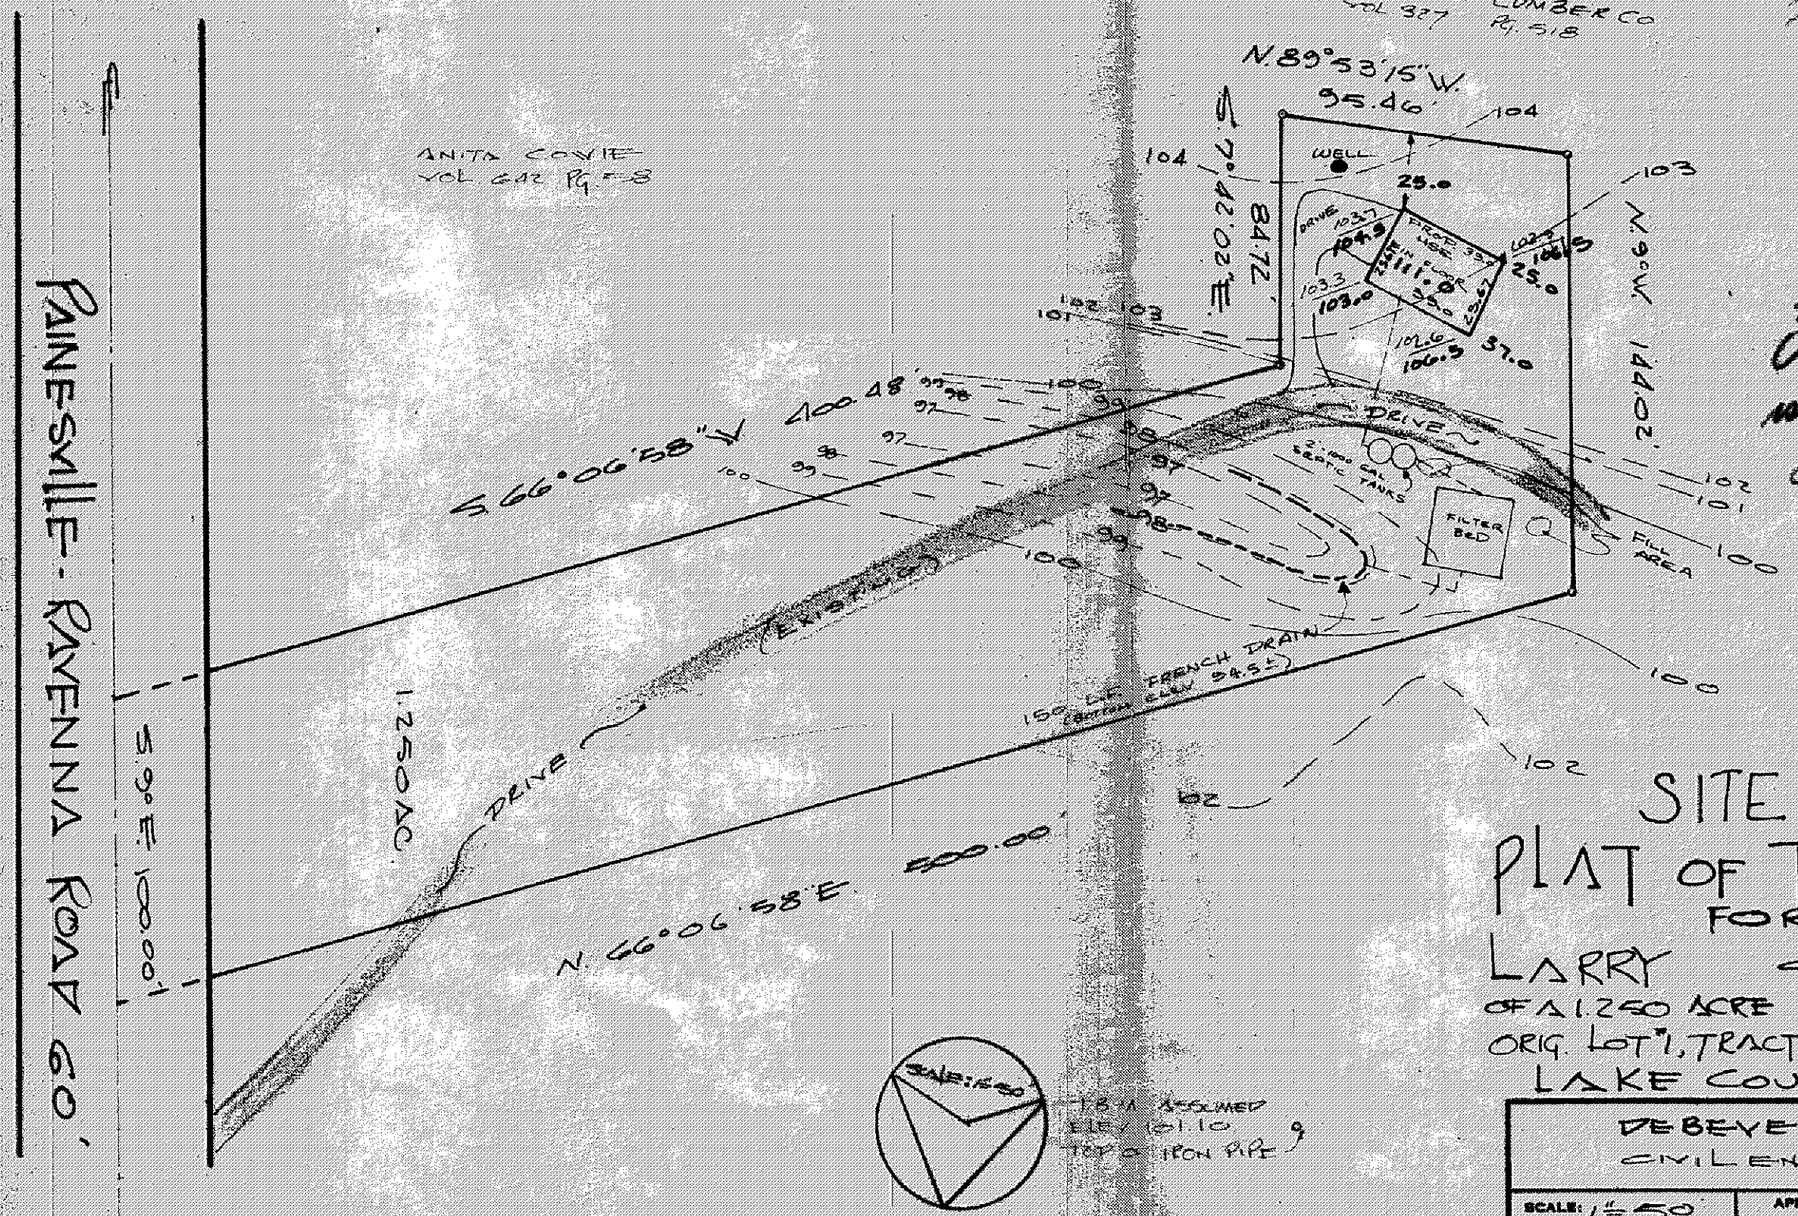

Zoning Permit #2603
issued 1-16-74
[signature]

Grading Plan Approved
as shown and/or noted
THOMAS B. GILLES, P.E.
Lake County Engineer
By JWK Date 2-5-74

SITE PLAN & PLAT OF TOPOGRAPHY FOR LARRY SEVERINO

OF A 1.250 ACRE PARCEL BEING PART OF ORIG. LOT #1, TRACT #1, CONCORD TWP. LAKE COUNTY OHIO

DEBEVEC · SALO & ASSOC, INC.
CIVIL ENGINEERS SURVEYORS

SCALE: 1"=50'	APPROVED BY:	DRAWN BY WCB
DATE: 24 OCT 73		REVISED 11/13/73

130 EAST JACKSON ST.
PAINESVILLE, OHIO

DRAWING NUMBER 3928

THE TOPOGRAPHICAL DATA SHOWN CORRECT TO THE BEST OF MY KNOWLEDGE & BELIEF Richard H. Bilski
PS# 5244

PRINTED ON NO. 1000H CLEARPRINT