LAKE BLUE INC. 2359000
8551 Fairview Blvd. Mentor, Ohio 44060

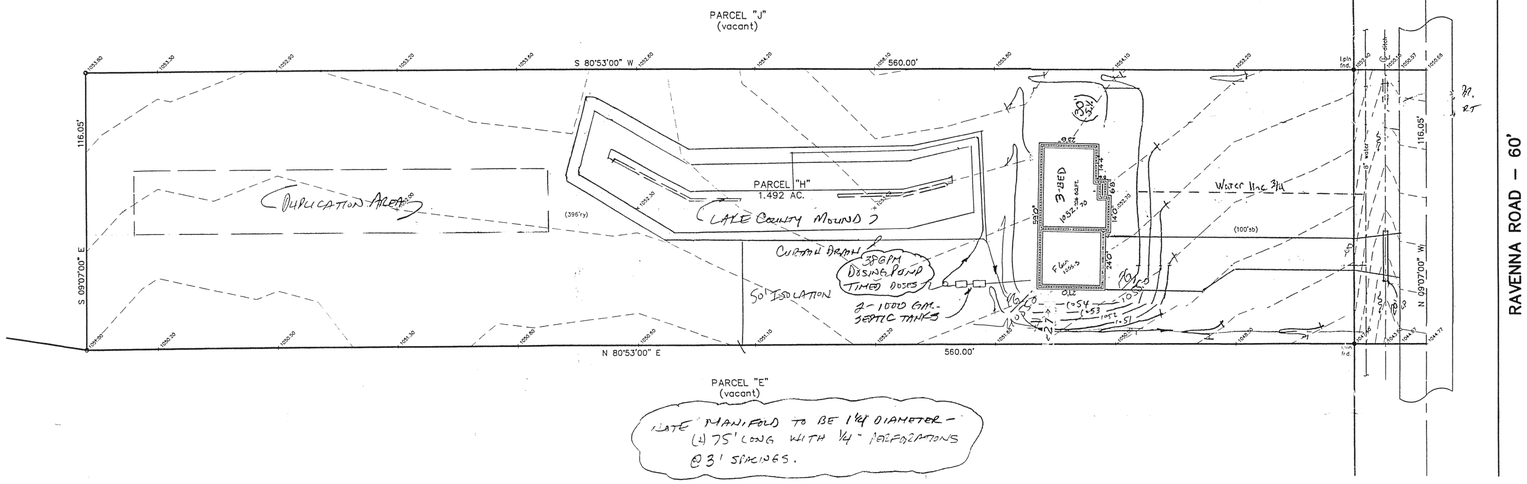

LATE MANIFOLD TO BE 1½" DIAMETER – (4) 75' LONG WITH ¼" PERFORATIONS @ 3' SPACINGS.

REVIEWED AND ACCEPTED
LAKE COUNTY GENERAL
HEALTH DISTRICT
Date 7/17/02 BY: Daniel

SEWAGE DISPOSAL PERMIT MUST BE OBTAINED BY A LAKE COUNTY LICENSED INSTALLER BEFORE INSTALLATION IS STARTED.

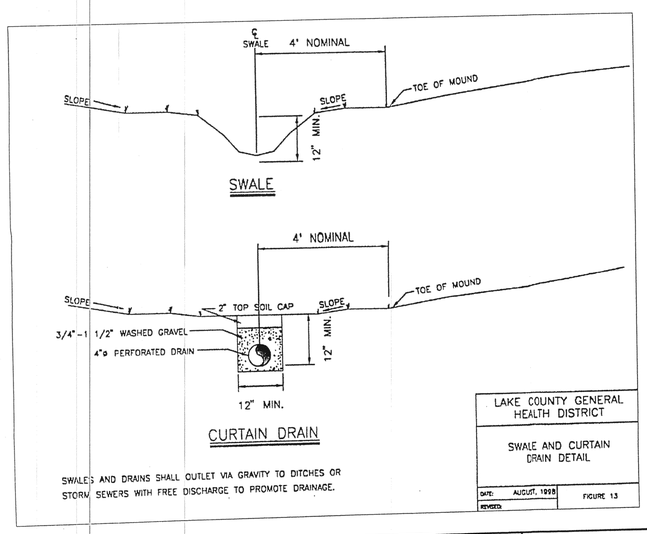

CONCORD TOWNSHIP ZONING OFFICE
ZONING PERMIT # 0702-10657
ISSUED 7/8/02
SUBJECT TO APPROVAL BY:
☒ Lake Co. Sanitary Engineer
☐ Lake Co. Engineer
☐ Lake Co. Planning Comm.
☐ Lake Co. Planning Dept.
☒ Lake Co. Soil & Water Cons. Dist.

Grading Plan Approved
as shown and/or noted
JAMES R. GILLS, P.E.
Lake County Engineer
By GJH Date 7-29-02
Min 15" Drive Culvert

"I, the undersigned hereby certify that this topography indicated by 6", 1', or 2' contours, and elevations shown hereon represent an actual field survey made by me on the 5th day of June, 19 99 and that the elevations were taken at appropriate intervals and that as of that date they existed as indicated hereon."

Name Harry S. Jones Jr. #6343 Reg. No.

TBM–TOP OF HYDRANT PARCEL "I"
ELEV.=1062.46

STATE OF OHIO
HARRY S. JONES JR.
S-6343
REGISTERED
PROFESSIONAL SURVEYOR

REV NO.	DESCRIPTION	DATE	BY	CHK'D
1	REVISIONS PER LAKE County Health Dept	12/9/99	HT	HJ
2	" " " " "	1/5/00	HT	HJ

BABCOCK, JONES AND ASSOCIATES, INC
CIVIL ENGINEERS – SURVEYORS – LAND PLANNERS
PAINESVILLE OHIO 44077

DATE	6/7/99
DESIGN BY	H.J.
DRAWN BY	T.R.
APPROVED BY	H.J.

SITE PLAN
FOR
BOHENSTENGEL
PARCEL "H" RAVENNA ROAD
CONCORD TOWNSHIP LAKE COUNTY

SCALE: 1"=30'
JOB NO 98-180H
SHEET 1 OF 2