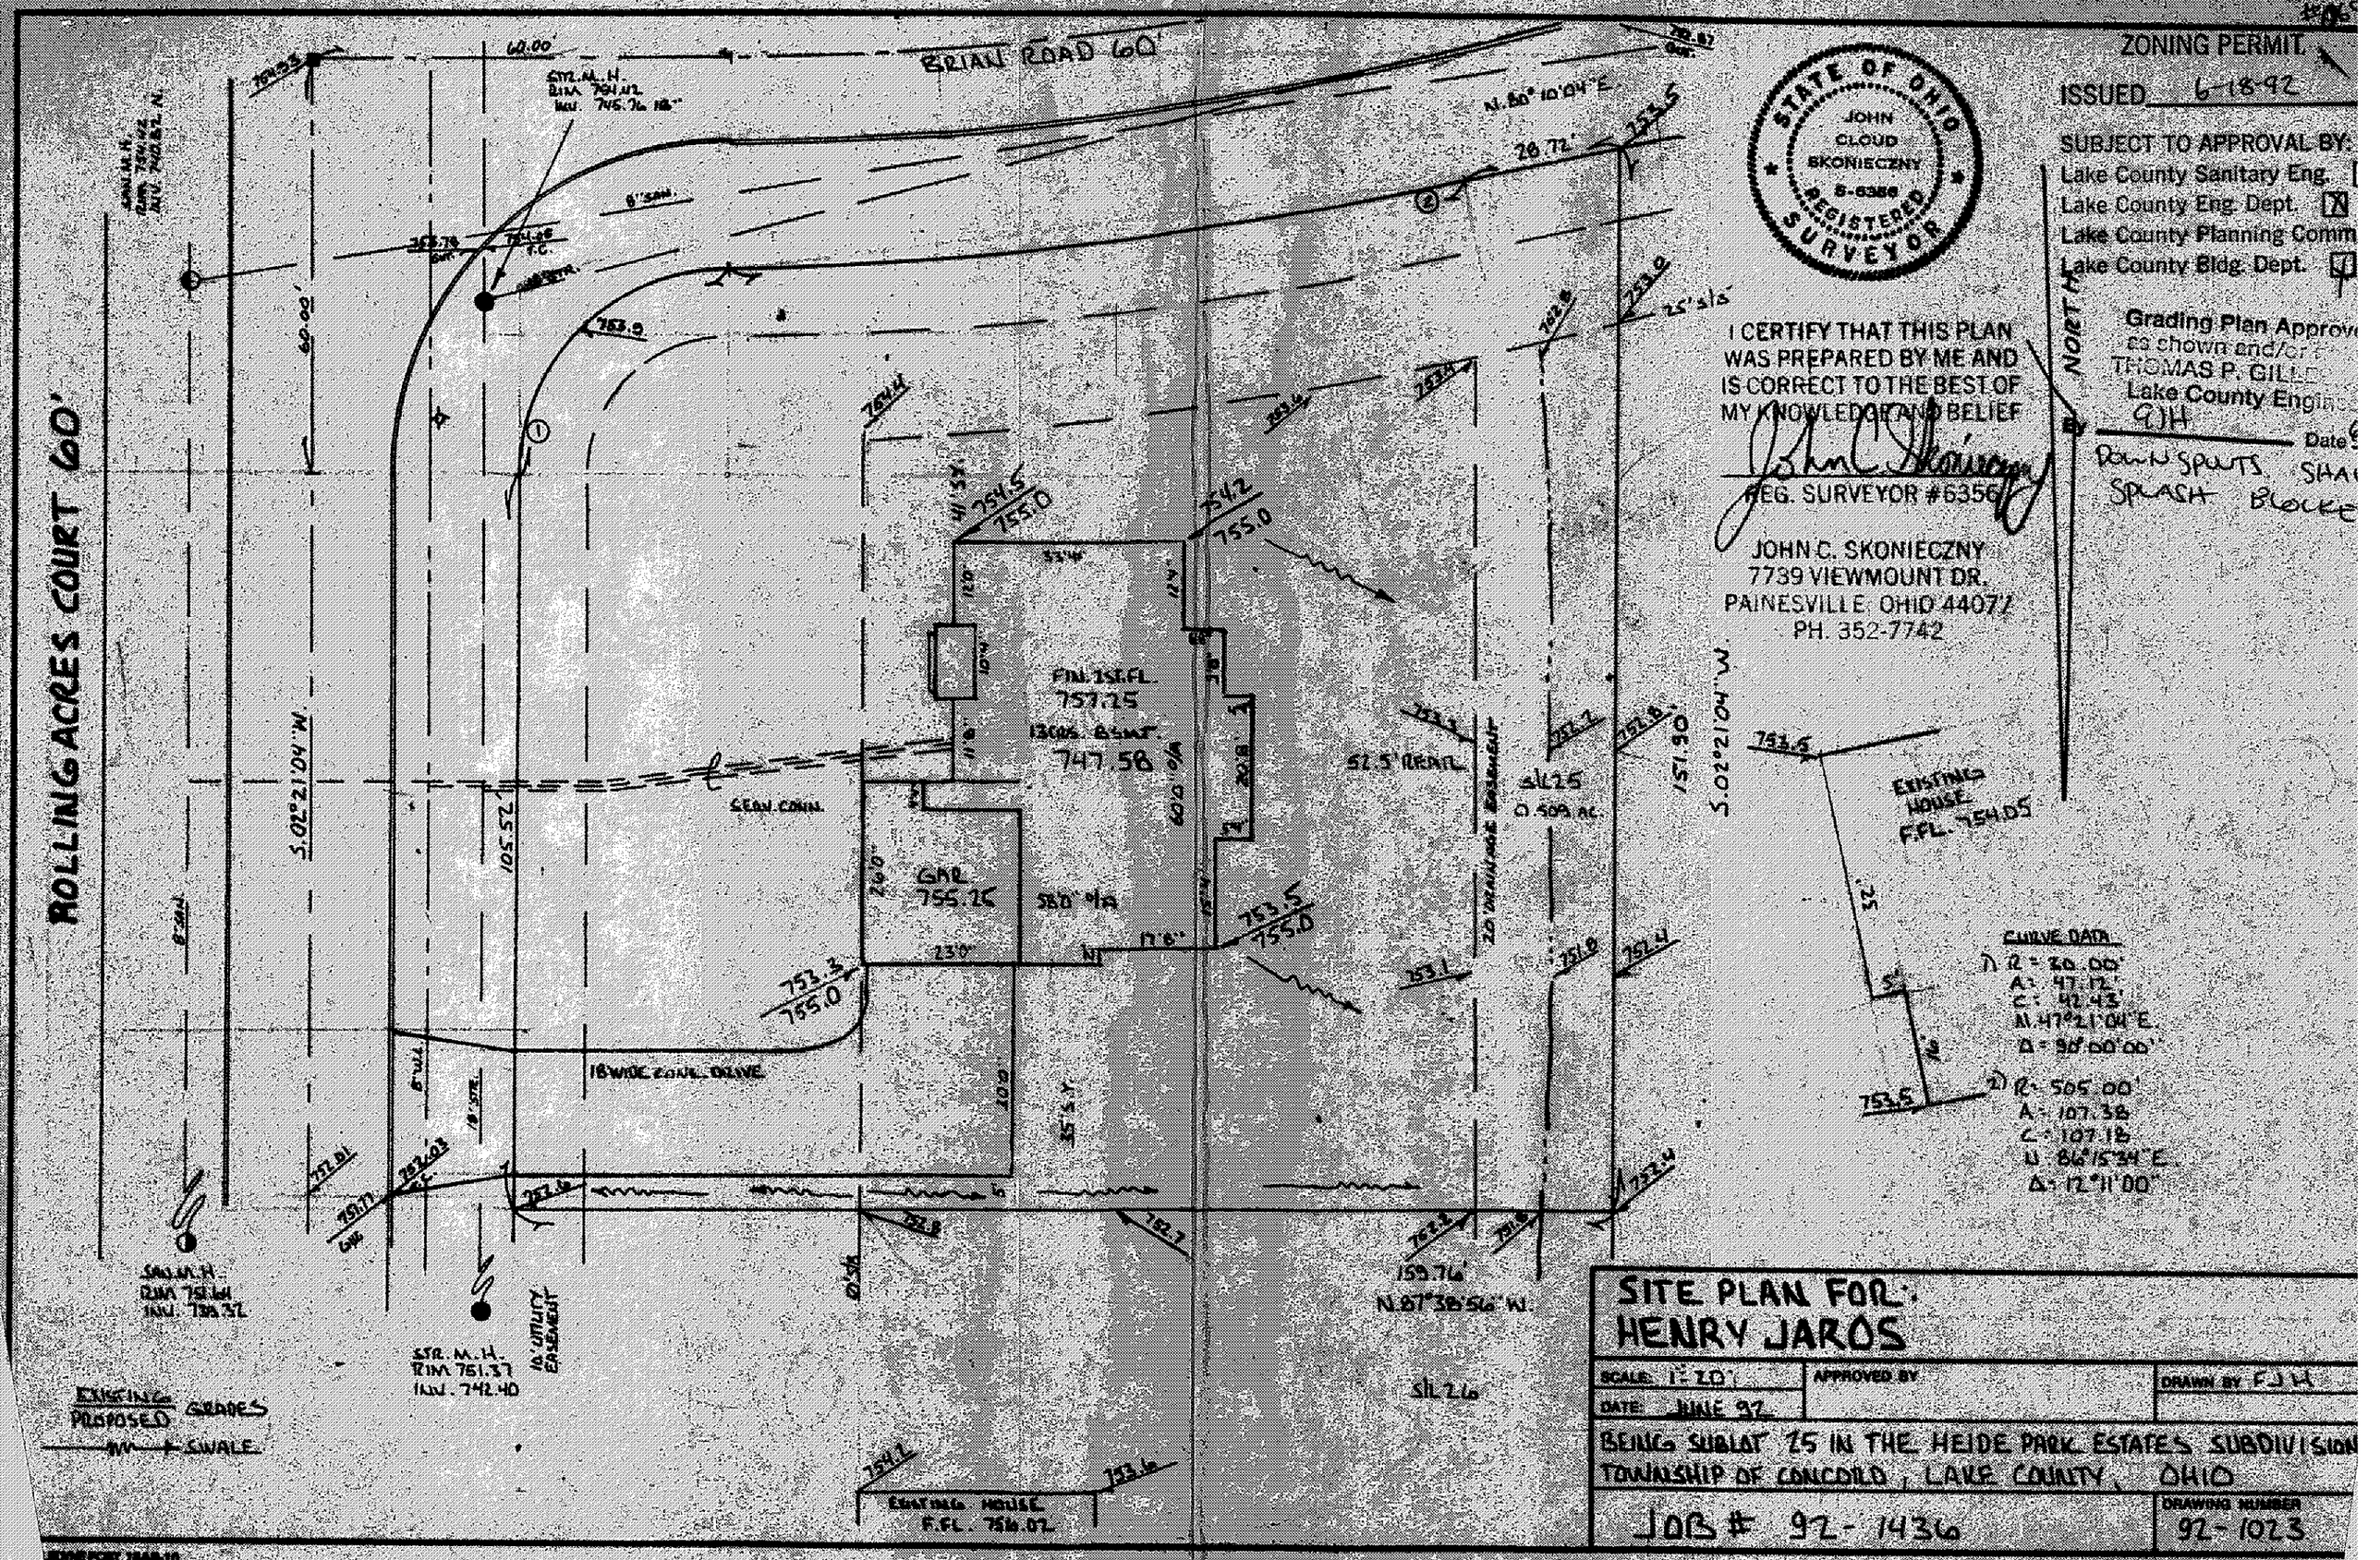

STATE OF OHIO
JOHN CLOUD SKONIECZNY
S-6356
REGISTERED SURVEYOR

I CERTIFY THAT THIS PLAN WAS PREPARED BY ME AND IS CORRECT TO THE BEST OF MY KNOWLEDGE AND BELIEF

REG. SURVEYOR #6356

JOHN C. SKONIECZNY
7739 VIEWMOUNT DR.
PAINESVILLE, OHIO 44077
PH. 352-7742

ZONING PERMIT

ISSUED 6-18-92

SUBJECT TO APPROVAL BY:
Lake County Sanitary Eng.
Lake County Eng. Dept. [X]
Lake County Planning Comm
Lake County Bldg. Dept.

Grading Plan Approv
as shown and/or
THOMAS P. GILL
Lake County Engin
By GJH Date
DOWN SPOUTS SHA
SPLASH BLOCKE

SITE PLAN FOR: HENRY JAROS

SCALE: 1"=20'	APPROVED BY	DRAWN BY FJH
DATE: JUNE 92		

BEING SUBLOT 25 IN THE HEIDE PARK ESTATES SUBDIVISION
TOWNSHIP OF CONCORD, LAKE COUNTY, OHIO

JOB # 92-1436

DRAWING NUMBER 92-1023