SITE PLAN

CONCORD TOWNSHIP

LAKE COUNTY, OHIO

FOR THE

M.M. BOGART DEVELOPMENT CORP.

ZONING PERMIT #6659

ISSUED 11-14-90

SUBJECT TO APPROVAL BY:
- Lake County Sanitary Eng. ☐
- Lake County Eng. Dept. ☒
- Lake County Planning Comm. ☐
- Lake County Bldg. Dept. ☒

Grading Plan Approved
as shown and/or noted
THOMAS P. GILLES, P.E.
Lake County Engineer
By GJH Date 11/16/90

1. CONNECT SUMP PUMP TO STORM SEWER

Peter S. Marano

STATE OF OHIO
DAVID K. MOSTOLLER
6949
REGISTERED SURVEYOR

"I, the undersigned hereby certify that this topography, indicated by 6", 1' or 2' contours, and elevations shown hereon represent an actual field survey made by me on the 30 day of Nov., 1987 and that the elevations were taken at appropriate intervals and that as of that date they existed as indicated hereon."

David K. Mostoller R.S. #6949

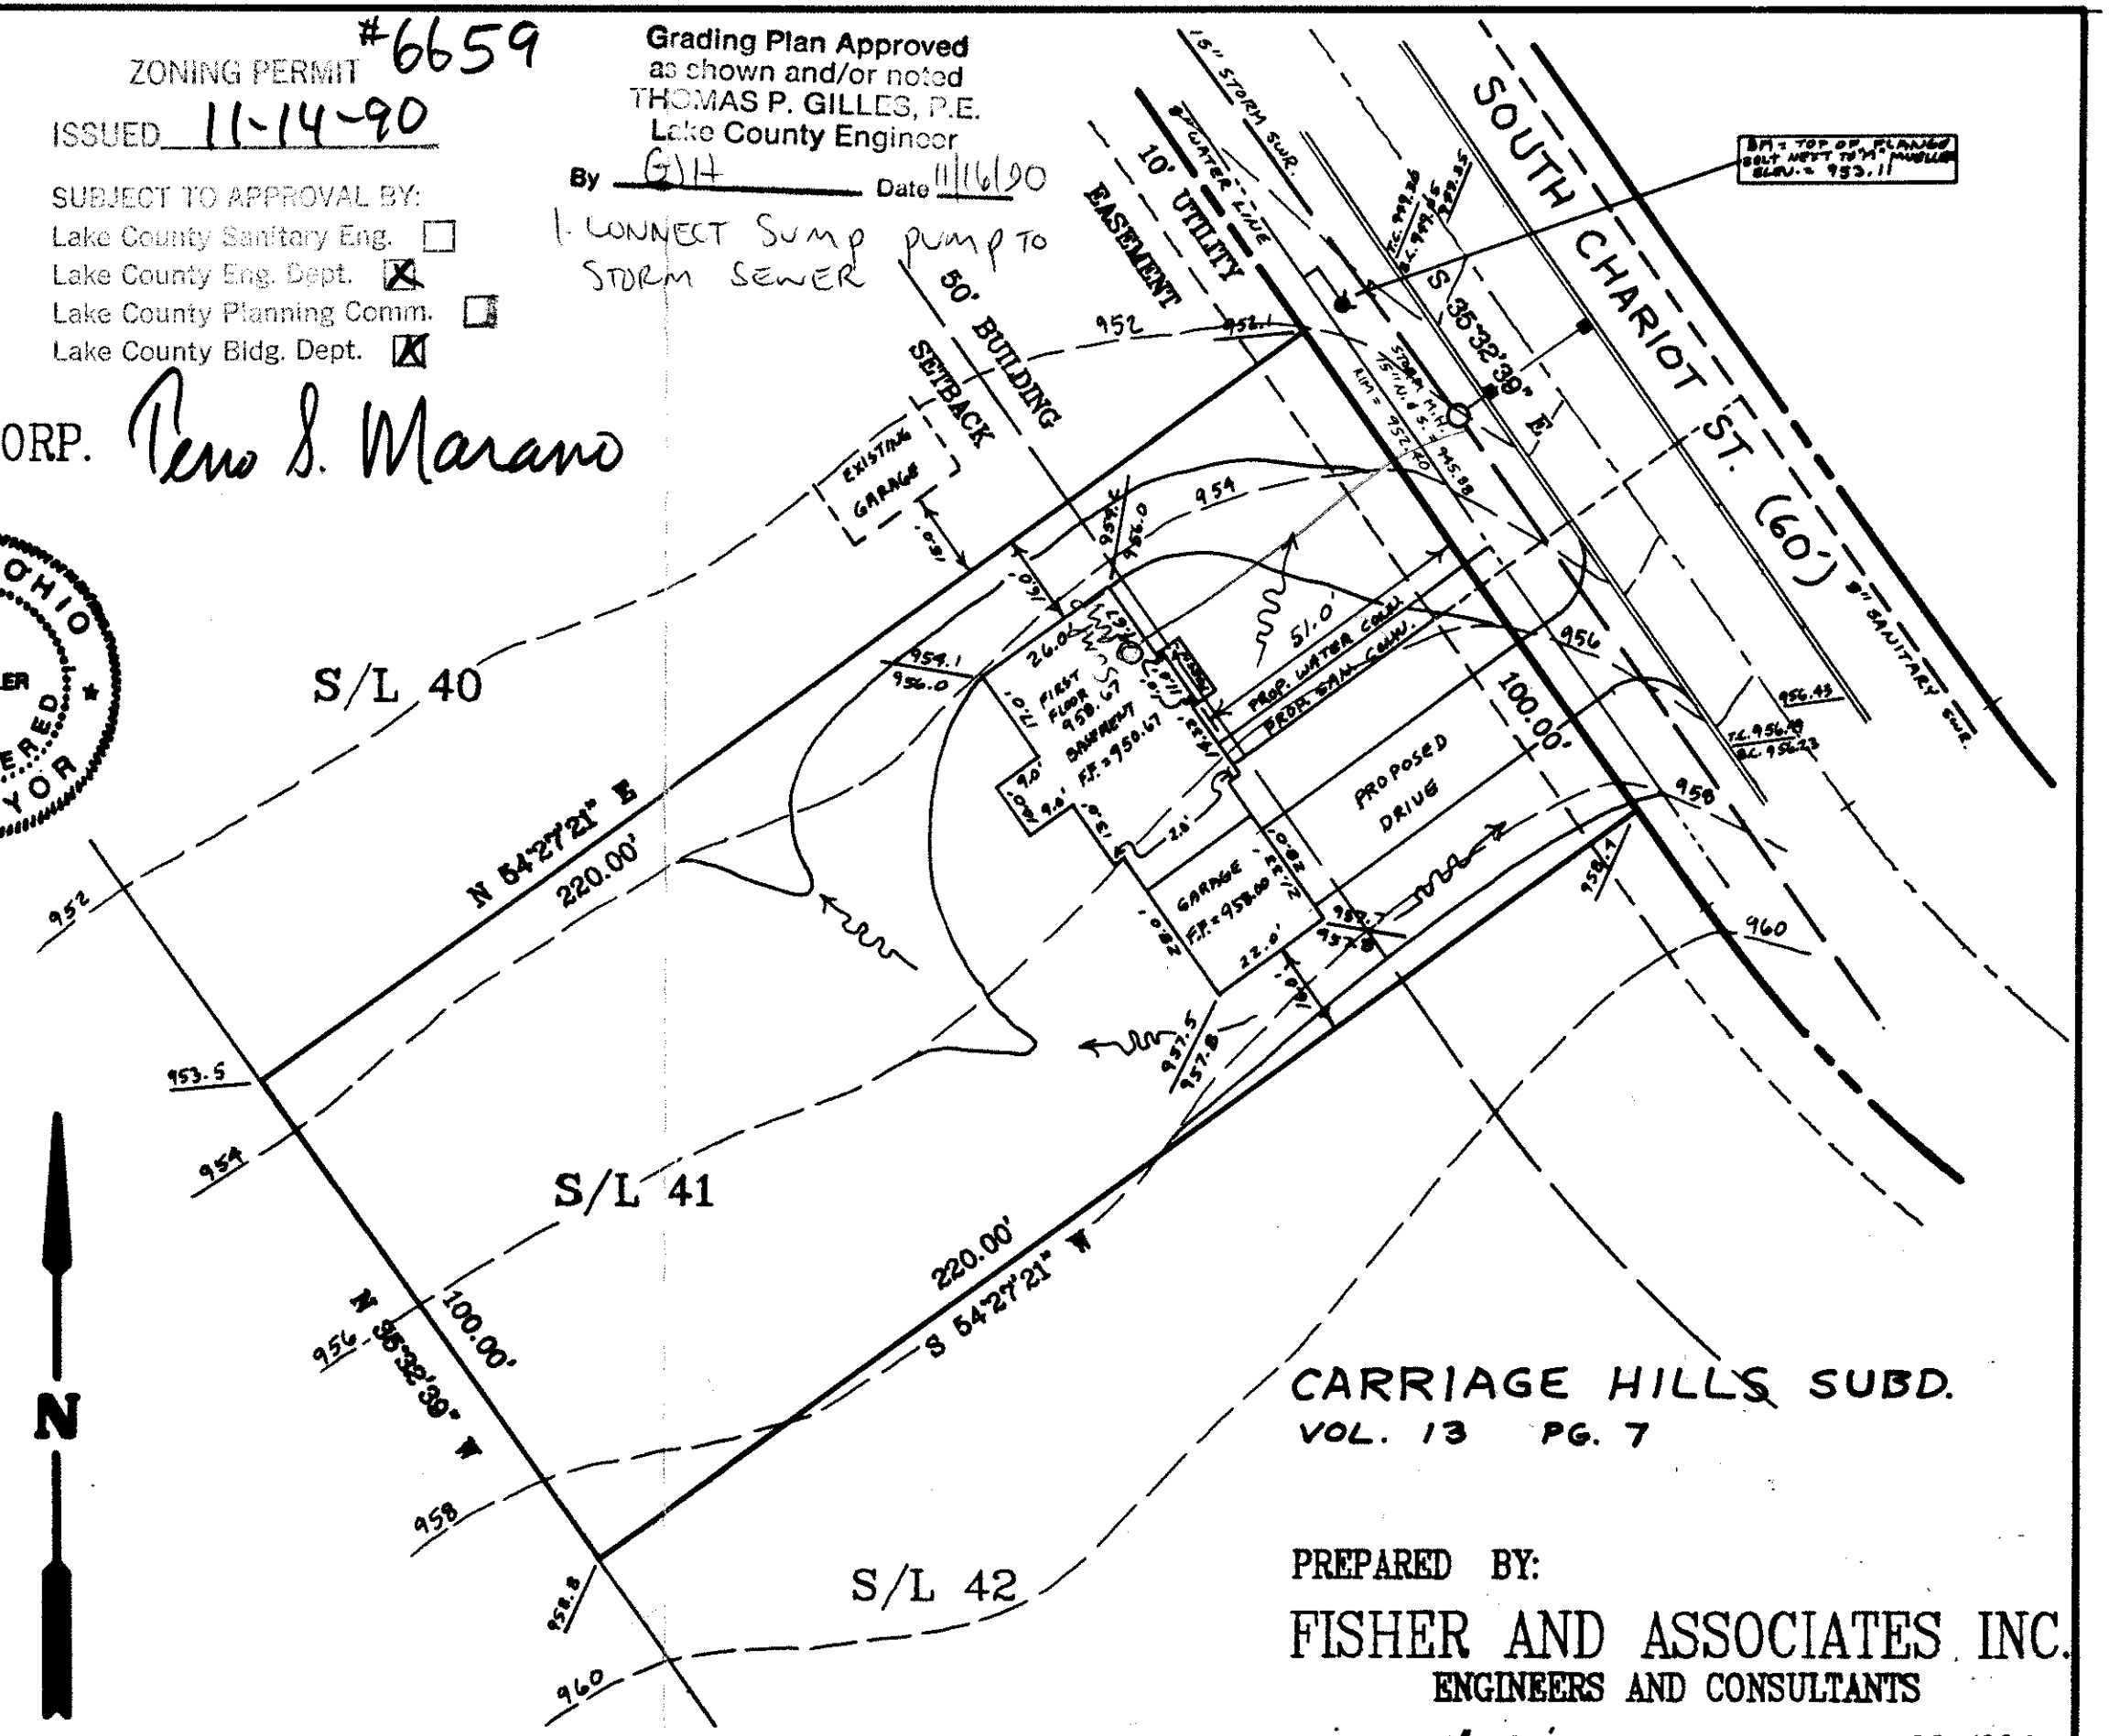

CARRIAGE HILLS SUBD.
VOL. 13 PG. 7

PREPARED BY:

FISHER AND ASSOCIATES INC.
ENGINEERS AND CONSULTANTS

SCALE: 1" = 30' DATE: NOVEMBER, 1990

LEGEND

SANITARY MANHOLE	●
STORM MANHOLE	○
INLET OR CATCH BASIN	■
HYDRANT	
EXISTING CONTOUR	— — —
PROPOSED CONTOUR	———
EXIST. ELEV. 100.0 / 100.0 PROP. ELEV.	
AS BUILT ELEVATION	
DIRECTION OF DRAINAGE	