SITE PLAN

PREPARED FOR:
MR. CHUCK BUCHTEL
S/L 20 SOUTHMEADOW DR.
CONCORD TOWNSHIP, OHIO

SCALE: 1"=30'

← EXISTING GRADES
PROPOSED GRADES

PREPARED BY:
LAKE INC ENGINEERS & SURVEYORS
30575 EUCLID AVENUE
WICKLIFFE, OHIO
APRIL 1978

Grading Plan Approved
as shown and/or noted
THOMAS P. GILLES, P.E.
Lake County Engineer
By _____ Date 5/17/78

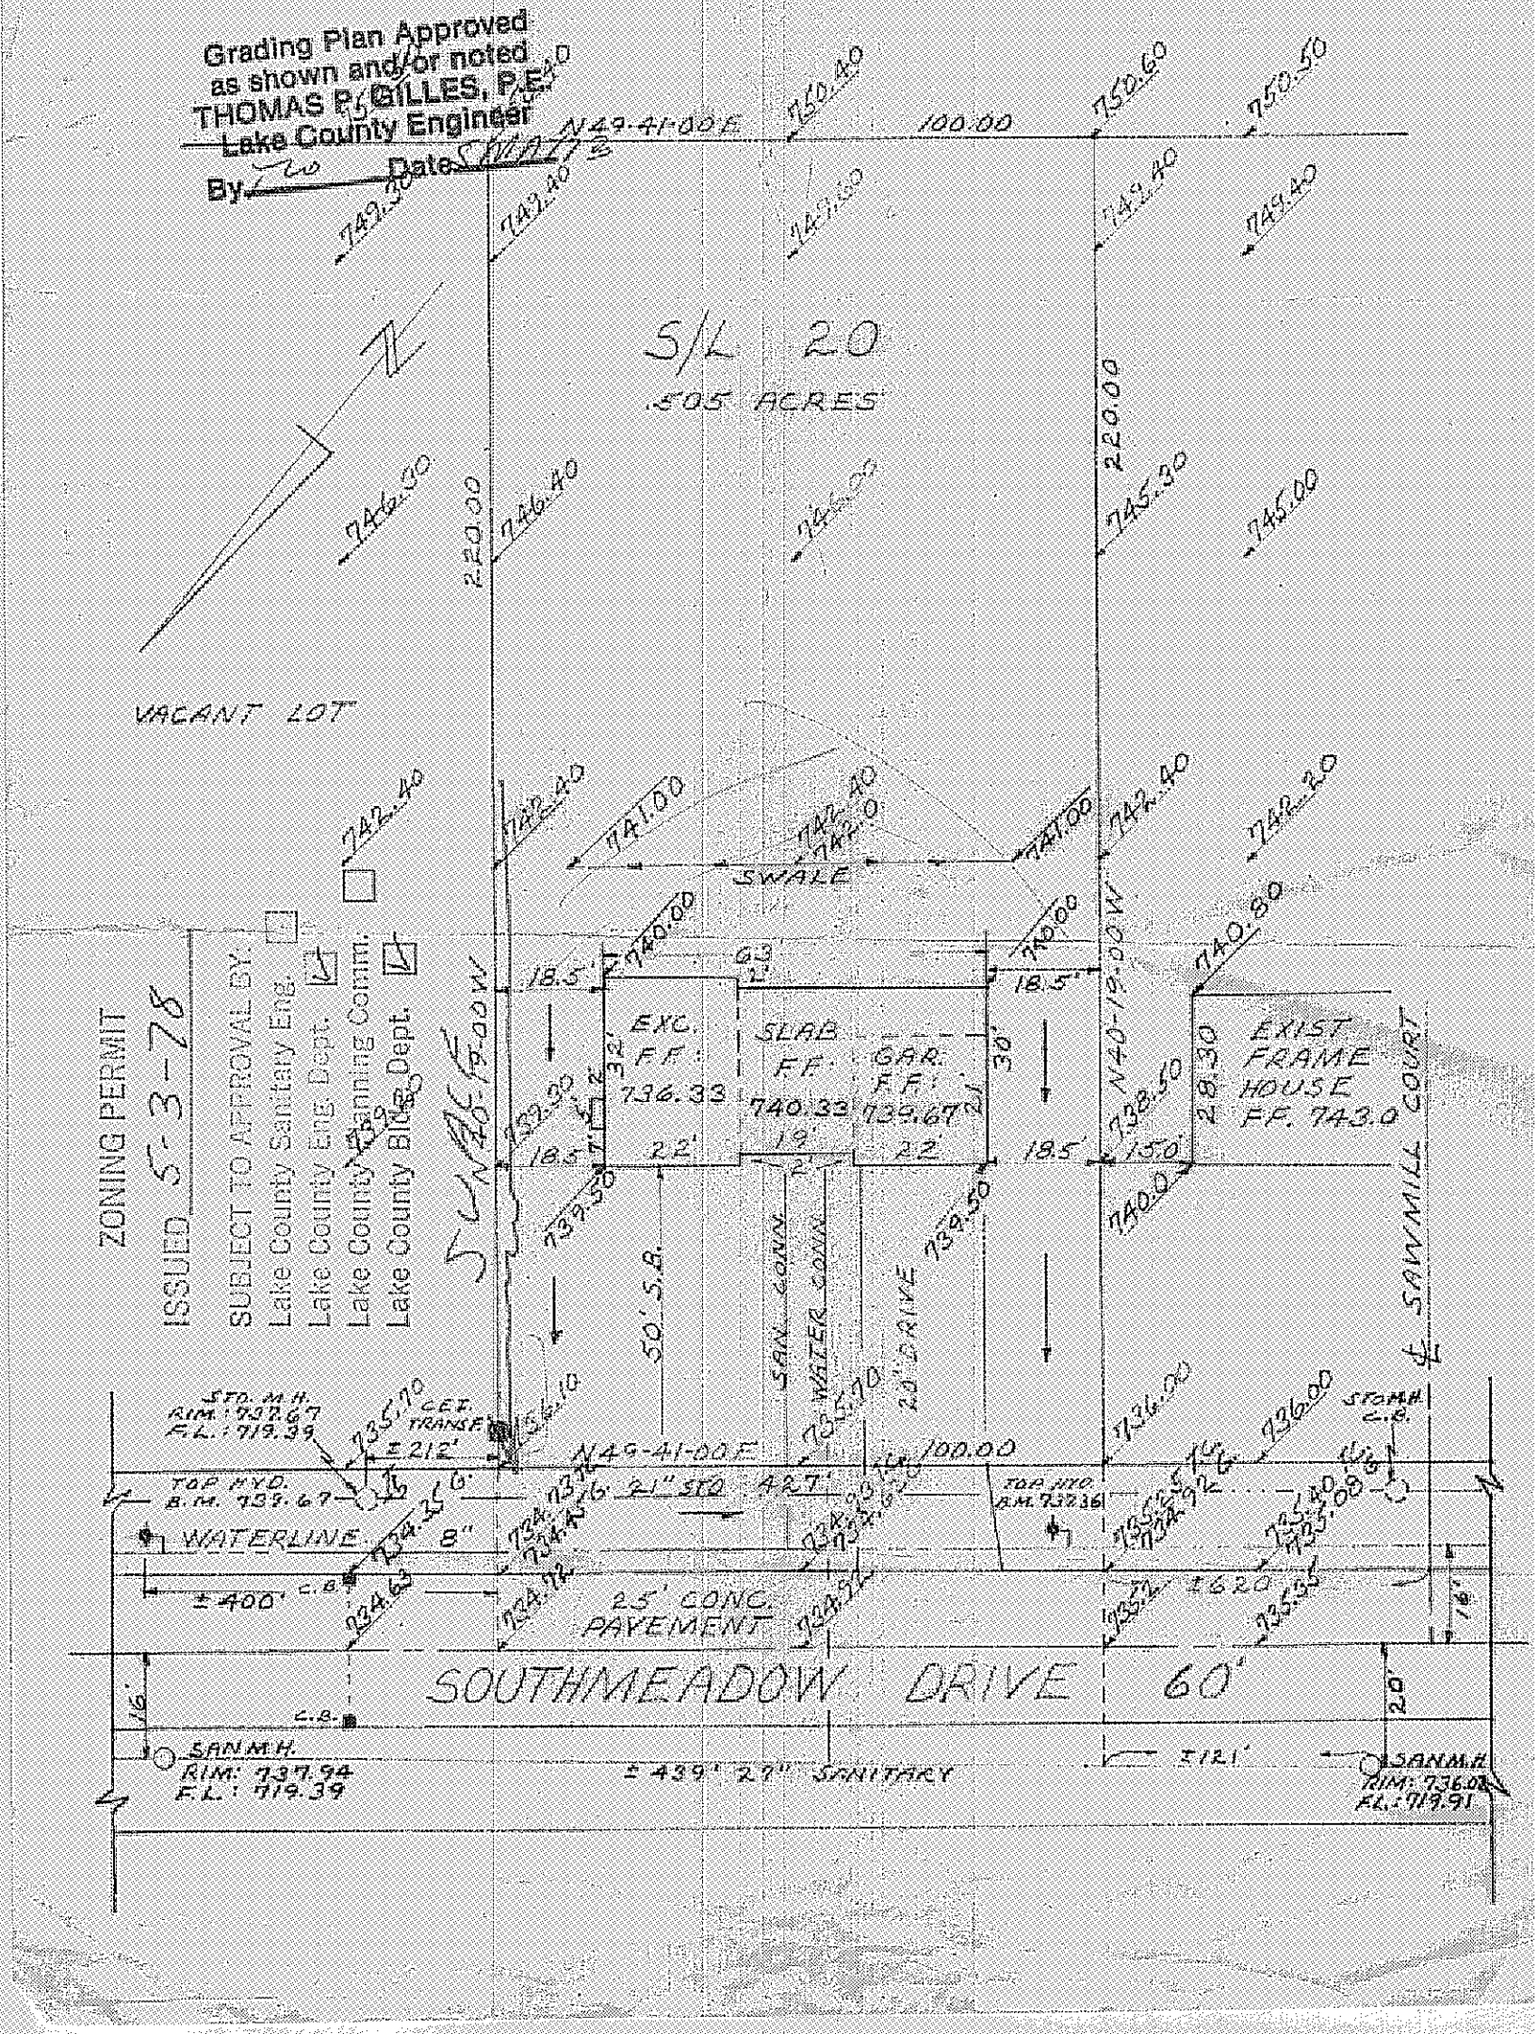

ZONING PERMIT
ISSUED 5-3-78

SUBJECT TO APPROVAL BY:
Lake County Sanitary Eng. ☐
Lake County Eng. Dept. ☑
Lake County Planning Comm. ☑
Lake County Bldg. Dept. ☑