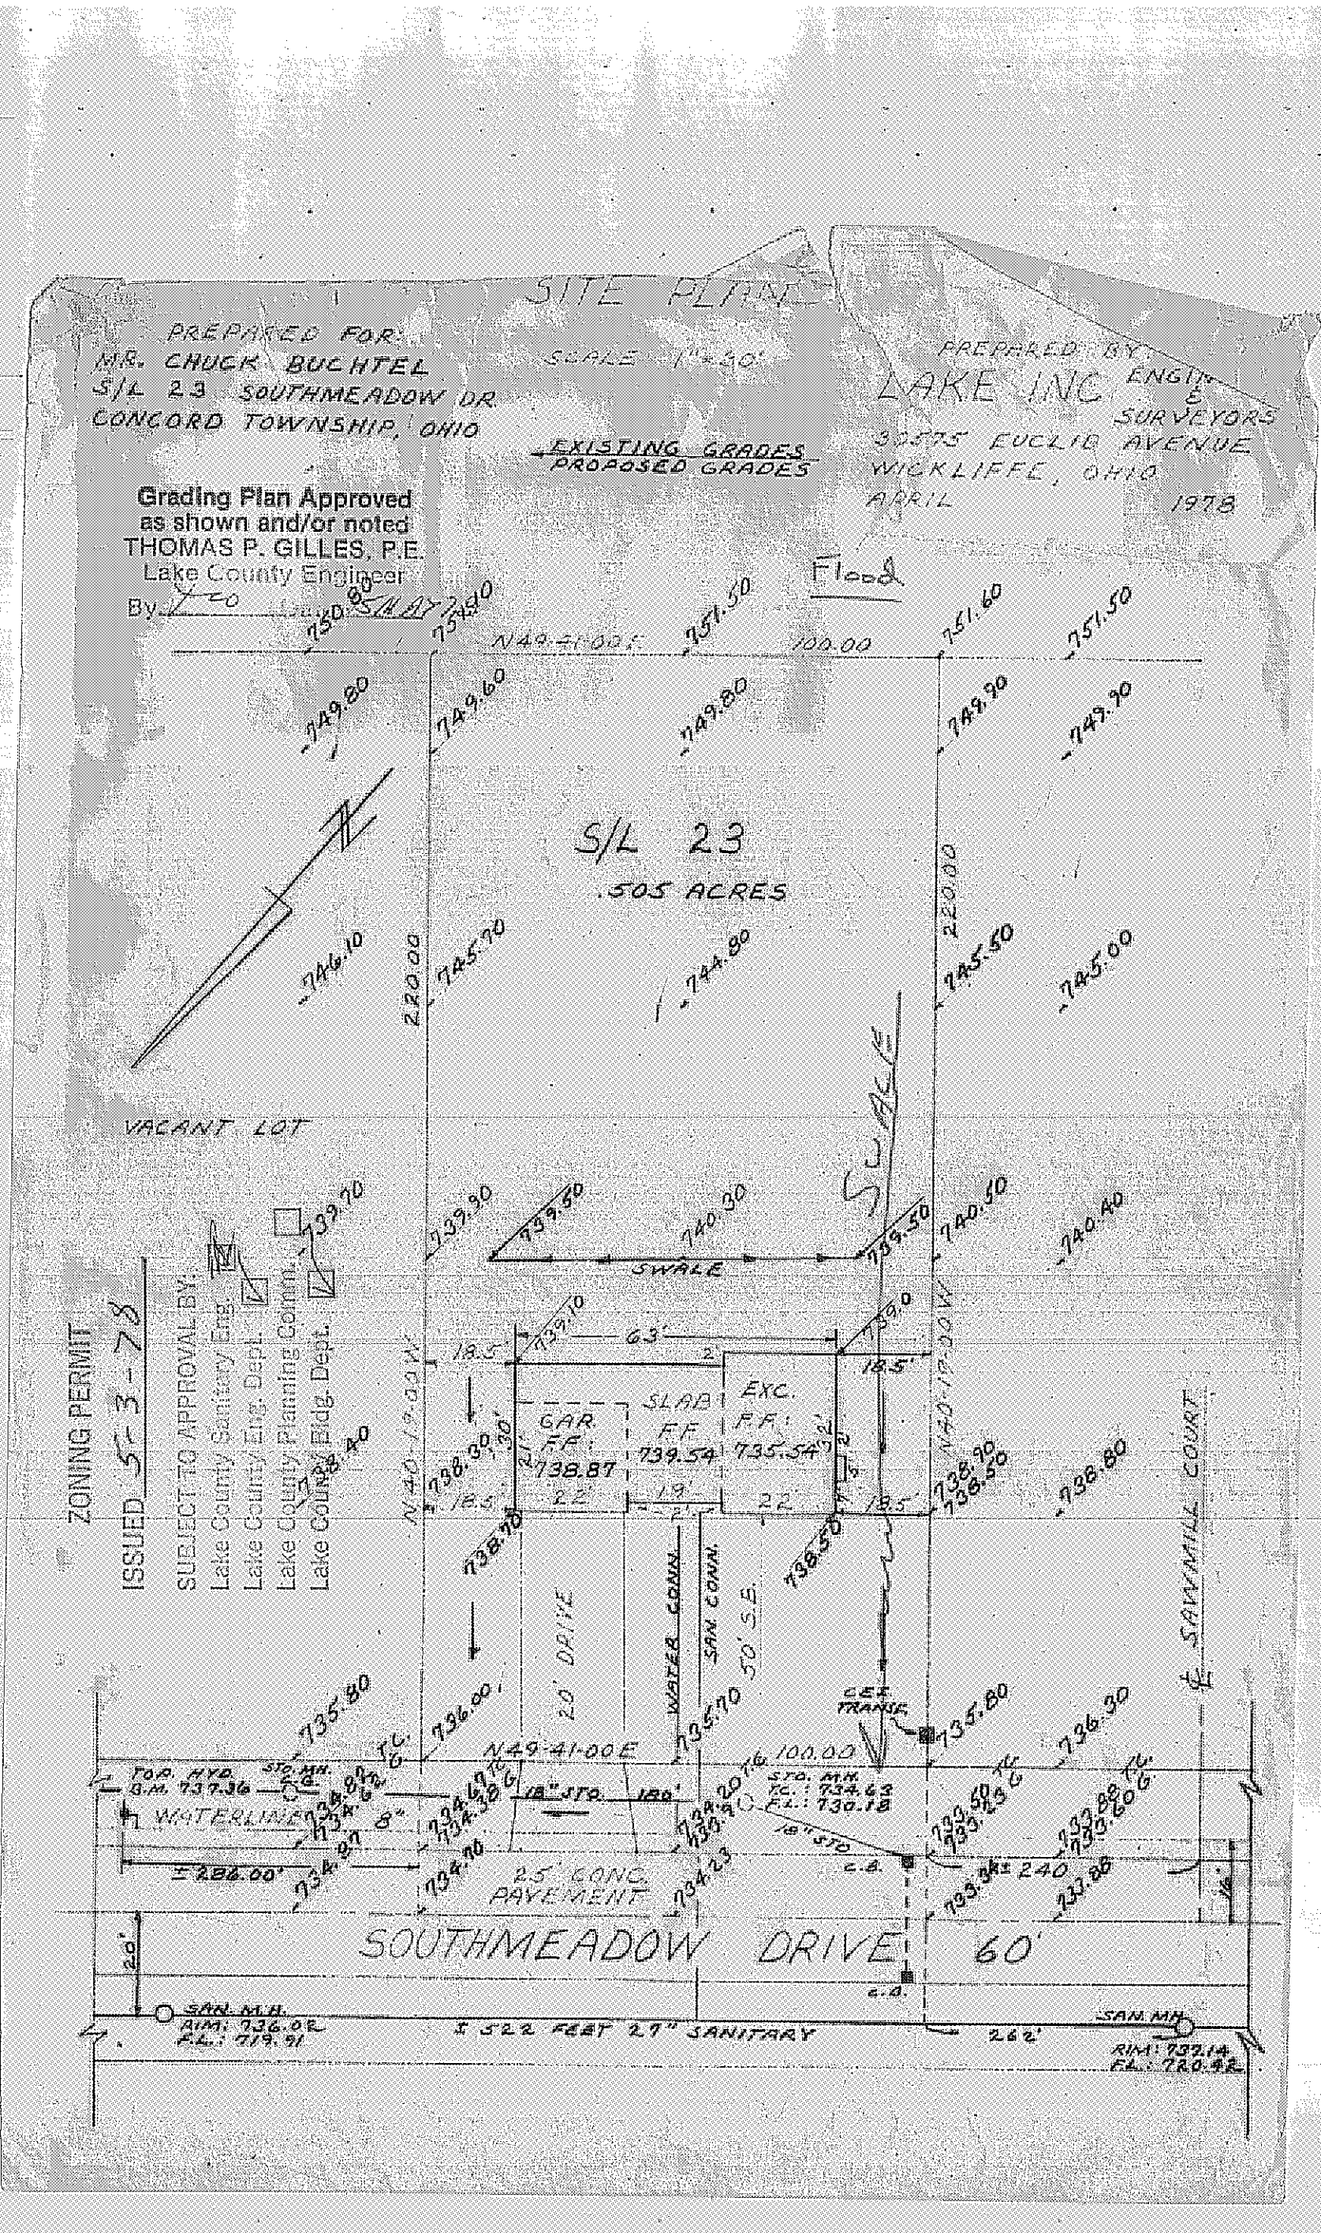
SITE PLAN
SCALE 1"=40'
PREPARED FOR:
MR. CHUCK BUCHTEL
S/L 23 SOUTHMEADOW DR.
CONCORD TOWNSHIP, OHIO
EXISTING GRADES
PROPOSED GRADES
PREPARED BY:
LAKE INC. ENGR. & SURVEYORS
30375 EUCLID AVENUE
WICKLIFFE, OHIO
APRIL 1978
Grading Plan Approved
as shown and/or noted
THOMAS P. GILLES, P.E.
Lake County Engineer
By
Flood
S/L 23
.505 ACRES
VACANT LOT
SWALE
SLAB
EXC. F.F. 735.54
GAR. F.F. 738.87
N49-41-00E 100.00
N40-19-00W 220.00
S49-41-00W 100.00
S40-19-00E 220.00
SAWMILL COURT
20' DRIVE
WATER CONN.
SAN CONN.
50' S.E.
CSE FRANCE
WATERLINE
± 286.00'
2.5" CONC. PAVEMENT
SOUTHMEADOW DRIVE 60'
18" STD. 180'
18" STD.
SAN M.H. RIM: 736.08 FL.: 719.91
± 522 FEET 27" SANITARY
SAN M.H. RIM: 737.14 FL.: 720.92
262'
ZONING PERMIT
ISSUED SF 3-78
SUBJECT TO APPROVAL BY:
Lake County Sanitary Eng.
Lake County Eng. Dept.
Lake County Planning Comm.
Lake County Bldg. Dept.