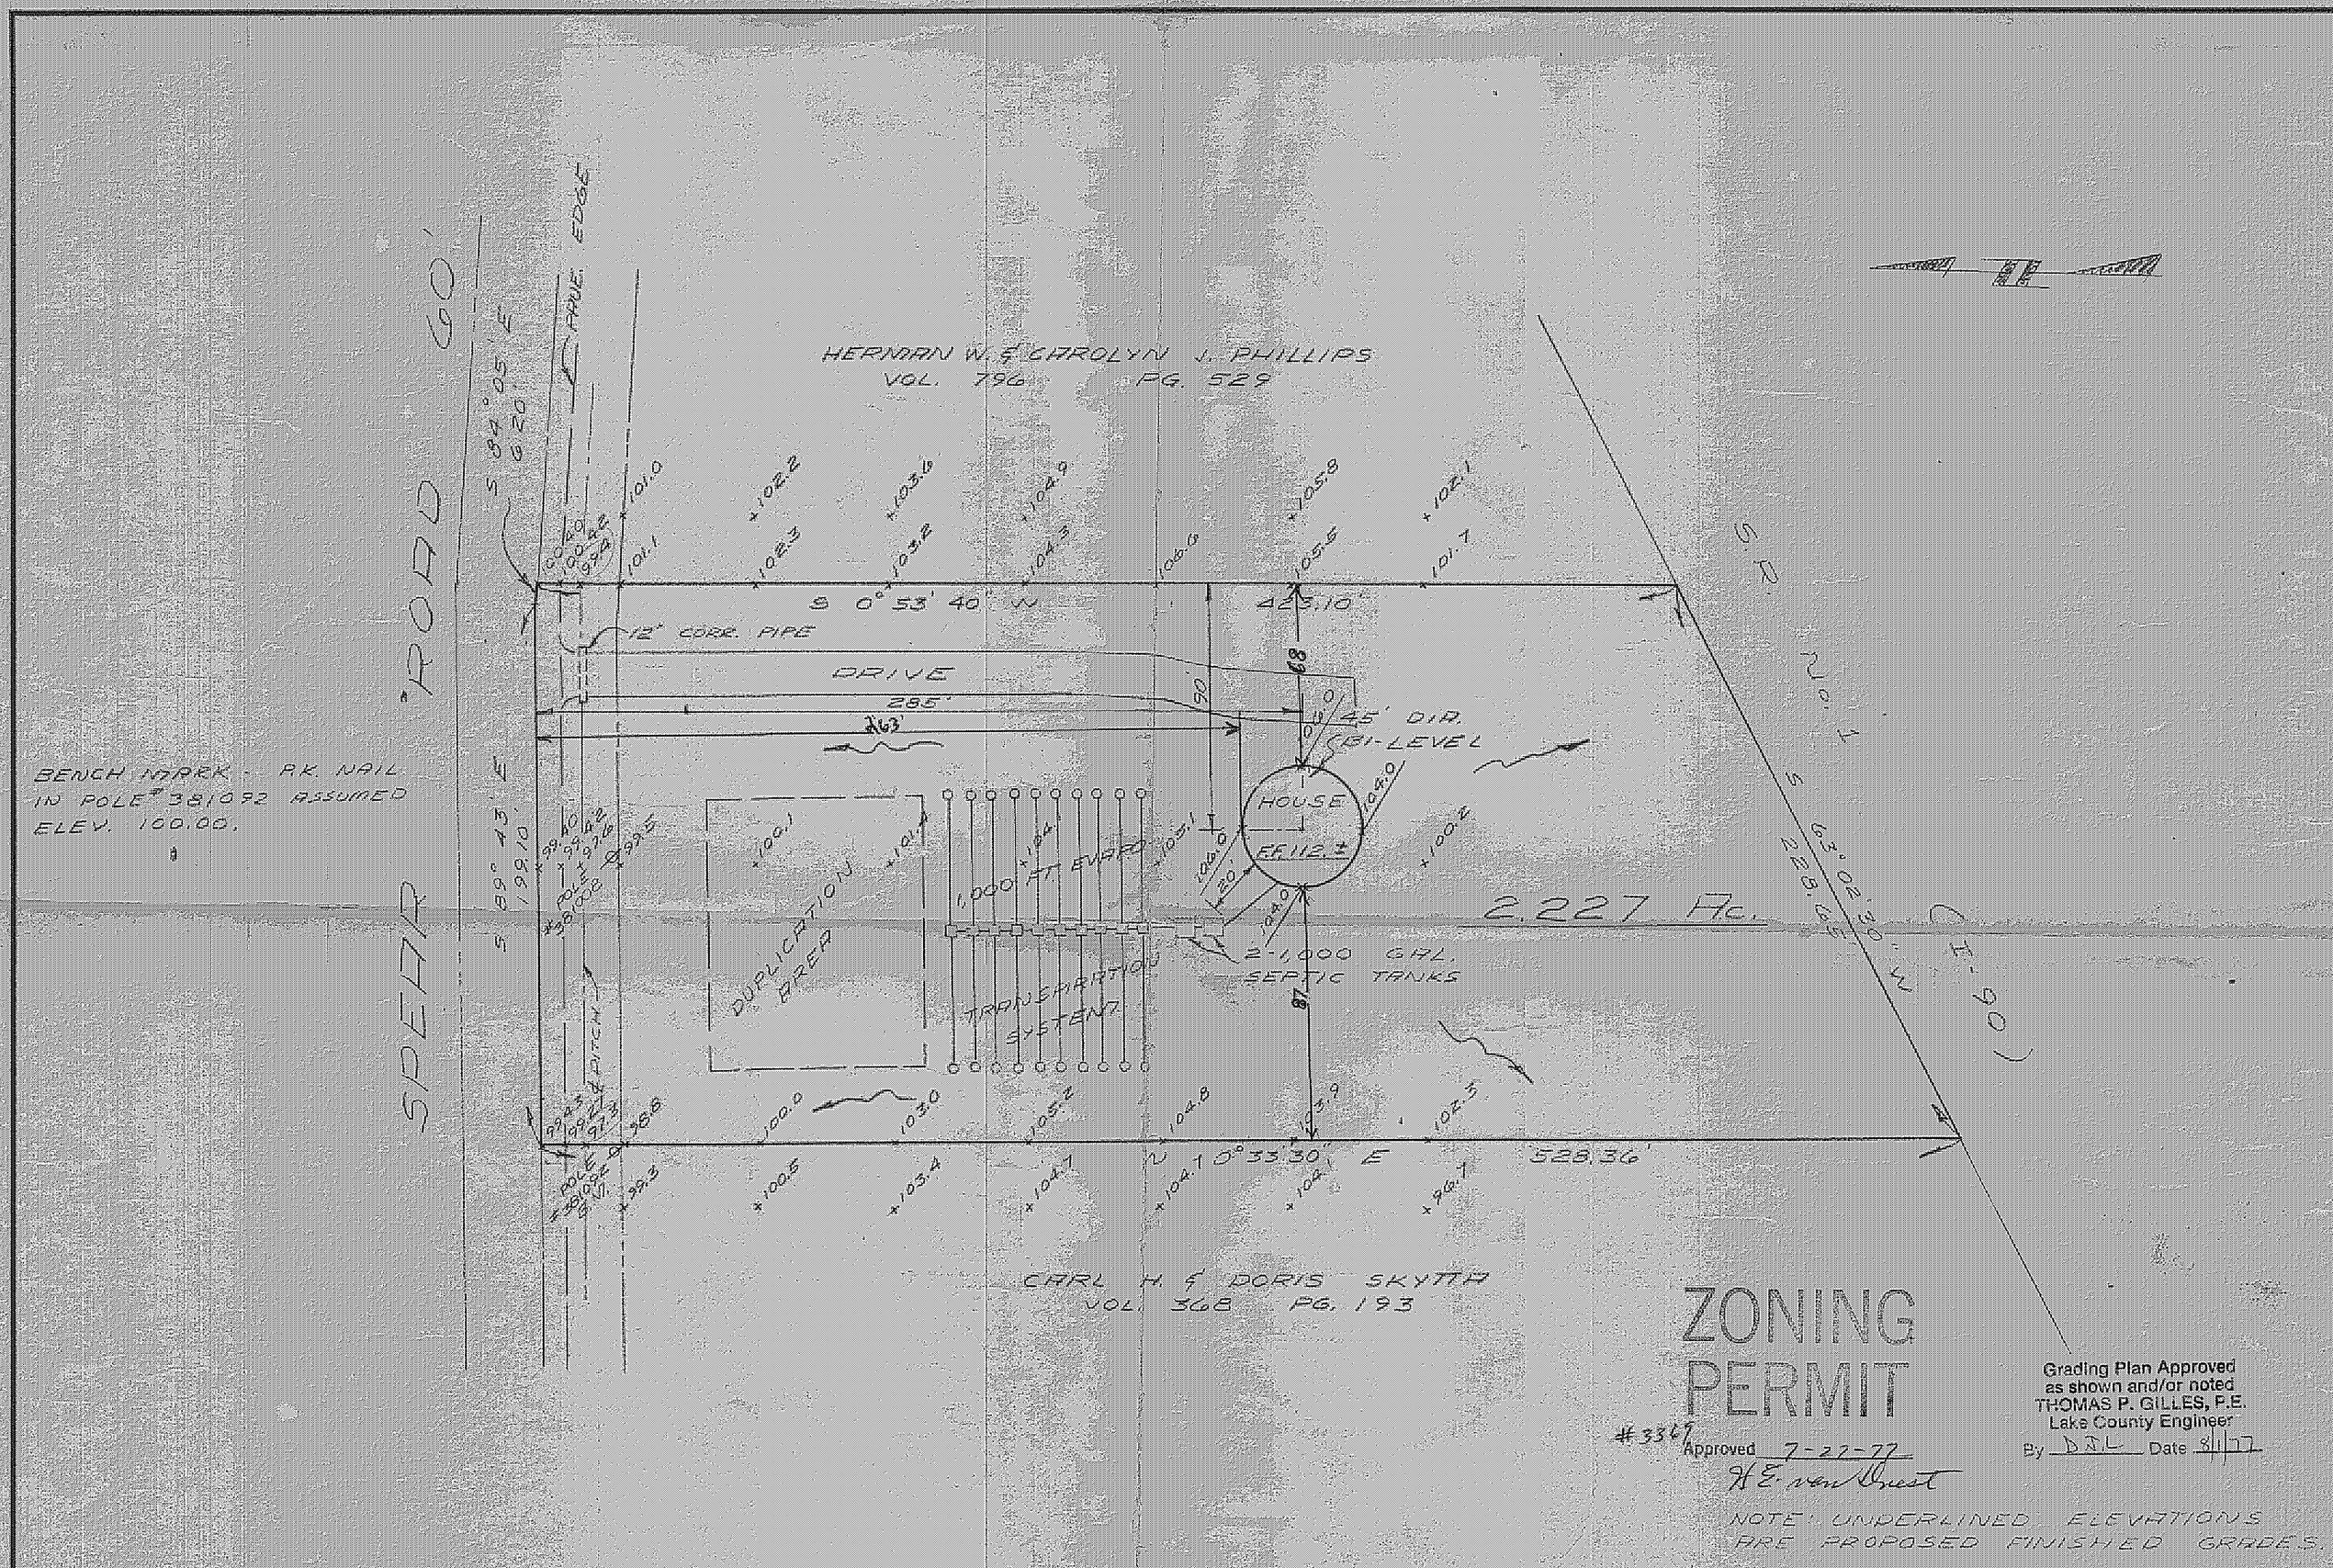

ZONING PERMIT

#3367 Approved 7-27-77

H. E. van Ornest

Grading Plan Approved as shown and/or noted
THOMAS P. GILLES, P.E.
Lake County Engineer
By D.J.L. Date 8/1/77

NOTE: UNDERLINED ELEVATIONS ARE PROPOSED FINISHED GRADES.

"DESIGN CERTIFICATION"
THIS PLAT WAS PREPARED BY ME AND IS CORRECT TO THE BEST OF MY KNOWLEDGE AND BELIEF.

REG. SURVEYOR No. 4785

"AS BUILT" CERTIFICATION
I, HEREBY CERTIFY THAT THE CIRCLED GRADES ARE EXISTING FINISH GRADES CHECKED IN FIELD ON _____ 19__.
SURVEY IS CORRECT TO THE BEST OF MY KNOWLEDGE & BELIEF.

REG. SURVEYOR No.

SITE PLAN
FOR
MICHAEL HASELOW
PART OF LOT 8, TRACT 3, CONCORD TWP., LAKE COUNTY, OHIO

DATE JUN 76
SCALE 1"=40'
DRAWN BY
CH'K'D BY
F.B.# 388 PG. 54

Colpetzer • Woods Consultants, Inc.
CONSULTING ENGINEERS AND SURVEYORS
PAINESVILLE, OHIO 44077

SHEET
CONTRACT No. 76140